
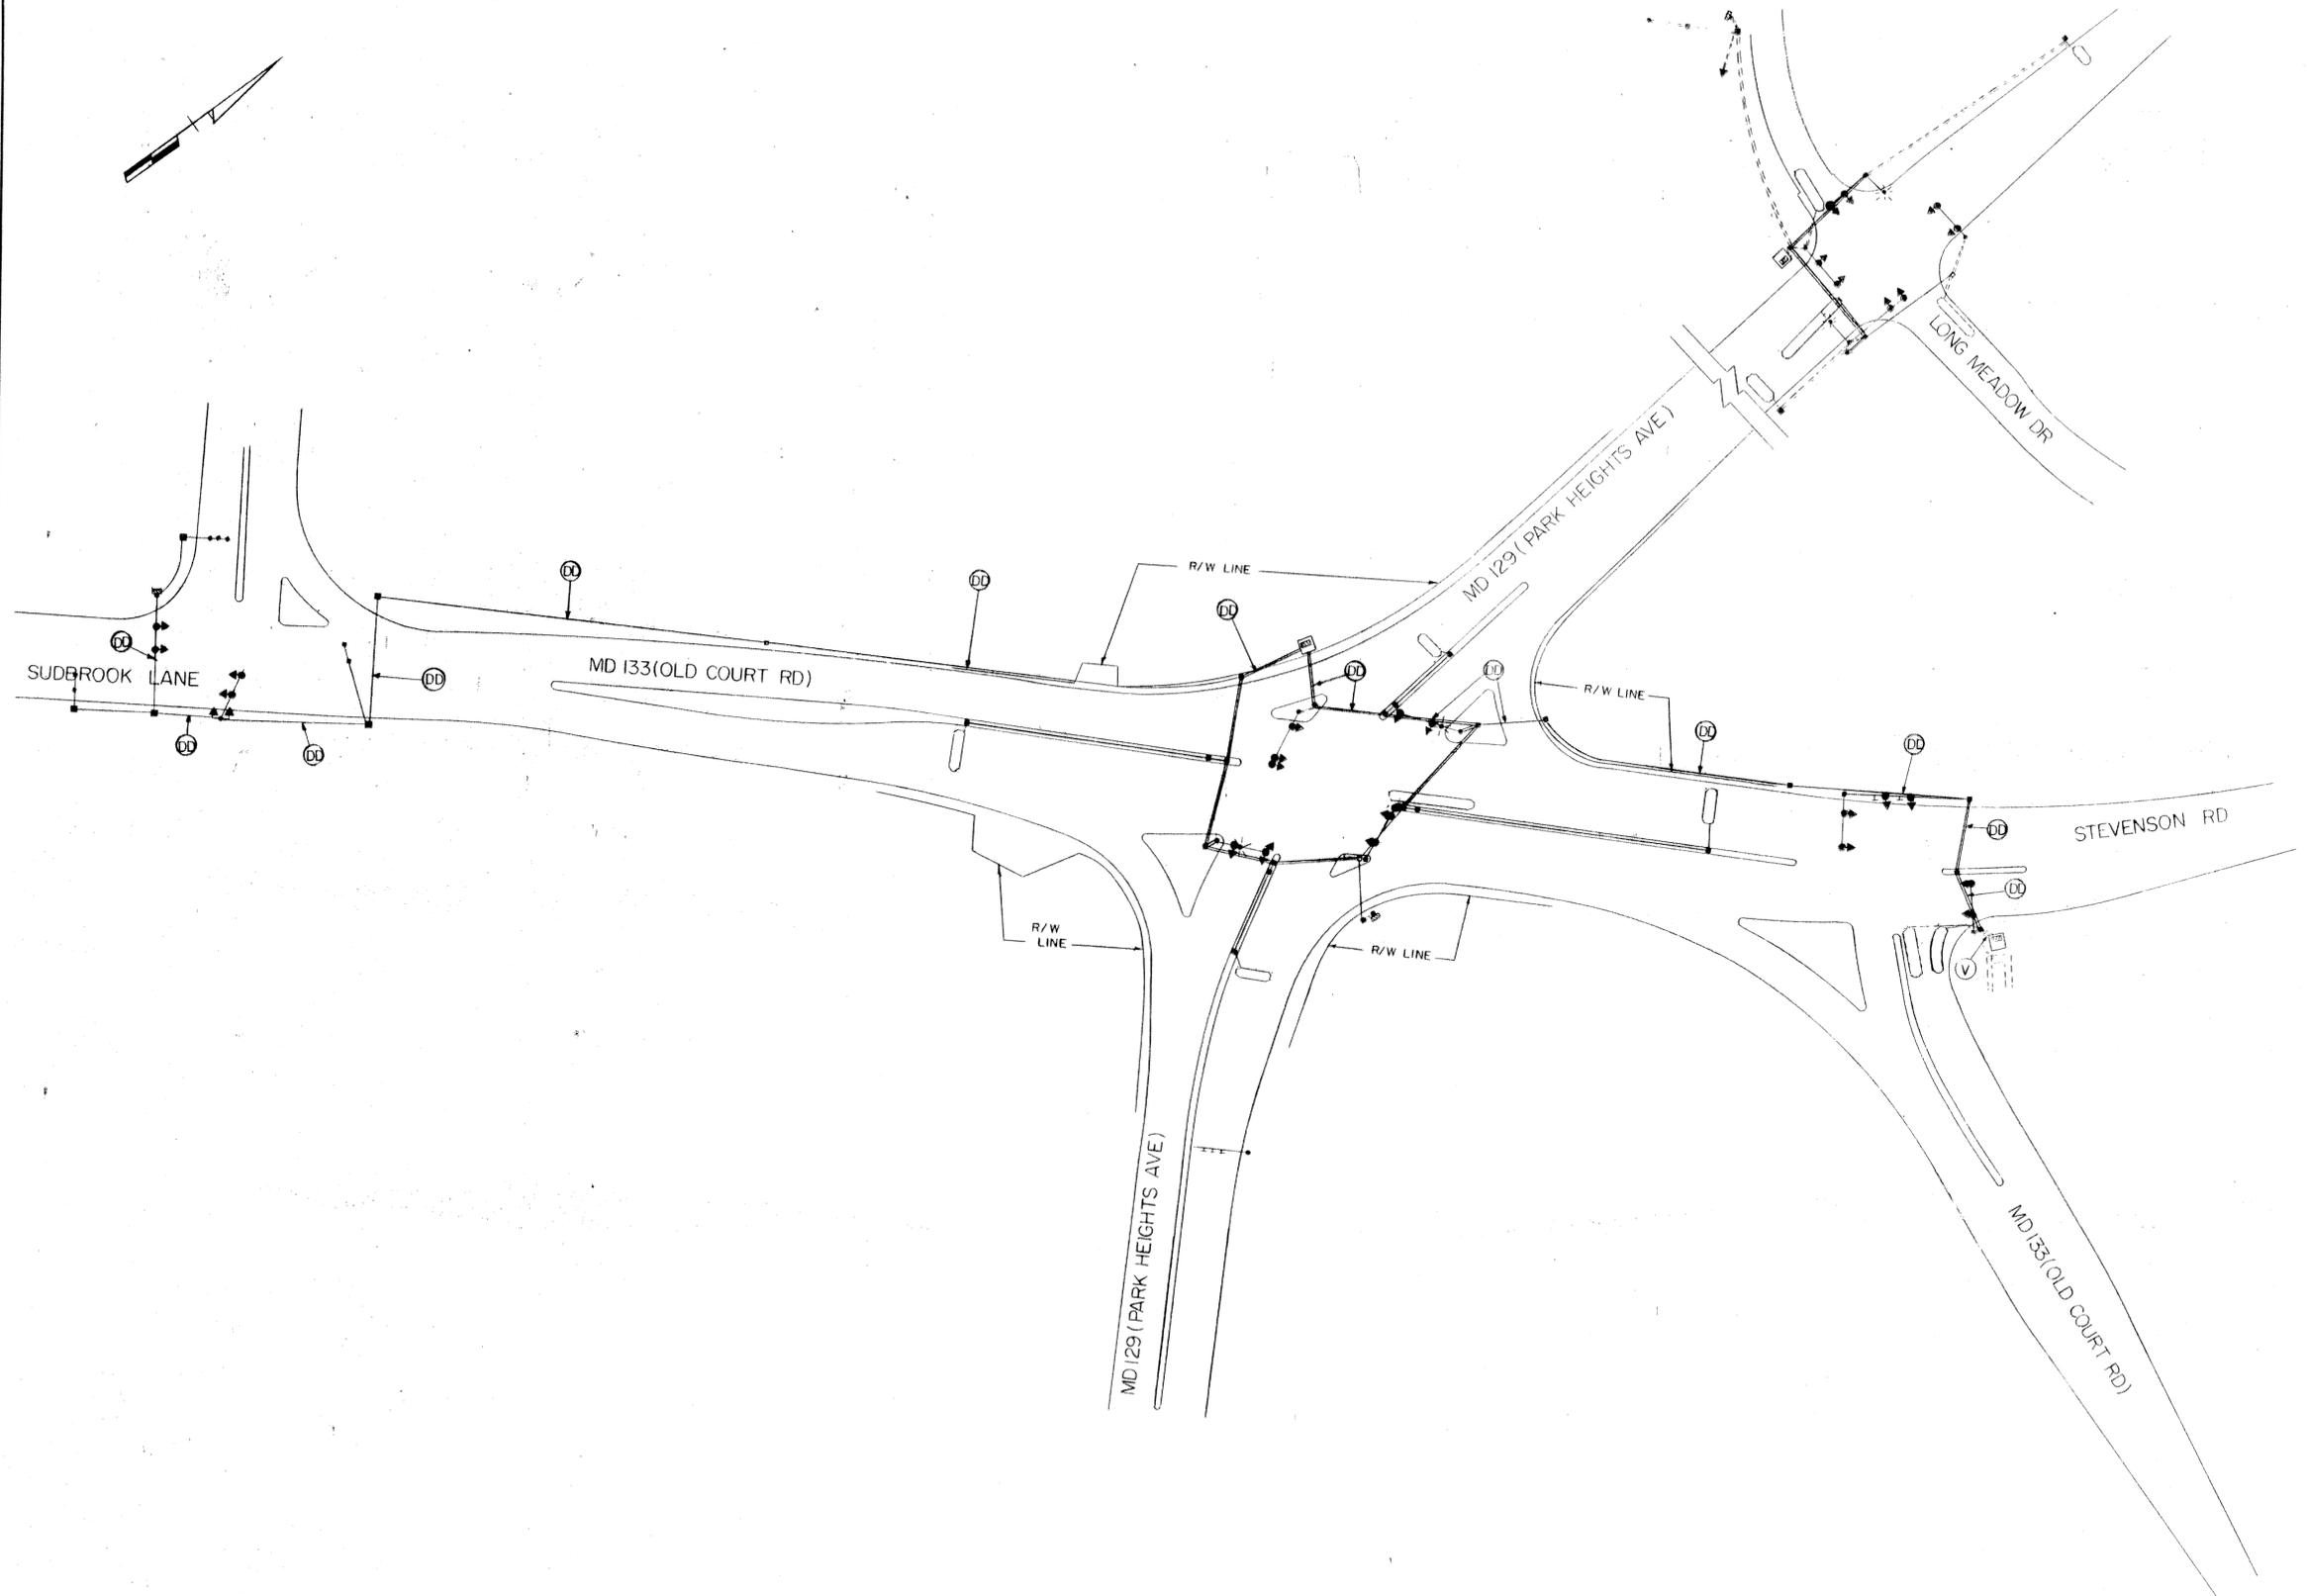


F.H.W.A. REGION NO.	STATE	FED. AID PROJ. NO.	SHEET NO.	TOTAL SHEETS
3	MD.			

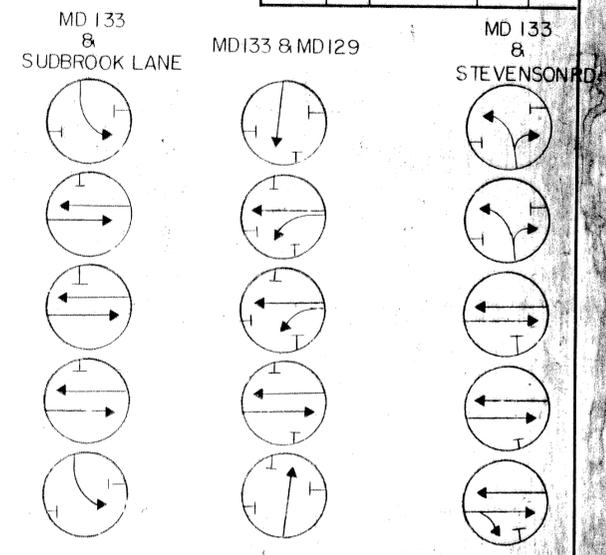

APPROVAL: *Lawrence E. Edgard*
REGIONAL TRAFFIC ENGINEER 1/23/74

APPROVAL: _____
CHIEF-BUREAU OF TRAFFIC ENGINEERING

APPROVAL: *Philip R. Miller*
ASST. CHIEF ENGINEER TRAFFIC 1/23/74

IO-31-74
ASBUILT
B-283X-465
REVISIONS

STATE OF MARYLAND
DEPARTMENT OF TRANSPORTATION
STATE HIGHWAY ADMINISTRATION

TRAFFIC DIVISION - BUREAU OF TRAFFIC ENGINEERING

MD 133 & MD 129 & STEVENSON RD.
TO SADBROOK LANE

SCALE 1"=50' DATE 1-4-74 CONTRACT NO.

DRAWN BY: WM M LINARDI COUNTY: BALTIMORE

DESIGNED BY: *Lawrence E. Edgard* SIGNAL NO.:

CHECKED BY: _____ DRAWING NO. TS-158A

03013300.07