

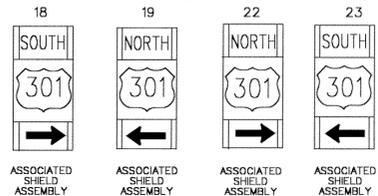


US 301 IS ASSUMED TO RUN IN A NORTH-SOUTH DIRECTION.


14-17  
Billingsley RD  
D3-2 (DUAL FACE)  
VARIABLE x 16"

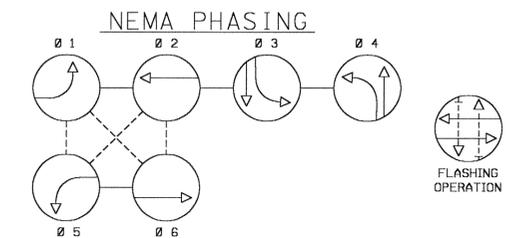

THERE IS ONE (1) HANDHOLE LOCATED WITHIN THIS BREAK, 287' WEST OF US 301 ROAD EDGE

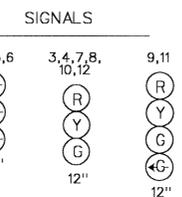

NEMA NOTES:  
1. PHASES ASSOCIATED BY A SOLID LINE WILL NOT OPERATE CONCURRENTLY.  
2. PHASES ASSOCIATED BY A DASHED LINE WILL OPERATE CONCURRENTLY.

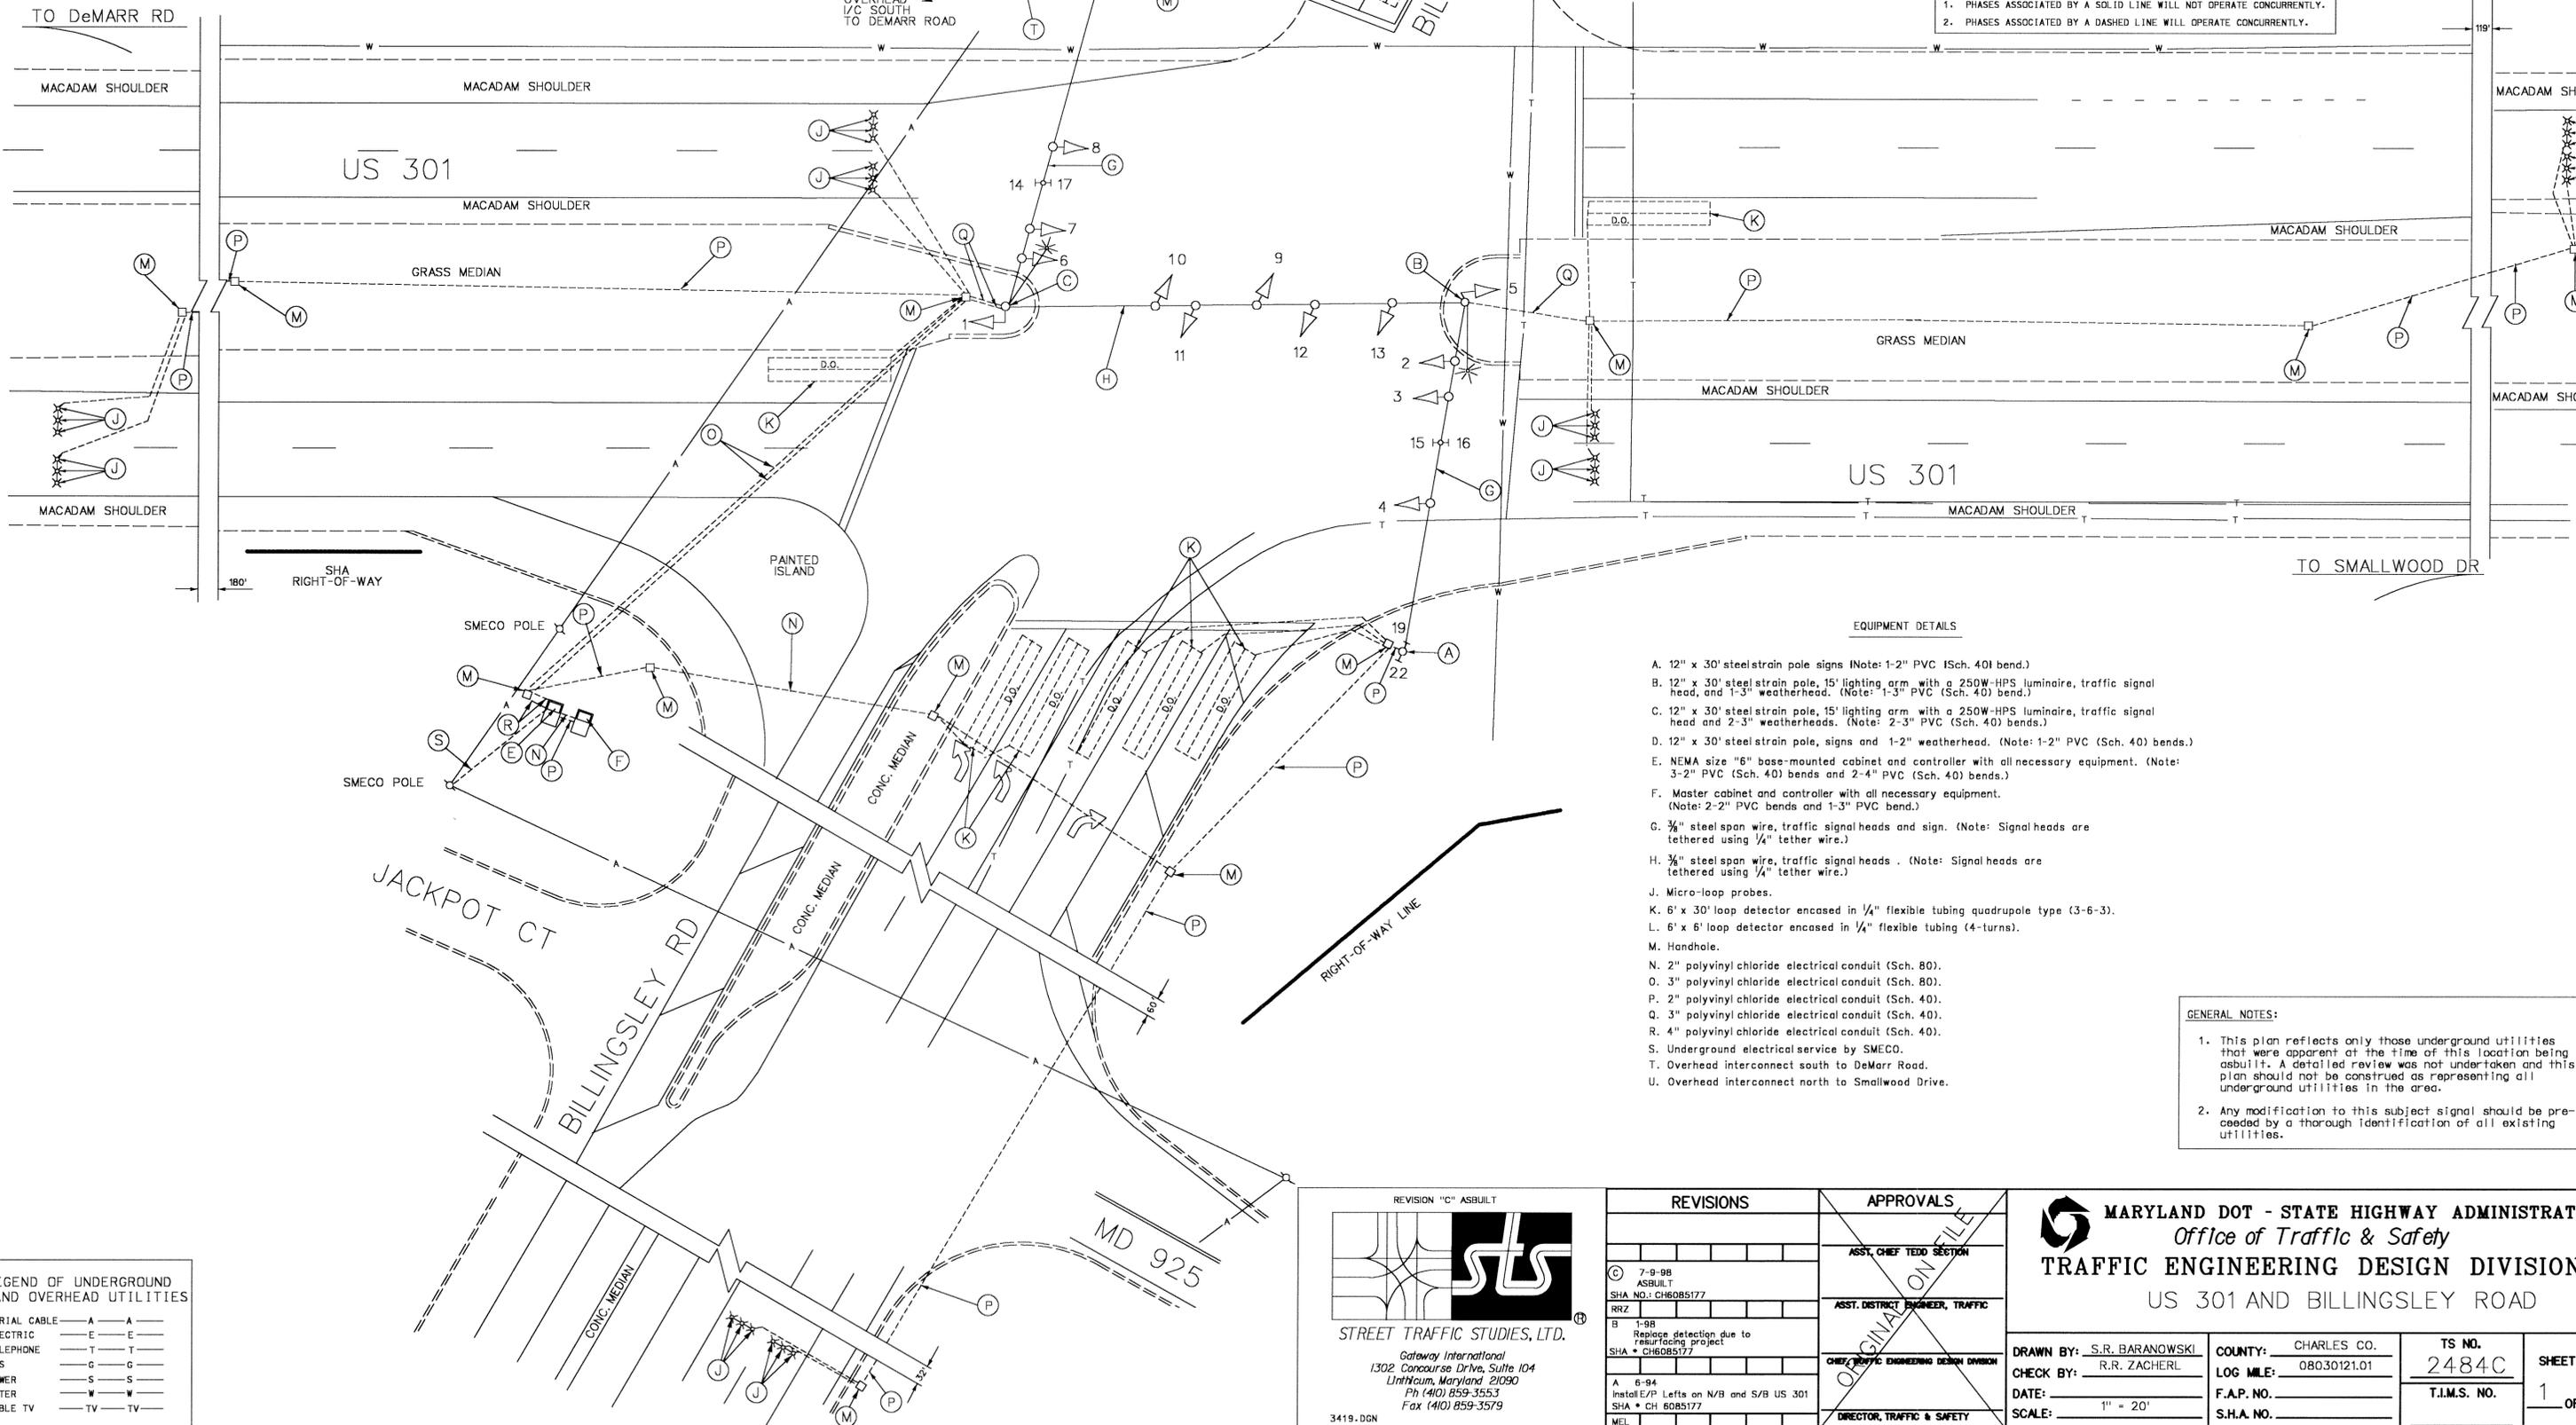

- EQUIPMENT DETAILS
- A. 12" x 30' steel strain pole signs (Note: 1-2" PVC (Sch. 40) bend.)
  - B. 12" x 30' steel strain pole, 15' lighting arm with a 250W-HPS luminaire, traffic signal head, and 1-3" weatherhead. (Note: 1-3" PVC (Sch. 40) bend.)
  - C. 12" x 30' steel strain pole, 15' lighting arm with a 250W-HPS luminaire, traffic signal head and 2-3" weatherheads. (Note: 2-3" PVC (Sch. 40) bends.)
  - D. 12" x 30' steel strain pole, signs and 1-2" weatherhead. (Note: 1-2" PVC (Sch. 40) bends.)
  - E. NEMA size "6" base-mounted cabinet and controller with all necessary equipment. (Note: 3-2" PVC (Sch. 40) bends and 2-4" PVC (Sch. 40) bends.)
  - F. Master cabinet and controller with all necessary equipment. (Note: 2-2" PVC bends and 1-3" PVC bend.)
  - G. 3/8" steel span wire, traffic signal heads and sign. (Note: Signal heads are tethered using 1/4" tether wire.)
  - H. 3/8" steel span wire, traffic signal heads. (Note: Signal heads are tethered using 1/4" tether wire.)
  - J. Micro-loop probes.
  - K. 6' x 30' loop detector encased in 1/4" flexible tubing quadrupole type (3-6-3).
  - L. 6' x 6' loop detector encased in 1/4" flexible tubing (4-turns).
  - M. Handhole.
  - N. 2" polyvinyl chloride electrical conduit (Sch. 80).
  - O. 3" polyvinyl chloride electrical conduit (Sch. 80).
  - P. 2" polyvinyl chloride electrical conduit (Sch. 40).
  - Q. 3" polyvinyl chloride electrical conduit (Sch. 40).
  - R. 4" polyvinyl chloride electrical conduit (Sch. 40).
  - S. Underground electrical service by SMECO.
  - T. Overhead interconnect south to DeMarr Road.
  - U. Overhead interconnect north to Smallwood Drive.

GENERAL NOTES:  
1. This plan reflects only those underground utilities that were apparent at the time of this location being asbuilt. A detailed review was not undertaken and this plan should not be construed as representing all underground utilities in the area.  
2. Any modification to this subject signal should be preceded by a thorough identification of all existing utilities.

LEGEND OF UNDERGROUND AND OVERHEAD UTILITIES

AERIAL CABLE	A	A
ELECTRIC	E	E
TELEPHONE	T	T
GAS	G	G
SEWER	S	S
WATER	W	W
CABLE TV	TV	TV

REVISION "C" ASBUILT

STREET TRAFFIC STUDIES, LTD.  
Gateway International  
1302 Concourse Drive, Suite 104  
Linthicum, Maryland 21090  
Ph (410) 859-3553  
Fax (410) 859-3579  
3419.DGN

REVISIONS	APPROVALS
© 7-9-98 ASBUILT SHA NO.: CH6085177 RRZ	ASST. CHIEF TEDD SECTION ASST. DISTRICT ENGINEER, TRAFFIC CHIEF TRAFFIC ENGINEERING DESIGN DIVISION DIRECTOR, TRAFFIC & SAFETY
B 1-98 Replace detection due to resurfacing project SHA * CH6085177	
A 6-94 Install E/P Lefts on N/B and S/B US 301 SHA * CH 6085177 MEL	

MARYLAND DOT - STATE HIGHWAY ADMINISTRATION  
Office of Traffic & Safety  
TRAFFIC ENGINEERING DESIGN DIVISION  
US 301 AND BILLINGSLEY ROAD

DRAWN BY: S.R. BARANOWSKI	COUNTY: CHARLES CO.	TS NO. 2484C	SHEET NO. 1 OF 1
CHECK BY: R.R. ZACHERL	LOG MILE: 080.30121.01	T.I.M.S. NO.	
DATE:	F.A.P. NO.		
SCALE: 1" = 20'	S.H.A. NO.		