
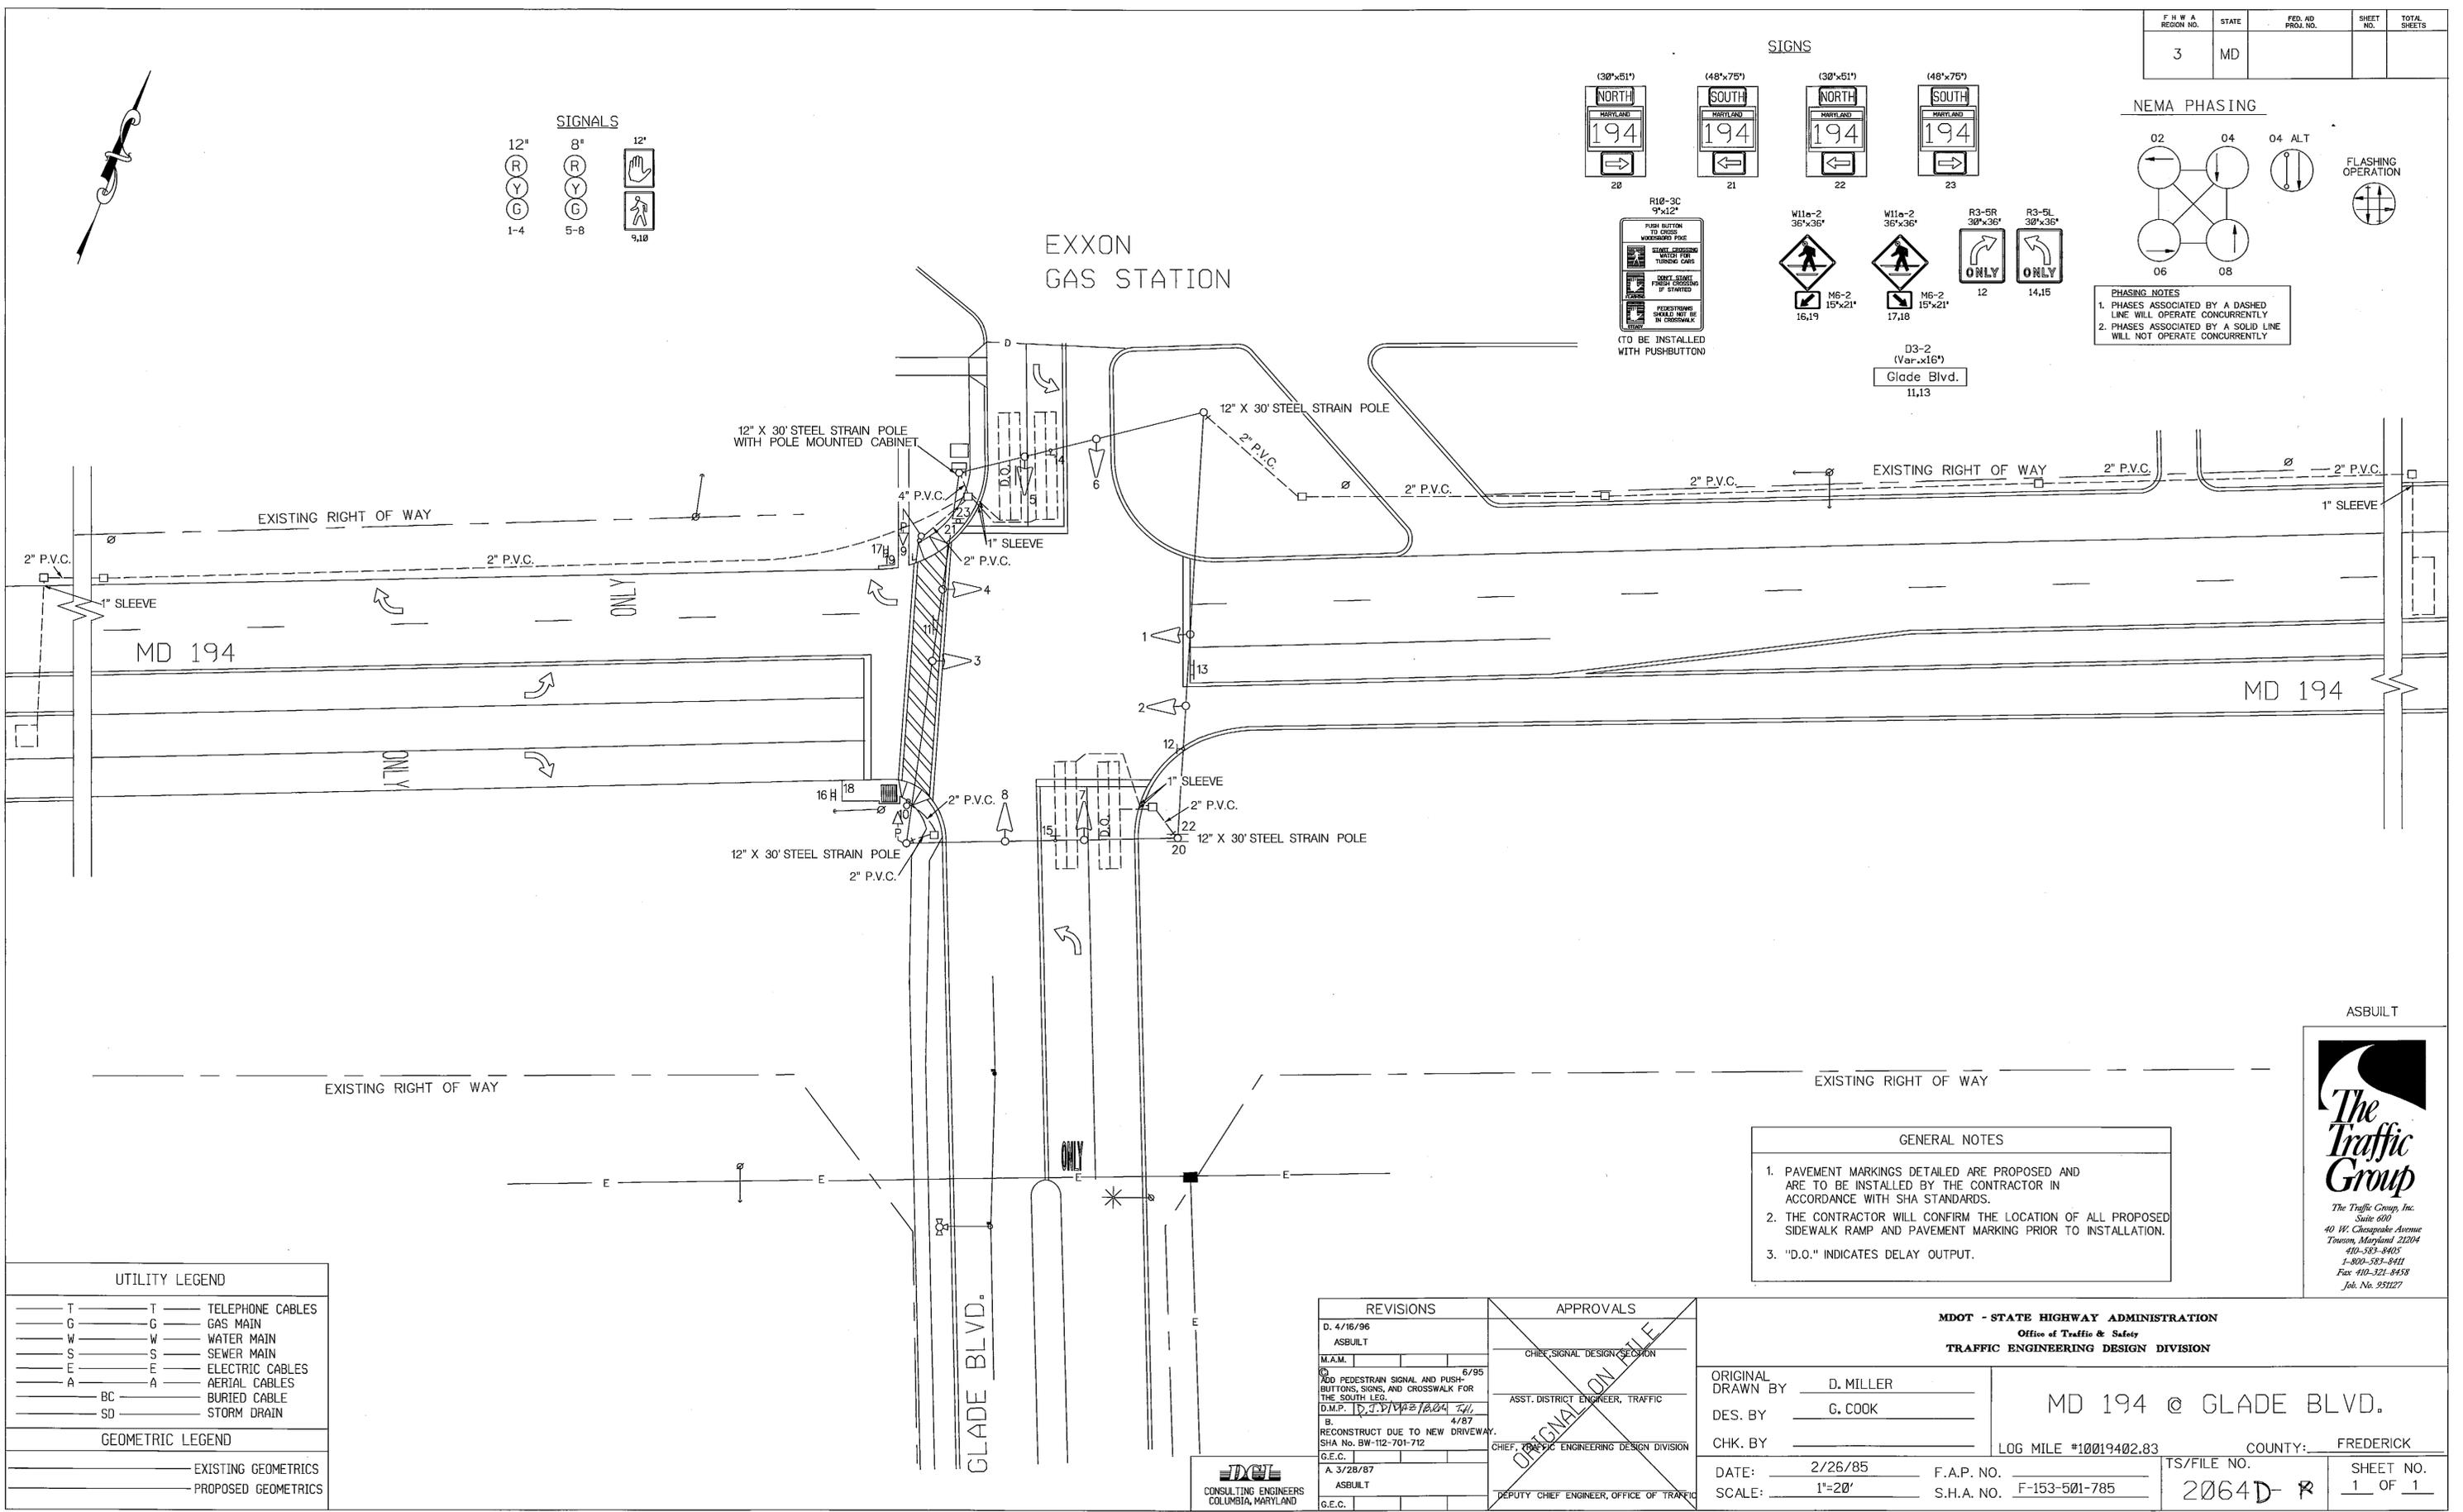
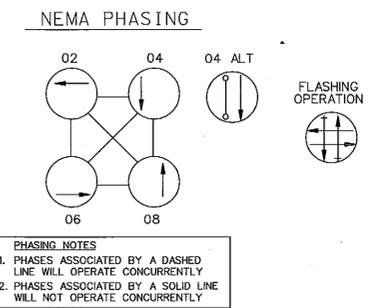
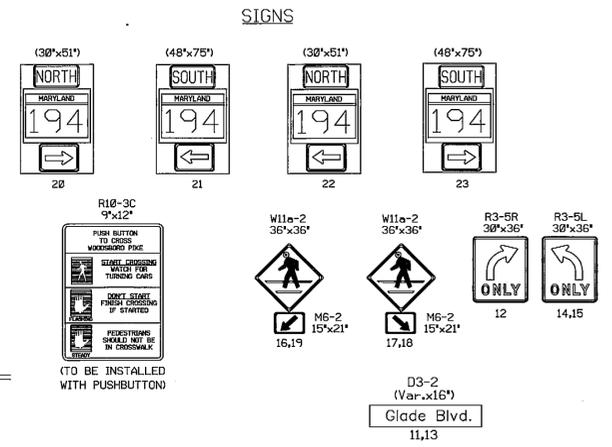


F H W A REGION NO.	STATE	FED. AID PROJ. NO.	SHEET NO.	TOTAL SHEETS
3	MD			

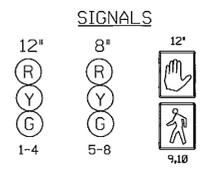

UTILITY LEGEND

— T —	TELEPHONE CABLES
— G —	GAS MAIN
— W —	WATER MAIN
— S —	SEWER MAIN
— E —	ELECTRIC CABLES
— A —	AERIAL CABLES
— BC —	BURIED CABLE
— SD —	STORM DRAIN

GEOMETRIC LEGEND

—	EXISTING GEOMETRICS
—	PROPOSED GEOMETRICS

GENERAL NOTES

- PAVEMENT MARKINGS DETAILED ARE PROPOSED AND ARE TO BE INSTALLED BY THE CONTRACTOR IN ACCORDANCE WITH SHA STANDARDS.
- THE CONTRACTOR WILL CONFIRM THE LOCATION OF ALL PROPOSED SIDEWALK RAMP AND PAVEMENT MARKING PRIOR TO INSTALLATION.
- "D.O." INDICATES DELAY OUTPUT.

REVISIONS	APPROVALS
D. 4/16/96 ASBUILT	CHIEF, SIGNAL DESIGN SECTION
M.A.M. 6/95 ADD PEDESTRIAN SIGNAL AND PUSH-BUTTONS, SIGNS, AND CROSSWALK FOR THE SOUTH LEG.	ASST. DISTRICT ENGINEER, TRAFFIC
D.M.P. [Signature] 4/87 RECONSTRUCT DUE TO NEW DRIVEWAY. SHA No. BW-112-701-712	CHIEF, TRAFFIC ENGINEERING DESIGN DIVISION
G.E.C.	DEPUTY CHIEF ENGINEER, OFFICE OF TRAFFIC
A. 3/28/87 ASBUILT	
G.E.C.	

MDOT - STATE HIGHWAY ADMINISTRATION
Office of Traffic & Safety
TRAFFIC ENGINEERING DESIGN DIVISION

ORIGINAL DRAWN BY: D. MILLER
DES. BY: G. COOK
CHK. BY: _____

DATE: 2/26/85
SCALE: 1"=20'

F.A.P. NO. _____
S.H.A. NO. F-153-501-785

LOG MILE #10019402.83
COUNTY: FREDERICK

MD 194 @ GLADE BLVD.

TS/FILE NO. 2064D-R
SHEET NO. 1 OF 1

ASBUILT

The Traffic Group
The Traffic Group, Inc.
Suite 600
40 W. Chesapeake Avenue
Towson, Maryland 21204
410-583-8405
1-800-583-8411
Fax 410-321-8458
Job No. 251127