


NOTE:
 PHASES ASSOCIATED BY A DASHED LINE WILL OPERATE CONCURRENTLY.
 PHASES ASSOCIATED BY A SOLID LINE WILL NOT OPERATE CONCURRENTLY.

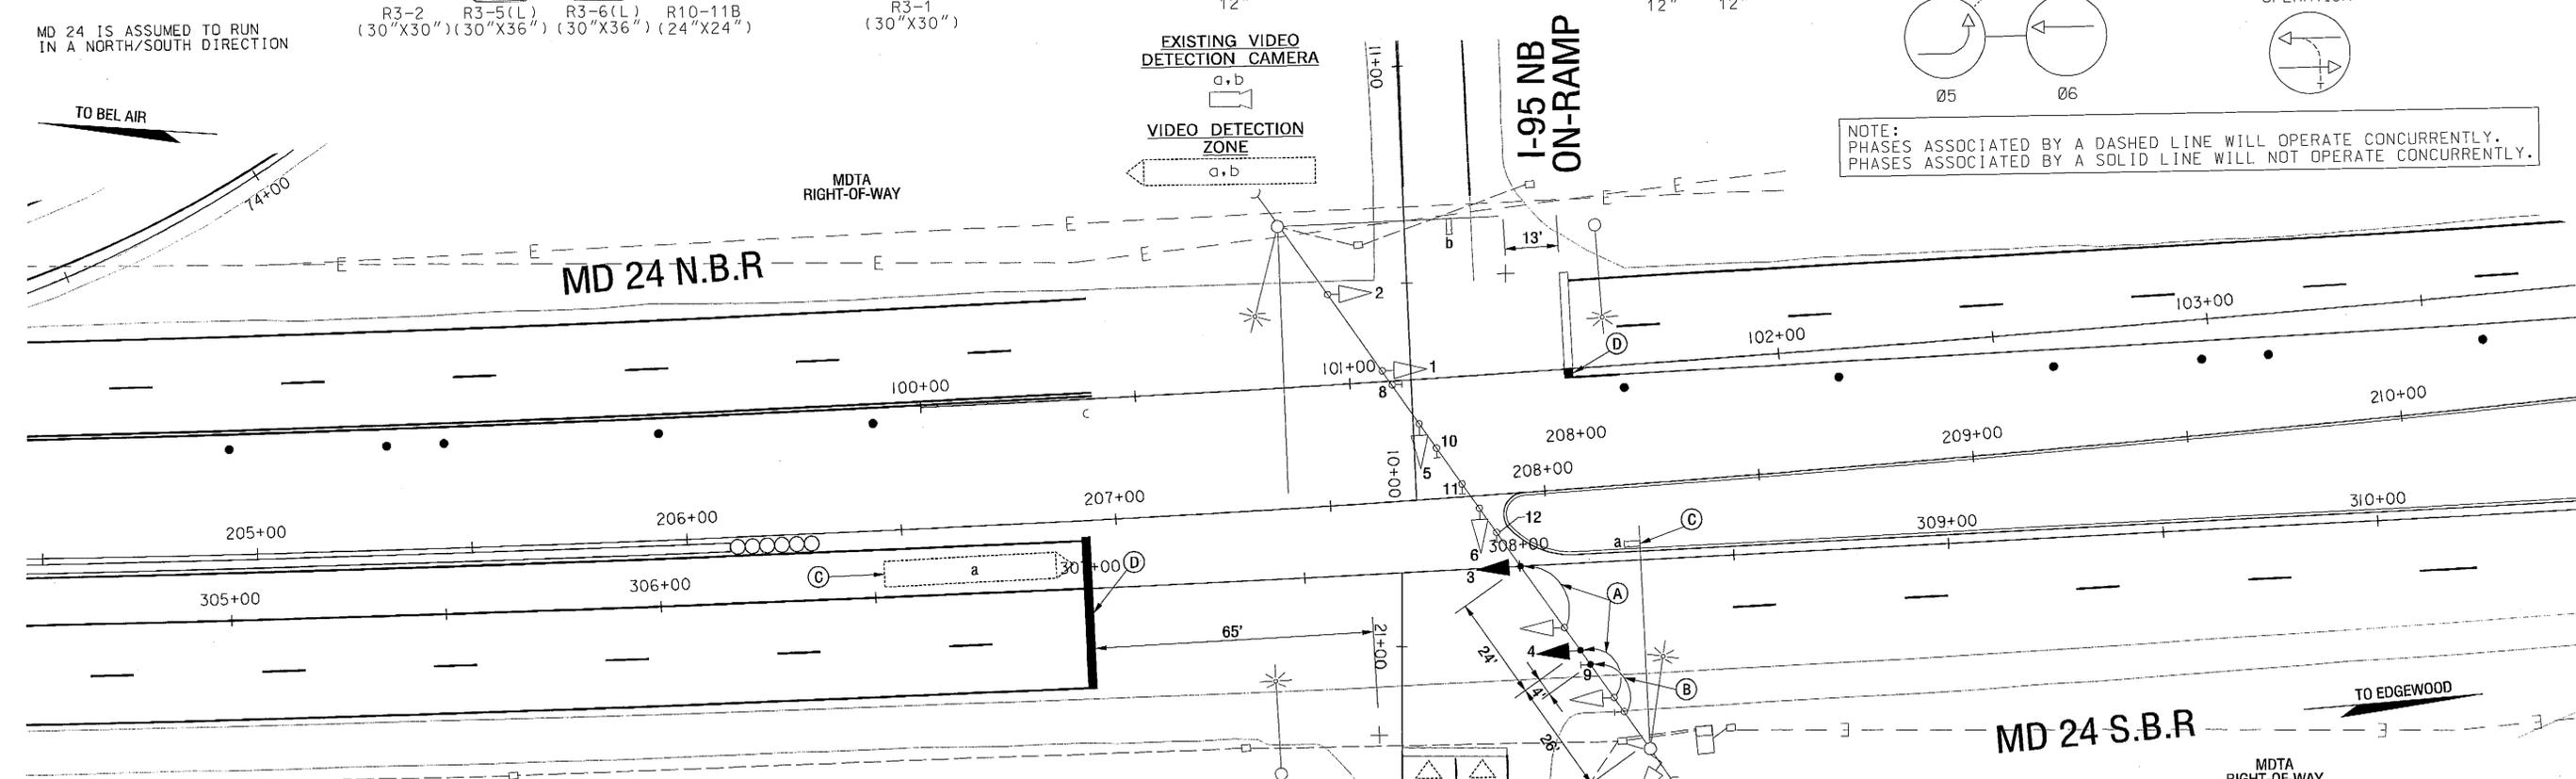

- GENERAL NOTES**
- VIDEO CAMERA LOCATION / ALIGNING SHALL BE COORDINATED WITH SHA/OOTS ENGINEER.
 - THE CONTRACTOR SHALL CONTACT THE ENGINEER 2 WEEKS PRIOR TO BEGINNING SIGNAL WORK TO ARRANGE FOR SHA SIGNAL INSPECTION.

CONSTRUCTION DETAILS

- RELOCATE EXISTING SPAN WIRE MOUNTED SIGNAL HEAD.
- RELOCATE EXISTING SPAN WIRE MOUNTED SIGN.
- ADJUST VIDEO DETECTION ZONE.
- INSTALL 24 INCH WHITE REMOVABLE PREFORMED PAVEMENT LINE MARKING FOR STOP LINE.
- MAINTAIN EXISTING MICRO LOOP PROBES.

GEOMETRIC LEGEND


--- EXISTING
 = = = PROPOSED

UTILITY LEGEND

SD STORM DRAIN
 G GAS MAIN
 W WATER MAIN
 SAH SEWER MAIN
 E ELECTRIC CABLES
 A AERIAL CABLES
 T TELEPHONE CABLES
 FO FIBER-OPTIC

MOT LEGEND

WORK ZONE
 TEMPORARY SIGN AND POST
 CRASH CUSHION SAND FILLED PLASTIC BARRELS
 TYPE III BARRICADE
 DRUMS
 PRECAST TEMPORARY CONCRETE TRAFFIC BARRIER

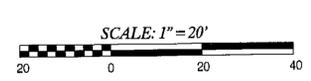

SABRA, WANG & ASSOCIATES, INC.
 1504 JOH AVENUE
 SUITE 160
 BALTIMORE, MD 21227
 (410) 737-6664
 WWW.SABRA-WANG.COM

APPROVALS

TEAM LEADER, TRAFFIC ENGINEERING DIVISION
 ASST. CHIEF TRAFFIC ENGINEERING DIVISION
 CHIEF TRAFFIC ENGINEERING DIVISION
 DIRECTOR, OFFICE OF TRAFFIC & SAFETY

REVISIONS

© STAGE 3 MOT SIGNAL DUE TO GEOMETRIC IMPROVEMENTS
 MDTA # KA-271-000-002(R3)
 SWA [Signature] 12/26/03 11/11/03 03/07
 (B) INSTALL VIDEO DETECTION
 SHA NO. AT3085185
 SWA [Signature] 05/10/04
 (A) ASBUILT
 AW 103-501-485
 PRZ [Signature] 02/10/97

MOT STAGE : 3

SHA STATE OF MARYLAND
 DEPARTMENT OF TRANSPORTATION
 STATE HIGHWAY ADMINISTRATION
 OFFICE OF TRAFFIC & SAFETY
 TRAFFIC ENGINEERING DESIGN DIVISION

MD 24 AT NORTHBOUND I-95 OFF-RAMP (RAMP A1)
 IMPROVEMENTS TO I-95 AND MD 24 INTERCHANGE
 ABINGDON, MARYLAND

TEMPORARY TRAFFIC SIGNAL PLAN

SCALE: 1" = 20' DATE: 01/20/97 CONTRACT NO.: AW 103-501-485

DESIGNED BY: T. ZAYDEL COUNTY: HARFORD
 DRAWN BY: S. BLOSS LOGMILE: 12002403.47
 CHECKED BY: T. HANNAN TMS NO.:
 FAP NO.: TOD NO.:

TS NO. 3618C DRAWING PSG OF P009 SHEET NO. 458 OF 597

REPLACE SHEET, APR. 07

ORIGINAL ON FILE