
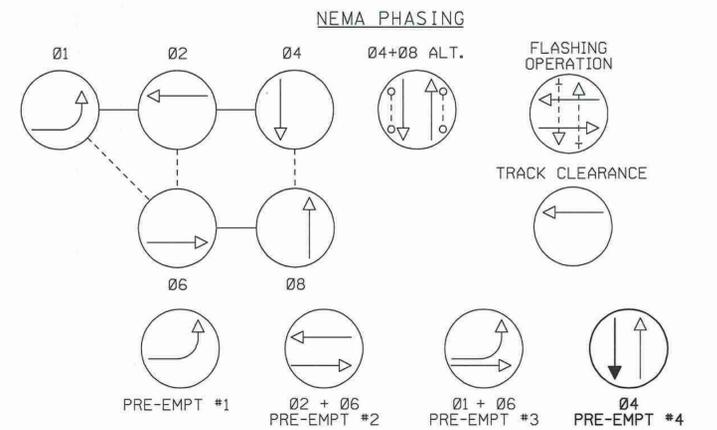
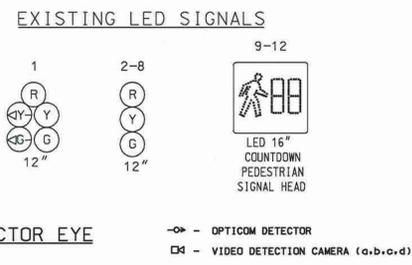
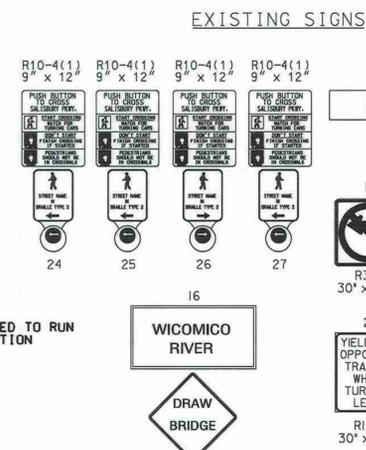


DRILL HOLES

DRILL HOLES

DRILL HOLES

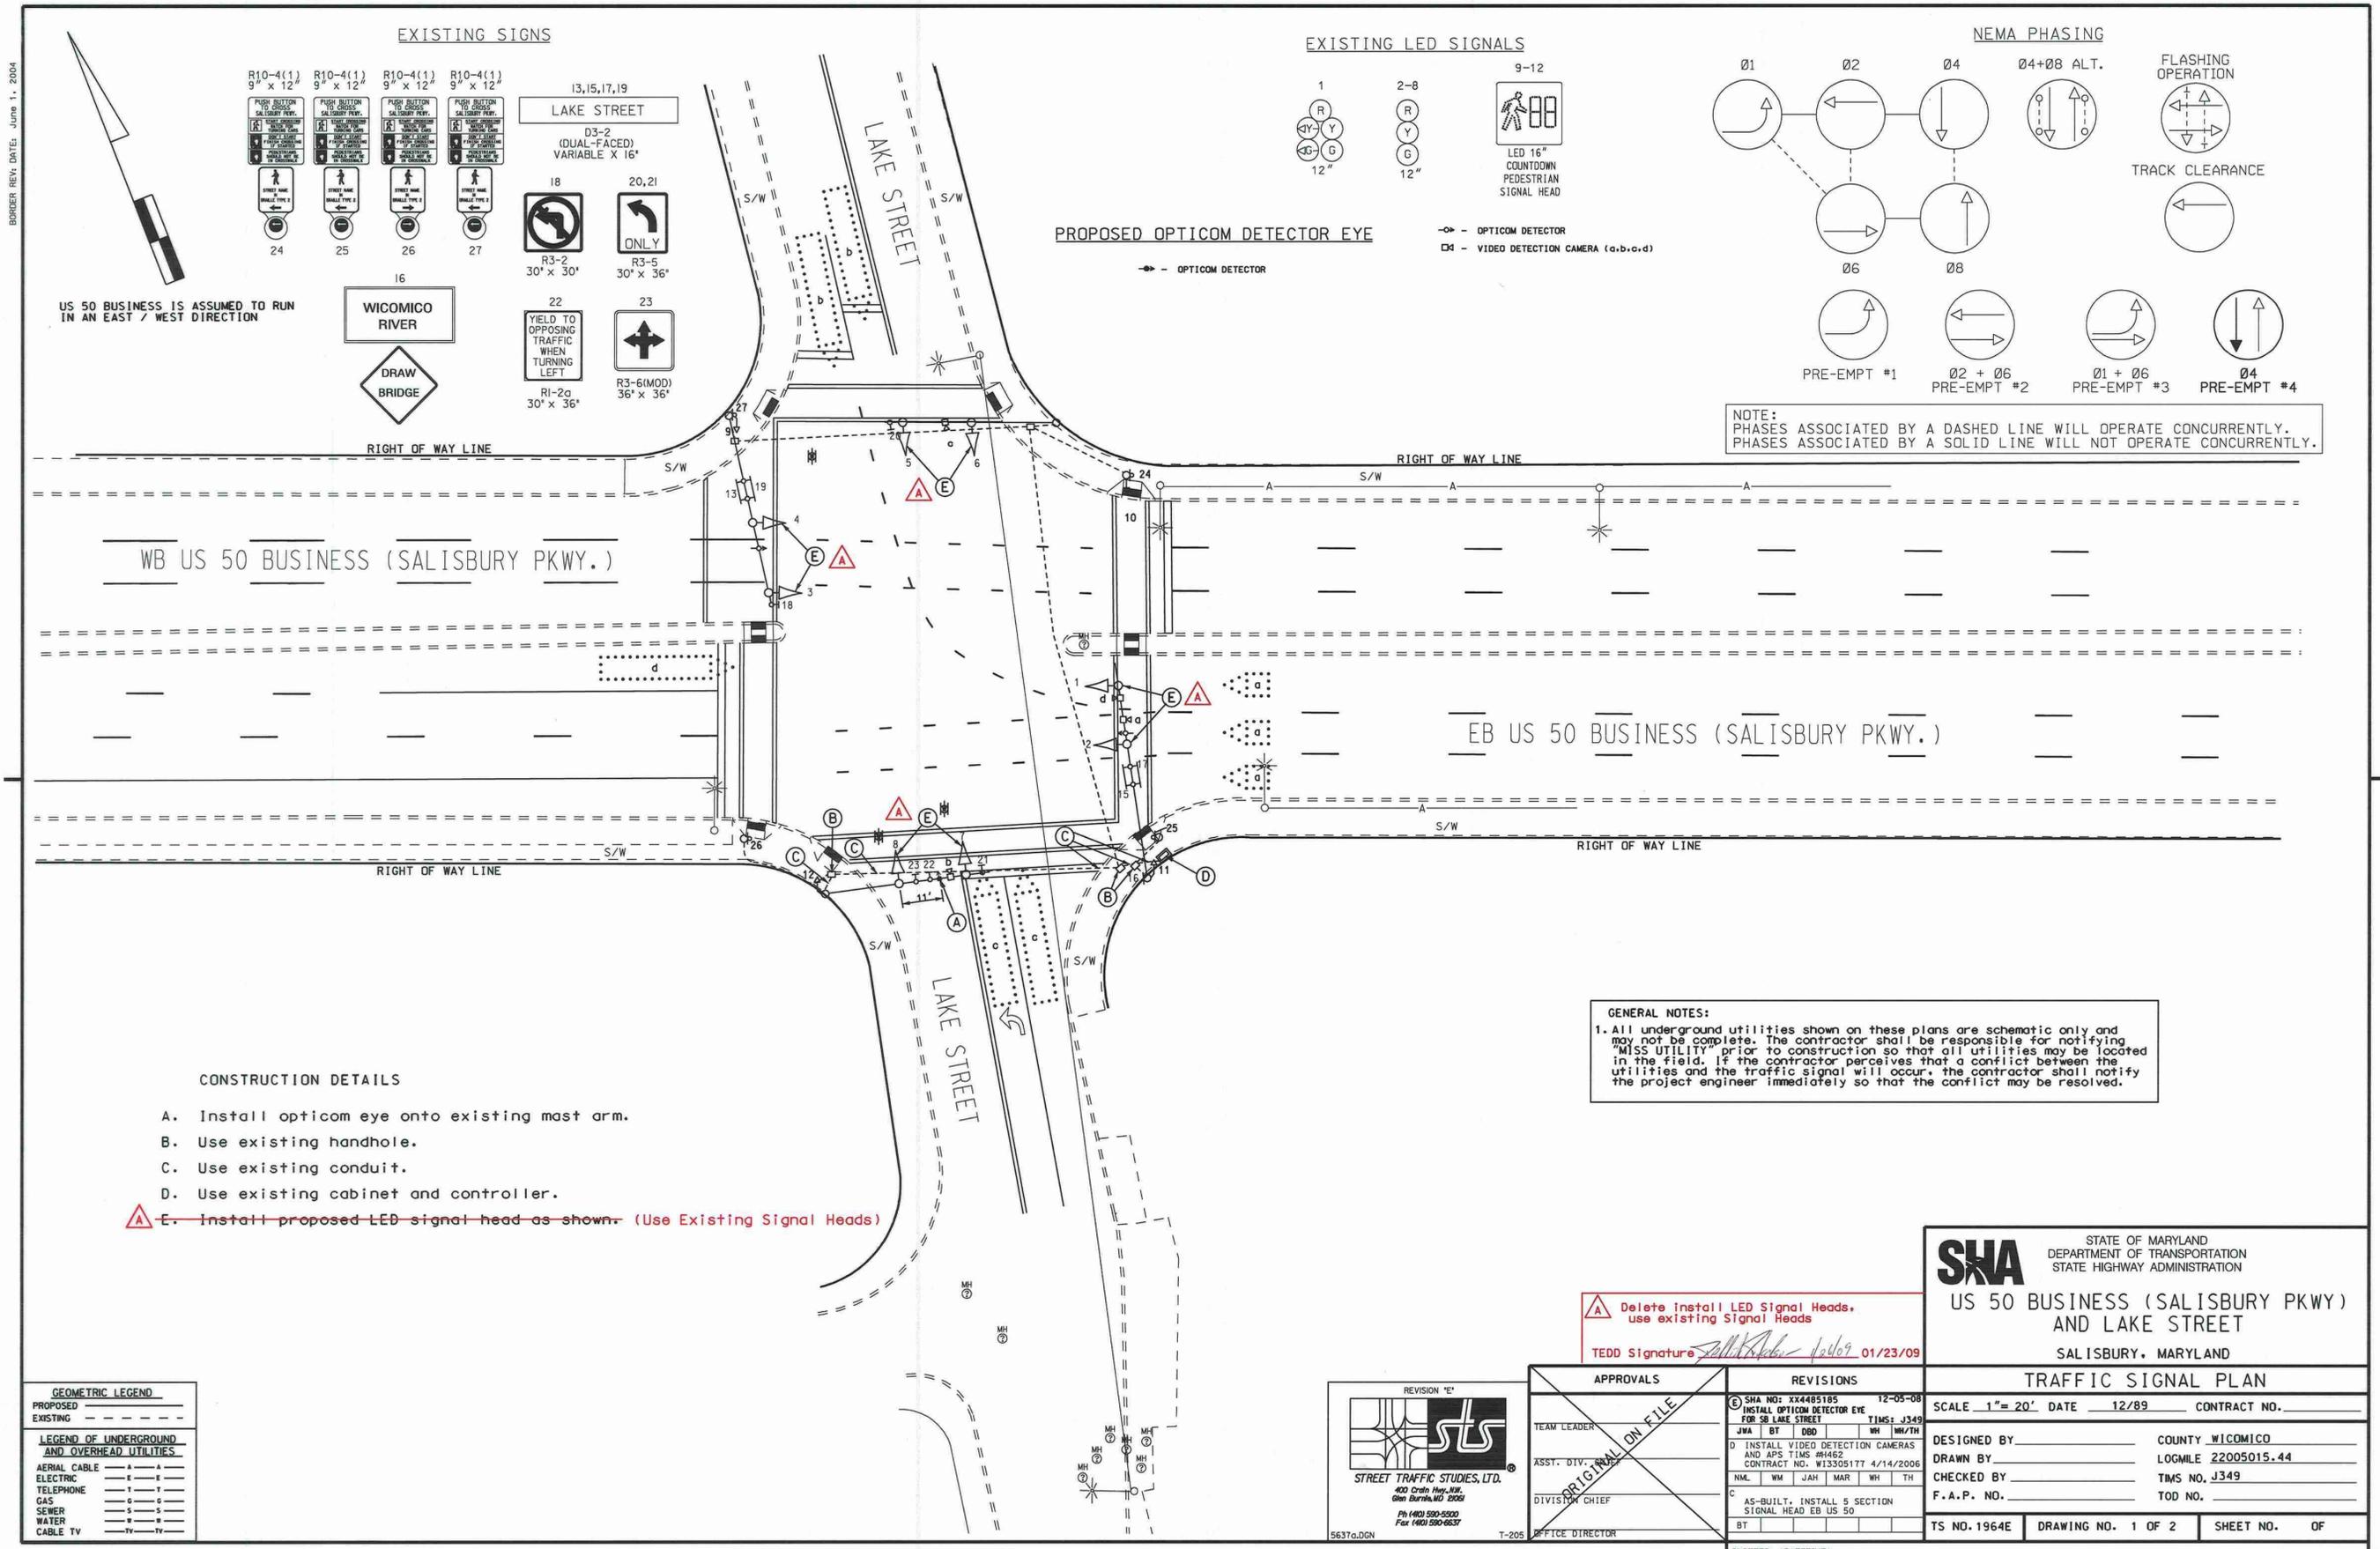

NOTE:
 PHASES ASSOCIATED BY A DASHED LINE WILL OPERATE CONCURRENTLY.
 PHASES ASSOCIATED BY A SOLID LINE WILL NOT OPERATE CONCURRENTLY.

- CONSTRUCTION DETAILS**
- A. Install opticom eye onto existing mast arm.
 - B. Use existing handhole.
 - C. Use existing conduit.
 - D. Use existing cabinet and controller.
 - ~~E. Install proposed LED signal head as shown. (Use Existing Signal Heads)~~

GENERAL NOTES:

1. All underground utilities shown on these plans are schematic only and may not be complete. The contractor shall be responsible for notifying "MISS UTILITY" prior to construction so that all utilities may be located in the field. If the contractor perceives that a conflict between the utilities and the traffic signal will occur, the contractor shall notify the project engineer immediately so that the conflict may be resolved.

Delete install LED Signal Heads, use existing Signal Heads

TEDD Signature *[Signature]* 01/23/09

SHA STATE OF MARYLAND
 DEPARTMENT OF TRANSPORTATION
 STATE HIGHWAY ADMINISTRATION

US 50 BUSINESS (SALISBURY PKWY) AND LAKE STREET

SALISBURY, MARYLAND

TRAFFIC SIGNAL PLAN

SCALE 1" = 20' DATE 12/89 CONTRACT NO. _____

DESIGNED BY _____ COUNTY WICOMICO

DRAWN BY _____ LOGMILE 22005015.44

CHECKED BY _____ TMS NO. J349

F.A.P. NO. _____ TOD NO. _____

TS NO. 1964E DRAWING NO. 1 OF 2 SHEET NO. OF

GEOMETRIC LEGEND

PROPOSED _____

EXISTING _____

LEGEND OF UNDERGROUND AND OVERHEAD UTILITIES

AERIAL CABLE A-A

ELECTRIC E-E

TELEPHONE T-T

GAS G-G

SEWER S-S

WATER W-W

CABLE TV TV-TV

REVISION "E"

ST

STREET TRAFFIC STUDIES, LTD.

400 Crain Hwy., N.W.
 Gaithersburg, MD 20878

PH (410) 590-5500
 Fax (410) 590-6637

5637a.DGN T-205

APPROVALS

TEAM LEADER _____

ASST. DIV. CHIEF _____

DIVISION CHIEF _____

OFFICE DIRECTOR _____

REVISIONS

SHA NO: XX4485185 12-05-08
 INSTALL OPTICOM DETECTOR EYE FOR SB LAKE STREET TMS: J349

JWA BT DBD WH WH/TH

D INSTALL VIDEO DETECTION CAMERAS AND APS TMS #4462 CONTRACT NO. W13305177 4/14/2006

NML WM JAH MAR WH TH

C AS-BUILT, INSTALL 5 SECTION SIGNAL HEAD EB US 50

BT

PLOTTED: #DATE# TIME#
 FILE: #FILE#