
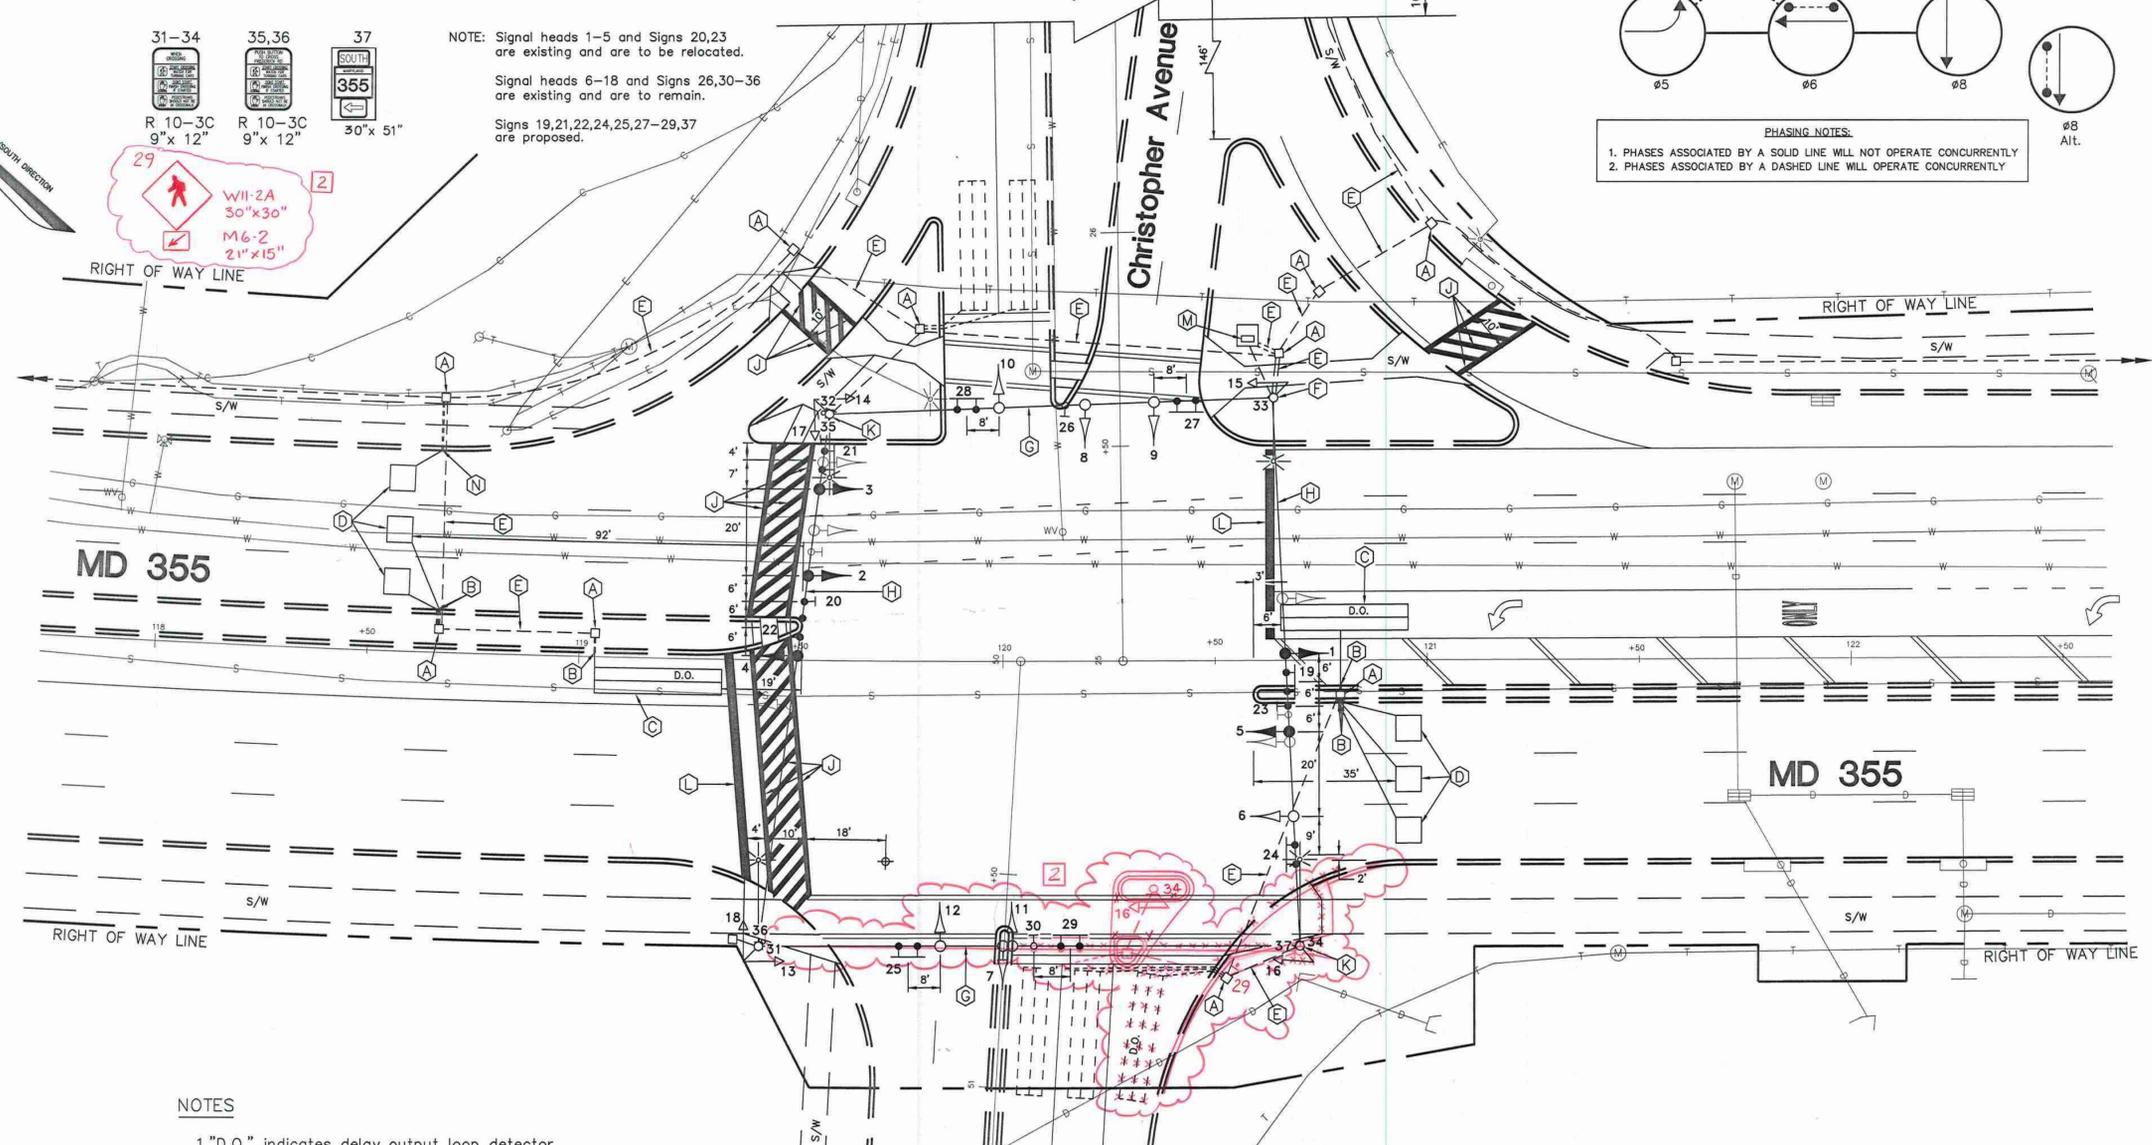
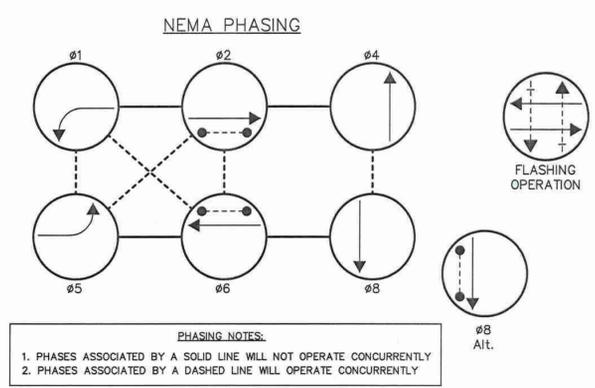
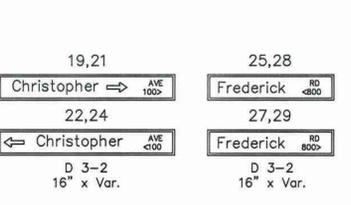



FHWA REGION NO	STATE	FED. AID PROJ. NO	SHEET NO.	TOTAL SHEETS
3	MD.	SEE TITLE SHEET		

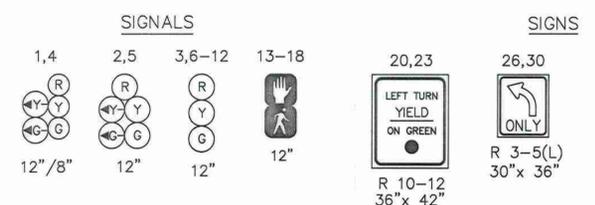

NOTE: Signal heads 1-5 and Signs 20,23 are existing and are to be relocated.

Signal heads 6-18 and Signs 26,30-36 are existing and are to remain.

Signs 19,21,22,24,25,27-29,37 are proposed.

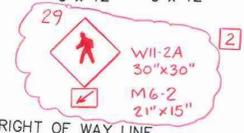

- NOTES**
- "D.O." indicates delay output loop detector.
 - Proposed geometrics shall be confirmed prior to the installation of signal equipment.
 - Loop detectors and conduit shall be installed prior to the installation of pavement markings.
 - Pavement markings detailed are proposed and are to be installed by the contractor in accordance with S.H.A. standards. All other pavement markings not detailed will be installed as part of the highway contract.
 - Revision 'B' is a revision to the traffic signal built in September, 1986 under Contract S.H.A. No.: BW-890-801-312.
 - All utilities are shown in their approximate location and are not to be considered as complete. The Contractor shall be responsible for contacting Miss Utility to verify the the locations of all utilities. The Contractor shall contact the appropriate personnel prior to construction to avoid potential conflicts so that field adjustments can be made.
 - Interconnect to be maintained at all times.

GEOMETRIC LEGEND

— — — — — EXISTING GEOMETRICS

— — — — — PROPOSED GEOMETRICS

UTILITY LEGEND

— G — G — GAS MAIN

— W — W — WATER MAIN

— S — S — SEWER MAIN

— D — D — STORM DRAIN

— E — E — ELECTRIC CABLES

— A — A — AERIAL CABLES

— T — T — TELEPHONE CABLES

— C — C — CABLE TELEVISION

Revision 'B' & 'C'

REVISIONS	APPROVALS
<p>① Revise for geometric modifications in southeast quadrant. 10/23/86</p> <p>J.F.L. [Signature]</p> <p>② Rebuild to new geometrics. November 6, 1993. S.H.A. No. M-811-501-371</p> <p>[Signature]</p>	<p>CHIEF, SIGNAL DESIGN SECTION</p> <p>ASST. DISTRICT ENGINEER, TRAFFIC</p> <p>CHIEF, TRAFFIC ENGINEERING DESIGN DIVISION</p> <p>DIRECTOR, OFFICE OF TRAFFIC & SAFETY</p>

Ultimate Traffic Control Signal Sheet 36 of 52

MDOT - STATE HIGHWAY ADMINISTRATION
Office of Traffic & Safety
TRAFFIC ENGINEERING DESIGN DIVISION SIGNAL # 15035515.86

MD 355 at Christopher Avenue/ IBM Entrance
COUNTY: MONTGOMERY

DRAWN BY: T. Zaydel	F.A.P. NO. N/A	TS/STD. NO. 2230B	SHEET NO. 325 OF 370
DES. BY: T. Zaydel	S.H.A. NO. BW-890-801-312		
CHK. BY: D. Doda			
DATE: September 26, 1986			
SCALE: 1" = 20'			

2 REDLINE REVISION 1/24/97

IBM Entrance

F:\94-264\AUTOCAD\SIGNS\SIGNS.DWG - 10/23/86 4:26:57 AM 1995 BY: A/E Group, Inc.