




**GENERAL NOTES**

1. REMOVE AND DISPOSE OF ALL UNUSED INTERCONNECT CABLE.
2. THE CONTRACTOR SHALL BE RESPONSIBLE FOR TERMINATING ALL SIGNAL CABLE TO THE APPROPRIATE TERMINALS AND PROPERLY LABEL EACH CABLE.
3. CONTRACTOR SHALL COIL 10 FT. OF ADDITIONAL INTERCONNECT CABLE IN EACH HANDHOLE FOR FUTURE USE.

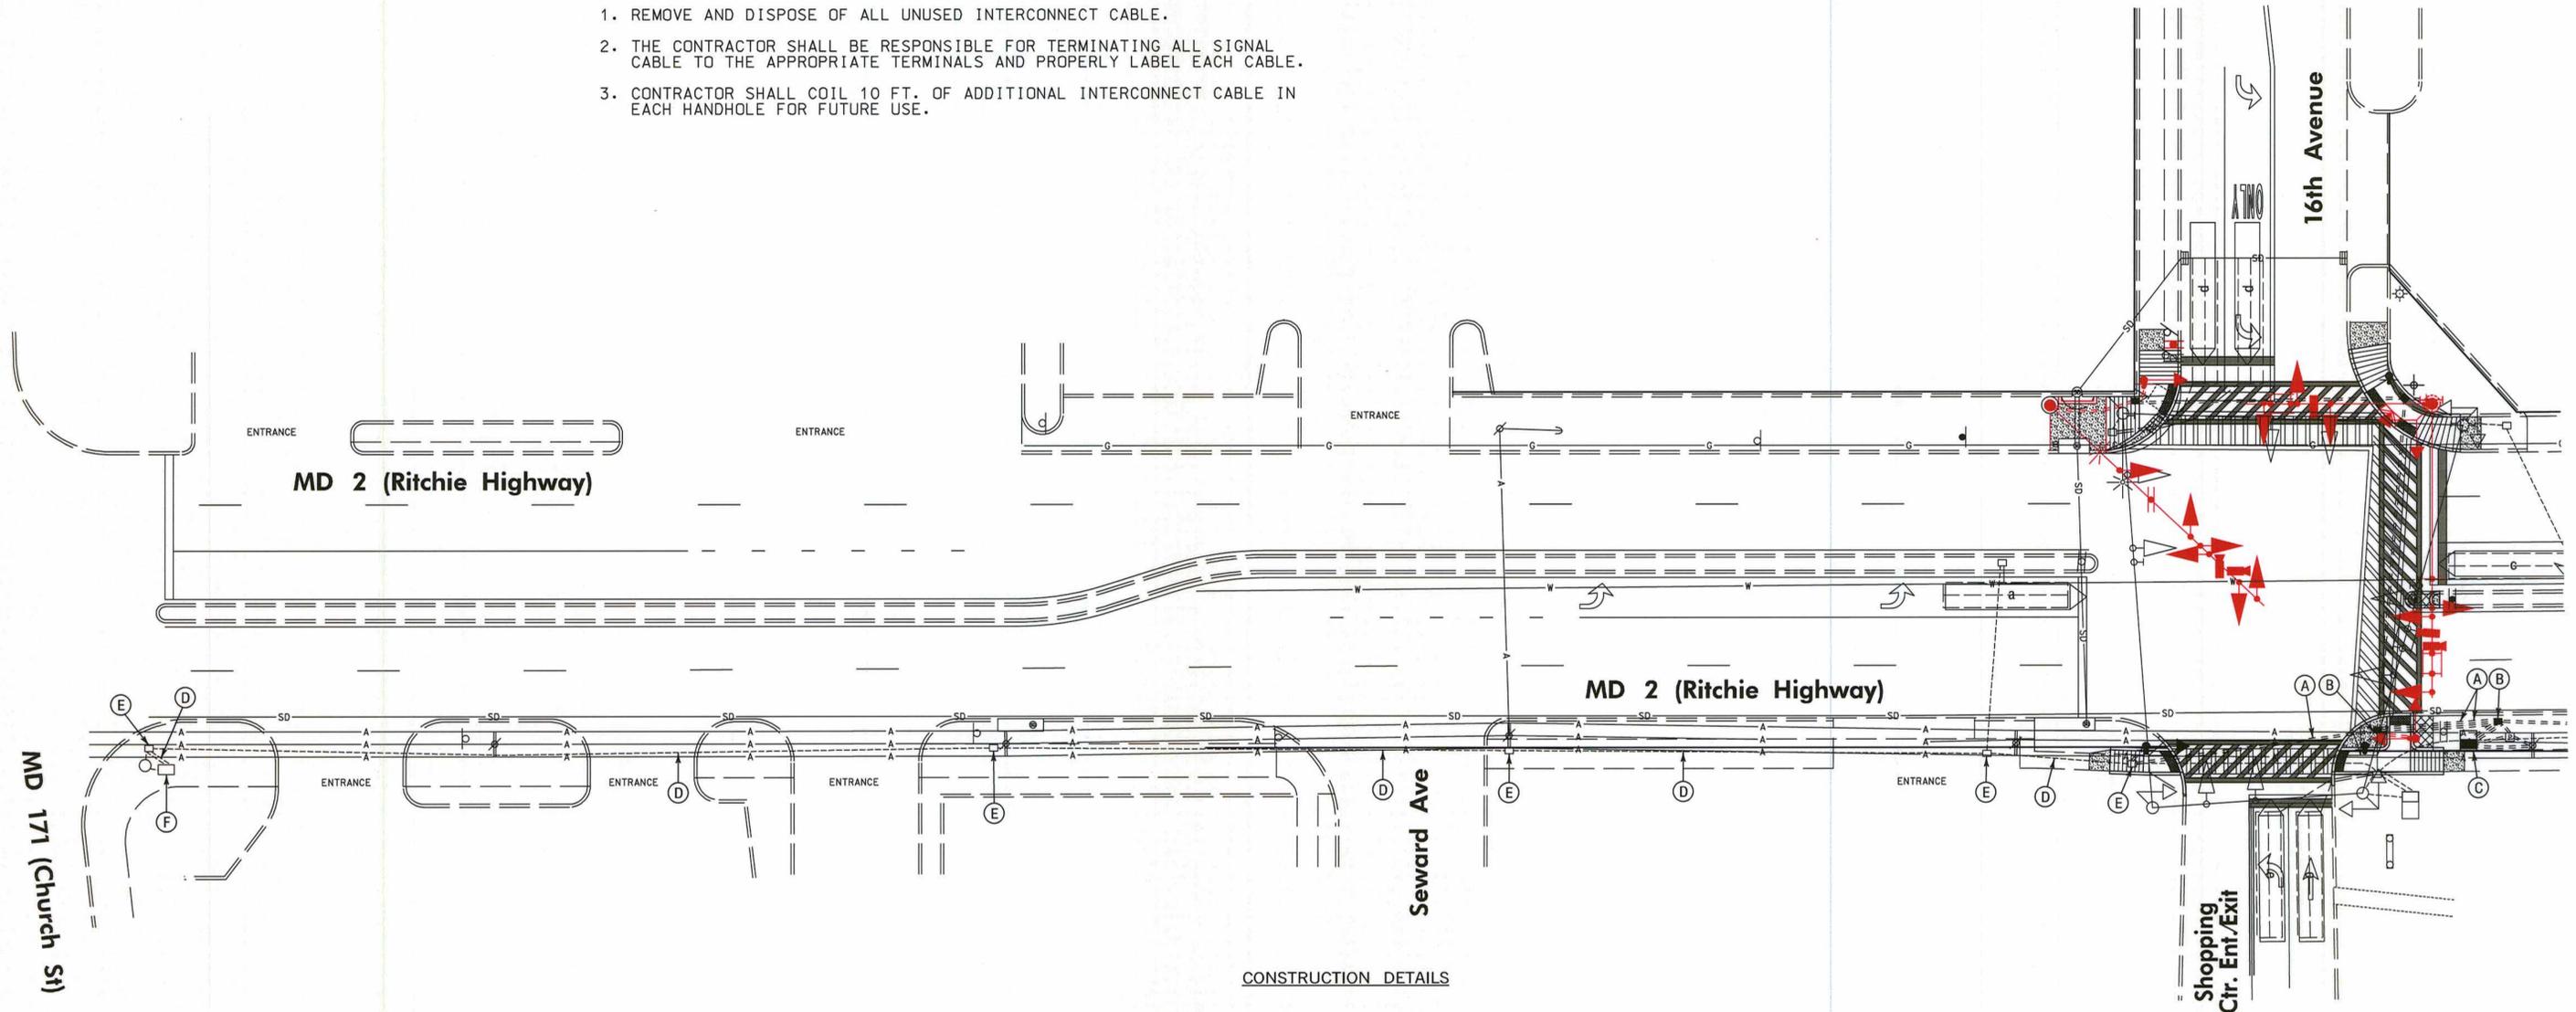

**CONSTRUCTION DETAILS**

- A. USE PROPOSED CONDUIT. INSTALL 12-PAIR COMMUNICATION CABLE. (SEE SIGNAL PLANS)
- B. USE PROPOSED HANDHOLE. INSTALL 12-PAIR COMMUNICATION CABLE (SEE SIGNAL PLANS). CONTRACTOR SHALL COIL 10 FT. OF ADDITIONAL INTERCONNECT CABLE IN HANDHOLE FOR FUTURE USE.
- C. USE PROPOSED BASE MOUNTED CABINET AND CONTROLLER. INSTALL 12 PAIR COMMUNICATION CABLE. (SEE SIGNAL PLANS)
- D. USE EXISTING CONDUIT. INSTALL 12-PAIR COMMUNICATION CABLE.
- E. USE EXISTING HANDHOLE. INSTALL 12-PAIR COMMUNICATION CABLE. CONTRACTOR SHALL COIL 10 FT. OF ADDITIONAL INTERCONNECT CABLE IN HANDHOLE FOR FUTURE USE.
- F. USE EXISTING BASE MOUNTED CABINET AND CONTROLLER. INSTALL 12-PAIR COMMUNICATION CABLE. (SEE SIGNAL PLANS)

*[Signature]*  
 1 REDLINE REVISION NO. 1  
 REVISED SIGNAL POLE  
 LOCATIONS 8/10/2012

**SHA** STATE OF MARYLAND  
 DEPARTMENT OF TRANSPORTATION  
 STATE HIGHWAY ADMINISTRATION  
 OFFICE OF TRAFFIC & SAFETY  
 TRAFFIC ENGINEERING DESIGN DIVISION  
 MD 2 (Ritchie Highway) and 16TH Avenue  
 Brooklyn Park, MD

**INTERCONNECT PLAN**

SCALE 1" = 20'      DATE 4/30/2012      CONTRACT NO. XX6475185

DESIGNED BY S. Bloss      COUNTY Anne Arundel  
 DRAWN BY S. Bloss      LOGMILE  
 CHECKED BY N. Leary      TMS NO. L201  
 F.A.P. NO.      TOD NO.

TS NO. 2105C      DRAWING TSP-2      OF 4      SHEET NO. 2 OF 4

**WR&A**  
 WHITMAN, REQUARDT  
 & ASSOCIATES, LLP  
 801 South Caroline Street, Baltimore, Maryland 21231

BY: sbloss