


MD 173 (FORT SMALLWOOD ROAD) IS ASSUMED TO RUN IN A NORTH-SOUTH DIRECTION

NOTE: PHASES ASSOCIATED BY A DASHED LINE WILL OPERATE CONCURRENTLY. PHASES ASSOCIATED BY A SOLID LINE WILL NOT OPERATE CONCURRENTLY.

NOTE: CONTRACTOR SHALL COORDINATE WITH BGE FOR THE REMOVAL OF THE EXISTING OVERHEAD POWER FEED.

USE ONE (1) EXISTING HANDHOLE IN BREAK

INTERCONNECT TO MARLEY NECK BOULEVARD. REFER TO INTERCONNECT PLANS.

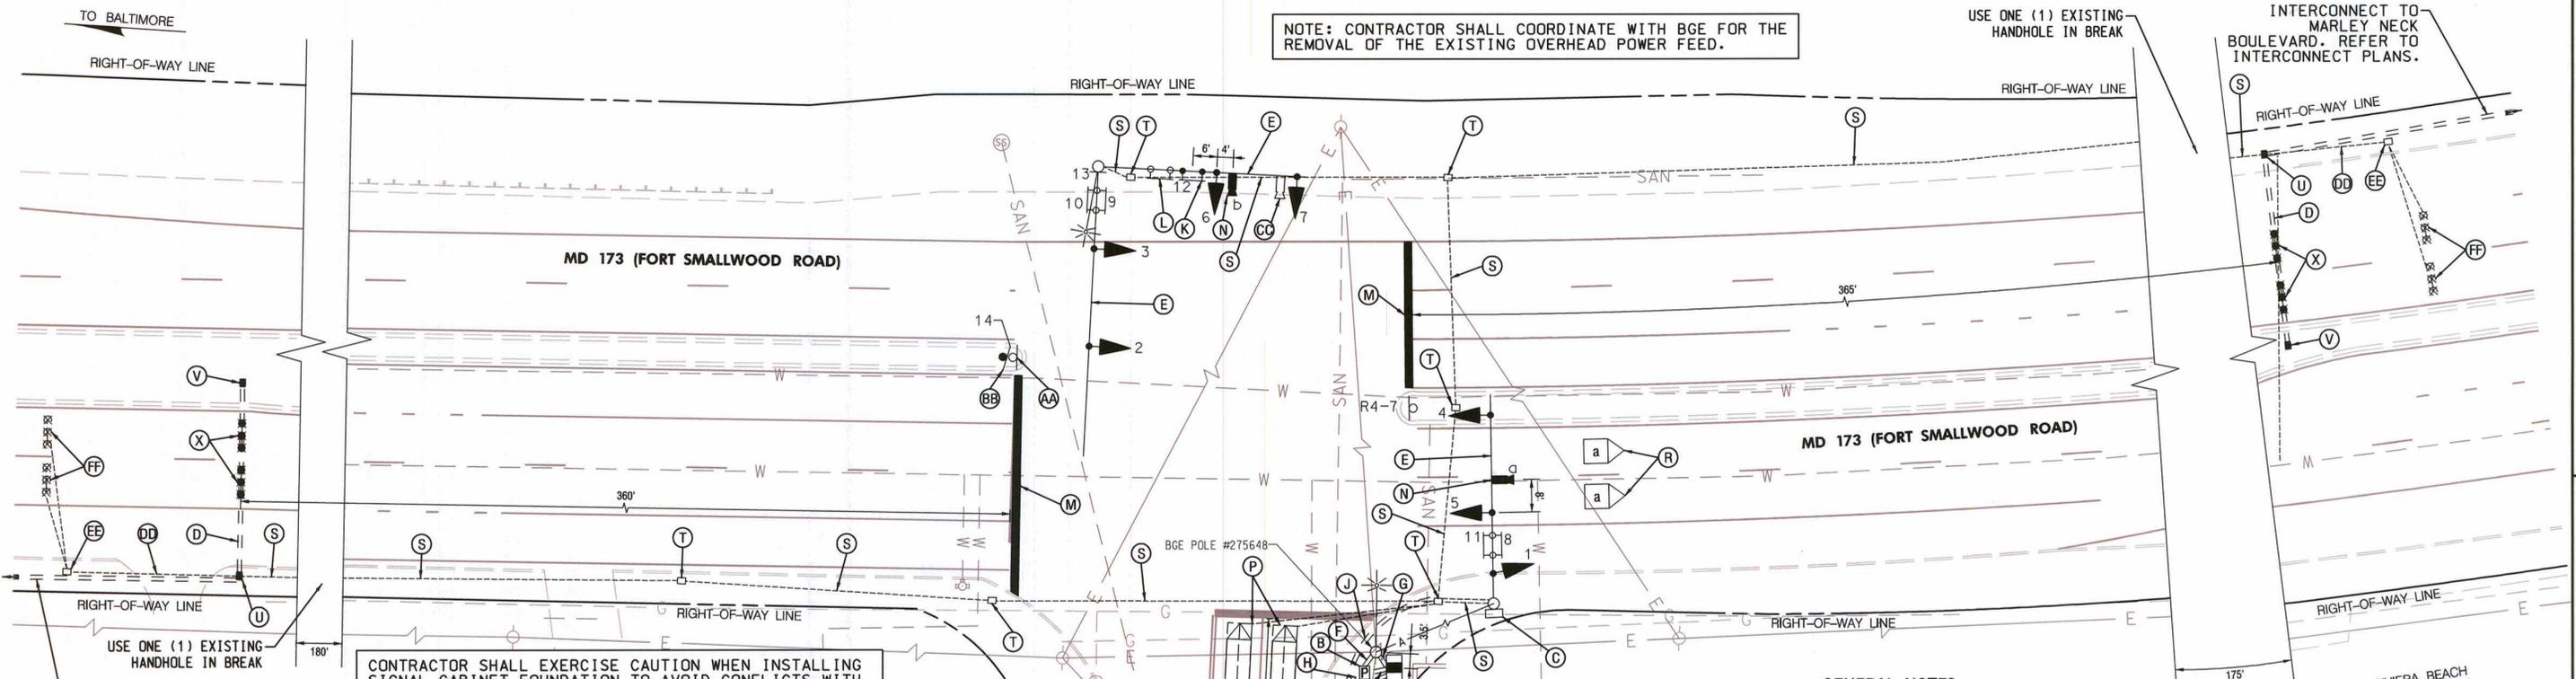

CONTRACTOR SHALL EXERCISE CAUTION WHEN INSTALLING SIGNAL CABINET FOUNDATION TO AVOID CONFLICTS WITH EXISTING UTILITIES.

CONSTRUCTION DETAILS

- A. INSTALL CONCRETE FOUNDATION WITH A TYPE S BASE MOUNTED CABINET AND MASTER CONTROLLER. (NOTE: TWO-4 IN. AND TWO-2 IN. PVC SCHEDULE 80, 90-DEGREE BENDS).
- B. INSTALL 100 AMP METERED SERVICE PEDESTAL. (NOTE: ONE-4 IN. AND TWO-2 IN. PVC SCHEDULE 80, 90-DEGREE CONDUIT BENDS)
- C. REMOVE EXISTING POLE MOUNTED CABINET AND CONTROLLER AND ELECTRICAL UTILITY SERVICE EQUIPMENT.
- D. INSTALL 3 IN. PVC SCHEDULE 80 ELECTRICAL CONDUIT - SLOTTED.
- E. REPLACE ALL EXISTING MAST ARM MOUNTED SIGNAL HEADS WITH NEW LED SIGNAL HEADS IN THE SAME LOCATION.
- F. INSTALL 4 IN. PVC SCHEDULE 80 ELECTRICAL CONDUIT FOR ELECTRICAL SERVICE - TRENCHED. STUB OUT CONDUIT BEND AT BASE OF UTILITY POLE.
- G. INSTALL 2 IN. PVC SCHEDULE 80 ELECTRICAL CONDUIT FOR PHONE DROP - TRENCHED. STUB OUT CONDUIT BEND AT BASE OF UTILITY POLE.
- H. INSTALL 2 IN. PVC SCHEDULE 80 ELECTRICAL CONDUIT - TRENCHED
- J. INSTALL 4 IN. PVC SCHEDULE 80 ELECTRICAL CONDUIT - TRENCHED.
- K. INSTALL SIGN ON EXISTING MAST ARM, AS SHOWN.
- L. REMOVE SIGN FROM EXISTING MAST ARM.
- M. REMOVE EXISTING STOP LINE PAVEMENT MARKING AND INSTALL 24 IN. HEAT APPLIED, WHITE PERMANENT PERFORMED THERMOPLASTIC PAVEMENT MARKING AT THE SAME LOCATION.
- N. INSTALL VIDEO DETECTION CAMERA ON EXISTING MAST ARM, AS SHOWN.
- P. DISCONNECT AND REMOVE LOOP DETECTOR CABLES FROM CONDUITS, HANDHOLES, SIGNAL STRUCTURES, AND CONTROLLER.
- R. VIDEO DETECTION ZONE TO BE ALIGNED BY SHA ENGINEER.

GEOMETRIC LEGEND

--- EXISTING


UTILITY LEGEND

- SD STORM DRAIN
- G GAS MAIN
- W WATER MAIN
- SAN SEWER MAIN
- UG ELEC ELECTRICAL CABLES
- E AERIAL CABLES
- UG TEL TELEPHONE CABLES
- UG FO FIBER-OPTIC

- S. USE EXISTING CONDUIT.
- T. USE EXISTING HANDHOLE.
- U. INTERCEPT EXISTING CONDUIT. INSTALL HANDHOLE WITH LONGER DIMENSION PERPENDICULAR TO THE ROADWAY FOR NON-INVASIVE PROBES.
- V. INSTALL HANDHOLE WITH LONGER DIMENSION PERPENDICULAR TO THE ROADWAY FOR NON-INVASIVE PROBES.
- W. INSTALL NON-INVASIVE PROBES WITH 500 FT. LEAD-IN CABLE. (TO BE CENTERED IN LANE)
- X. INSTALL NON-INVASIVE PROBES WITH 1,000 FT. LEAD-IN CABLE. (TO BE CENTERED IN LANE)
- Y. INSTALL HANDHOLE.
- Z. INSTALL 3 IN. PVC SCHEDULE 80 ELECTRICAL CONDUIT - ~~TRENCHED~~ BORED. **[1]**
- AA. REMOVE EXISTING SIGN AND SUPPORT.
- BB. INSTALL GROUND MOUNTED SIGN ON A SINGLE WOOD (4 IN. X 4 IN.) SUPPORT.
- CC. REMOVE EXISTING VIDEO DETECTION CAMERA FROM EXISTING MAST ARM.
- DD. CAP AND ABANDON EXISTING CONDUIT.
- EE. REMOVE EXISTING HANDHOLE AND BACKFILL.
- FF. ABANDON EXISTING PROBES.

GENERAL NOTES

1. ALL PAVEMENT MARKINGS SHALL BE INSTALLED IN ACCORDANCE WITH ADMINISTRATION STANDARDS.
2. THE CONTRACTOR SHALL BE RESPONSIBLE FOR TERMINATING ALL SIGNAL CABLE TO THE APPROPRIATE TERMINALS AND PROPERLY LABELING EACH CABLE.
3. ALL TRAFFIC SIGNAL FOUNDATIONS SHALL BE INSTALLED AT THE FINAL SIDEWALK OR CURB GRADE FOR CLOSED SECTIONS, HIGHEST ROADWAY PROFILE GRADE FOR OPEN SECTIONS, TO MEET CLEARANCES AS SPECIFIED IN THE APPROPRIATE 800 SERIES STANDARD PLATES. THE CONTRACTOR SHALL VERIFY ULTIMATE GRADE PRIOR TO THE INSTALLATION OF ALL SIGNAL EQUIPMENT.
4. ALL UNDERGROUND AND OVERHEAD UTILITIES SHOWN ON THESE PLANS ARE SCHEMATIC ONLY AND MAY NOT BE COMPLETE. THE CONTRACTOR SHALL BE RESPONSIBLE FOR NOTIFYING MISS UTILITY PRIOR TO CONSTRUCTION SO THAT ALL UTILITIES MAY BE LOCATED IN THE FIELD. IF THE CONTRACTOR PERCEIVED THAT A CONFLICT BETWEEN THE UTILITIES AND THE TRAFFIC SIGNAL WILL OCCUR, THE CONTRACTOR SHALL NOTIFY THE PROJECT ENGINEER IMMEDIATELY SO THAT THE CONFLICT MAY BE RESOLVED.
5. THE CONTRACTOR SHALL MAINTAIN CONTINUOUS OPERATION OF ALL INTERCONNECT, VEHICULAR DETECTORS, AND LIGHTING DEVICES. IF ANY DEVICE IS DAMAGED BY THE CONTRACTOR, IT SHALL BE REPAIRED WITHIN 72 HOURS BY THE CONTRACTOR AT NO COST TO THE ADMINISTRATION AFTER NOTIFICATION BY THE ENGINEER.
6. UPON COMPLETION OF THIS PROJECT, THE CONTRACTOR SHALL NOTIFY MR. ROBERT SNYDER TO ARRANGE FOR THE PHONE LINE INSTALLATION. THE CONTRACTOR SHALL PROVIDE MR. SNYDER WITH THE NEAREST STREET ADDRESS, ZIP CODE, AND TELEPHONE NUMBER.
7. THE CONTRACTOR SHALL VERIFY SIGNAL CABINET LOCATION PRIOR TO INSTALLATION.
8. VIDEO CAMERA LOCATION AND ALIGNING SHALL BE COORDINATED WITH THE SHA ENGINEER.
9. THE CONTRACTOR SHALL BE RESPONSIBLE FOR REMOVING ALL UNUSED CABLE FROM ALL EXISTING CONDUITS.
10. DISCONNECTING AND SPLICING OF INTERCONNECT CABLE SHALL BE PERFORMED BY SHA FORCES. THE CONTRACTOR SHALL RUN THE INTERCONNECT CABLE INTO THE BASE OF EACH CABINET AND PROPERLY TAG EACH CABLE. CONTACT MR. ED RODENHIZER AT (410) 787-7650 SEVENTY-TWO HOURS IN ADVANCE OF INTENDED WORK.

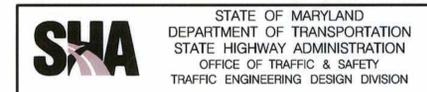

MD 173 (FORT SMALLWOOD ROAD) AT PITTMAN ROAD CURTIS BAY, MARYLAND

TRAFFIC SIGNAL PLAN

APPROVALS	REVISIONS	SCALE 1" = 20'	DATE 2-3-1997	CONTRACT NO. AW104M5G
TEAM LEADER, TRAFFIC ENGINEERING DIVISION	[1] REDLINE NO. 1, 09/28/2012	DESIGNED BY T. ZAYDEL	COUNTY ANNE ARUNDEL	
ASST. CHIEF TRAFFIC ENGINEERING DIVISION	SHA NO. X06475185 TMS NO. H408 06-2012	DRAWN BY T. ZAYDEL	LOGMILE 02017308.50	
CHIEF TRAFFIC ENGINEERING DIVISION	A REPLACE FAILED PROBE SETS SHA NO. AA348A55655	CHECKED BY K. SCHMID	TMS NO.	
DIRECTOR, OFFICE OF TRAFFIC & SAFETY		FAP NO.	TOD NO.	
		TS NO. 3655B	DRAWING SG-01 OF 15	SHEET NO. 1 OF 15

SABRA, WANG & ASSOCIATES, INC.
 7055 SAMUEL MORSE DRIVE
 SUITE 100
 COLUMBIA, MD 21046
 (443) 741-3500
 WWW.SABRA-WANG.COM