

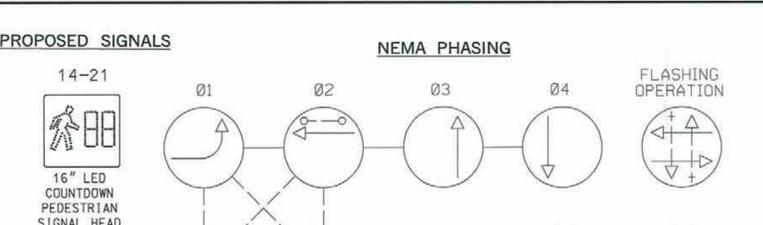
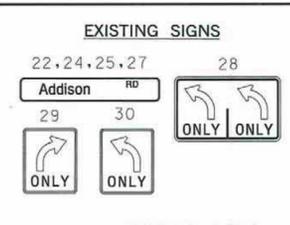


MD 214 IS ASSUMED TO RUN IN AN EAST-WEST DIRECTION

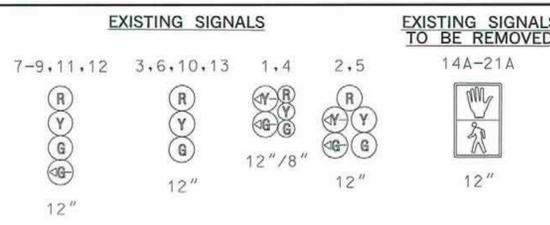

NOTE: PHASES ASSOCIATED BY A DASHED LINE WILL OPERATE CONCURRENTLY. PHASES ASSOCIATED BY A SOLID LINE WILL NOT OPERATE CONCURRENTLY.

- CONSTRUCTION DETAILS**
- A. INSTALL CONCRETE FOUNDATION WITH 10 FT. STEEL PEDESTAL POLE WITH BREAKAWAY BASE, COUNTDOWN PEDESTRIAN SIGNAL HEAD AUDIBLE/TACTILE PEDESTRIAN PUSHBUTTON INSTALLED WITH VIBRATING ARROW POINTING LEFT, R10-3(1) SIGN. (SIGN TO READ "PUSH BUTTON TO CROSS ADDISON ROAD"). (INSTALL 1-3 IN. SCHEDULE 80, 90 DEGREE PVC ELECTRICAL CONDUIT BEND IN PEDESTAL BASE).
 - B. WITH BREAKAWAY BASE, AUDIBLE/TACTILE PEDESTRIAN PUSHBUTTON INSTALLED WITH VIBRATING ARROW POINTING RIGHT, R10-3(1) SIGN. (SIGN TO READ "PUSH BUTTON TO CROSS ADDISON ROAD"). (INSTALL 1-3 IN. SCHEDULE 80, 90 DEGREE PVC ELECTRICAL CONDUIT BEND IN PEDESTAL BASE).
 - C. INSTALL CONCRETE FOUNDATION WITH 10 FT. STEEL PEDESTAL POLE (CUT TO 5 FT.) WITH BREAKAWAY BASE, AUDIBLE/TACTILE PEDESTRIAN PUSHBUTTON INSTALLED WITH VIBRATING ARROW POINTING LEFT, R10-3(1) SIGN. (SIGN TO READ "PUSH BUTTON TO CROSS CENTRAL AVENUE"). (INSTALL 1-3 IN. SCHEDULE 80, 90 DEGREE PVC ELECTRICAL CONDUIT BEND IN PEDESTAL BASE).
 - D. WITH BREAKAWAY BASE, COUNTDOWN PEDESTRIAN SIGNAL HEAD, AUDIBLE/TACTILE PEDESTRIAN PUSHBUTTON INSTALLED WITH VIBRATING ARROW POINTING RIGHT, R10-3(1) SIGN. (SIGN TO READ "PUSH BUTTON TO CROSS CENTRAL AVENUE"). (INSTALL 1-3 IN. SCHEDULE 80, 90 DEGREE PVC ELECTRICAL CONDUIT BEND IN PEDESTAL BASE).
 - E. USE EXISTING STEEL PEDESTAL POLE. REMOVE EXISTING PEDESTRIAN SIGNAL HEADS AND PUSHBUTTONS. INSTALL COUNTDOWN PEDESTRIAN SIGNAL HEADS AND AUDIBLE/TACTILE PEDESTRIAN PUSHBUTTON INSTALLED WITH VIBRATING ARROW POINTING RIGHT AND R10-3(1) SIGN. (SIGN TO READ "PUSH BUTTON TO CROSS CENTRAL AVENUE"). CLEAN EXISTING DRILLED HOLES WITH BRUSH AND SPRAY COLD GALVANIZING COMPOUND ON THE AFFECTED AREAS.
 - F. USE EXISTING STEEL PEDESTAL POLE. REMOVE EXISTING PEDESTRIAN SIGNAL HEADS AND PUSHBUTTONS. INSTALL COUNTDOWN PEDESTRIAN SIGNAL HEADS. CLEAN EXISTING DRILLED HOLES WITH BRUSH AND SPRAY COLD GALVANIZING COMPOUND ON THE AFFECTED AREAS.
 - G. USE EXISTING STEEL STRAIN POLE. INSTALL VIDEO DETECTION CAMERA MOUNTED ON STRAIN POLE.
 - H. USE EXISTING STEEL STRAIN POLE. REMOVE EXISTING PEDESTRIAN SIGNAL HEADS, PUSHBUTTON, AND R10-4(1) SIGN. INSTALL COUNTDOWN PEDESTRIAN SIGNAL HEAD AND VIDEO DETECTION CAMERAS MOUNTED ON STRAIN POLE. CLEAN EXISTING DRILLED HOLES WITH BRUSH AND SPRAY COLD GALVANIZING COMPOUND ON THE AFFECTED AREAS.
 - J. INSTALL CONCRETE FOUNDATION WITH 10 FT. STEEL PEDESTAL POLE WITH BREAKAWAY BASE. INSTALL COUNTDOWN PEDESTRIAN SIGNAL HEAD AND AUDIBLE/TACTILE PEDESTRIAN PUSHBUTTON INSTALLED WITH VIBRATING ARROW POINTING LEFT, R10-3(1) SIGN. (SIGN TO READ "PUSH BUTTON TO ADDISON ROAD"). (INSTALL 1-3 IN. SCHEDULE 80, 90 DEGREE PVC ELECTRICAL CONDUIT BEND IN PEDESTAL BASE).
 - K. INSTALL 1 IN. LIQUID-TIGHT FLEXIBLE NON-METALLIC ELECTRICAL CONDUIT. (FOR DETECTOR WIRE SLEEVE).
 - L. INSTALL 3 IN. PVC SCHEDULE 80 ELECTRICAL CONDUIT - TRENCHED.
 - M. INSTALL 4 IN. PVC SCHEDULE 80 ELECTRICAL CONDUIT - TRENCHED.
 - N. USE EXISTING BASE MOUNTED CONTROLLER AND CABINET. INSTALL AUDIBLE/TACTILE PEDESTRIAN PUSHBUTTON BASE UNIT. (INSTALL 1-4 IN. SCHEDULE 80 PVC CONDUIT BEND IN CABINET BASE) (NOTE: SHA FORCES SHALL RETROFIT CONTROLLER EQUIPMENT TO OPERATE VIDEO DETECTION EQUIPMENT).
 - O. USE EXISTING HANDHOLE.
 - P. USE EXISTING CONDUIT.
 - R. ABANDON EXISTING LOOP DETECTOR. DISCONNECT AND REMOVE LOOP DETECTOR CABLES FROM CONDUITS, HANDHOLES, SIGNAL STRUCTURES AND CONTROLLER.
 - S. ABANDON EXISTING MICROLOOP PROBE SET. DISCONNECT AND REMOVE MICROLOOP PROBE CABLES FROM CONDUITS, HANDHOLES, SIGNAL STRUCTURES AND CONTROLLER.
 - T. USE EXISTING STEEL STRAIN POLE. REMOVE EXISTING PEDESTRIAN SIGNAL HEADS, PUSHBUTTON, AND R10-4(1) SIGN. INSTALL COUNTDOWN PEDESTRIAN SIGNAL HEAD, AUDIBLE/TACTILE PEDESTRIAN PUSHBUTTON INSTALLED WITH VIBRATING ARROW POINTING RIGHT, R10-3(1) SIGN. (SIGN TO READ "PUSH BUTTON TO CROSS ADDISON ROAD"). CLEAN EXISTING DRILLED HOLES WITH BRUSH AND SPRAY COLD GALVANIZING COMPOUND ON THE AFFECTED AREAS.
 - U. INSTALL 4 IN. PVC SCHEDULE 80 ELECTRICAL CONDUIT - SITTED.
 - V. INSTALL 12 IN. HEAT APPLIED, WHITE PERMANENT PREFORMED THERMOPLASTIC PAVEMENT MARKING FOR CROSSWALKS.
 - W. INSTALL 24 IN. HEAT APPLIED, WHITE PERMANENT PREFORMED THERMOPLASTIC PAVEMENT MARKING FOR STRIPES.
 - X. INSTALL MICROLOOP PROBE SET WITH 1,000 FT. LEAD-IN (TO BE PLACED IN THRU LANE ONLY).
 - Y. USE EXISTING SPAN WIRE. INSTALL 1/4 IN. TETHER SPAN WIRE. (NOTE: BOTTOM TETHER TRAFFIC SIGNAL HEADS AND SIGNS).
 - Z. REMOVE EXISTING STEEL PEDESTAL POLE, PEDESTRIAN SIGNAL HEADS, AND PEDESTRIAN PUSHBUTTON. USE EXISTING PEDESTAL POLE FOUNDATION. INSTALL 10 FT. STEEL PEDESTAL POLE WITH BREAKAWAY BASE, COUNTDOWN PEDESTRIAN SIGNAL HEAD, AND AUDIBLE/TACTILE PEDESTRIAN PUSHBUTTON INSTALLED WITH VIBRATING ARROW POINTING RIGHT, AND R10-3(1) SIGN. (SIGN TO READ "PUSH BUTTON TO CROSS CENTRAL AVENUE").
 - AA. LOCATE EXISTING DIRECT BURY FIREHOUSE PUSHBUTTON COMMUNICATIONS CABLE. DISCONNECT AND REROUTE TO EXISTING HANDHOLE.

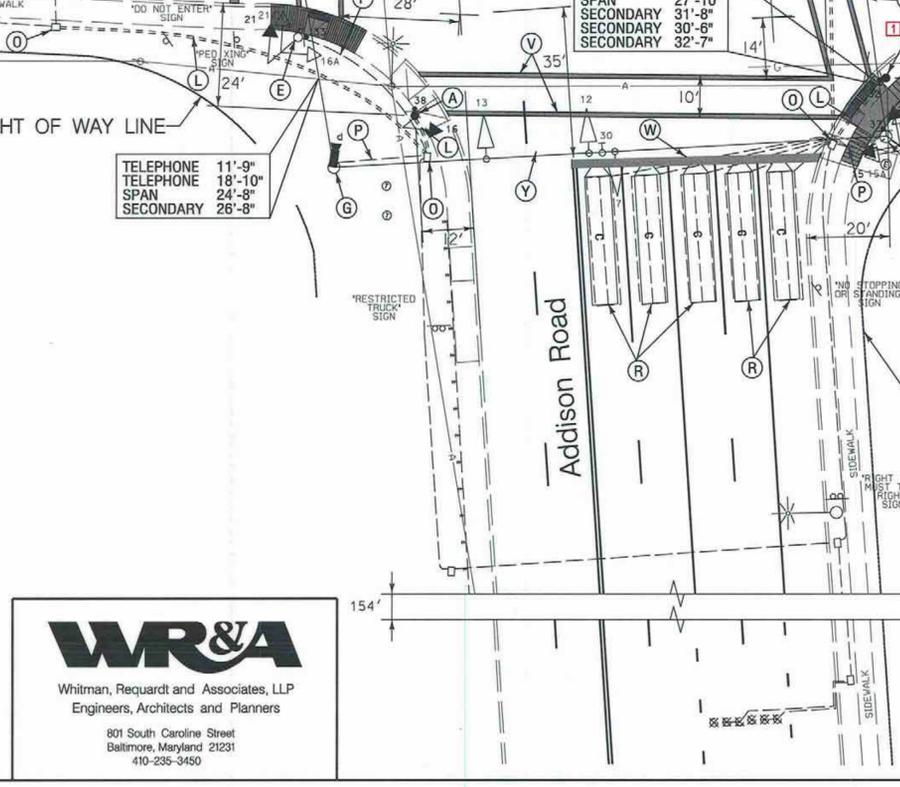

- GENERAL NOTES**
1. THE CONTRACTOR SHALL VERIFY ALL UNDERGROUND UTILITIES PRIOR TO INSTALLING PROPOSED SIGNAL EQUIPMENT. IF ANY UTILITY CONFLICTS SHOULD ARISE THE CONTRACTOR SHALL CONTACT THE PROJECT ENGINEER PRIOR TO INSTALLATION.
 2. VIDEO CAMERA LOCATION / ALIGNING SHALL BE COORDINATED WITH THE SHA ENGINEER.
 3. THE CONTRACTOR SHALL VERIFY ALL PROPOSED POLE AND CABINET LOCATIONS PRIOR TO INSTALLATION.
 4. ALL EXISTING TRAFFIC SIGNAL EQUIPMENT REMOVED SHALL BECOME THE PROPERTY OF THE SIGNAL CONTRACTOR UPON COMPLETION OF THE NEW SIGNAL.
 5. THE CONTRACTOR SHALL BE RESPONSIBLE FOR TERMINATING ALL SIGNAL CABLE TO THE APPROPRIATE TERMINALS AND PROPERLY LABEL EACH CABLE.
 6. REMOVE AND DISPOSE OF ALL UNUSED SIGNAL CABLE.
 7. PUSHBUTTONS ARE TO BE LOCATED SO THAT THEY CAN BE ACTIVATED BY A PERSON IN A WHEELCHAIR FROM A 60"x60" LEVEL LANDING AREA. A LEVEL LANDING AREA IS AN AREA WITH A CROSS SLOPE OF LESS THAN OR EQUAL TO 2%.
 8. PUSHBUTTON IS TO BE LOCATED SO THAT A PEDESTRIAN IN A WHEELCHAIR LOCATED ON THE LEVEL LANDING AREA, DOES NOT HAVE TO REACH MORE THAN 18 IN. THE 10' SEPARATION BETWEEN PUSHBUTTONS IS TO BE MEASURED FROM FACE OF PUSHBUTTON TO FACE OF PUSHBUTTON, NOT CENTER TO CENTER OF POLE.
 10. PUSHBUTTON ARROWS ARE TO BE PARALLEL TO THE CROSSING FOR WHICH THEY ARE INTENDED.
 11. LOCATION OF ACCESSIBLE PEDESTRIAN SIGNAL PUSHBUTTONS MUST MEET LOCATION REQUIREMENTS OF MUTCD SEC. 4E.09 AND FIG. 4E-02 AND THE LATEST EDITION OF THE NCHRP PUBLICATION, "ACCESSIBLE PEDESTRIAN SIGNALS: GUIDE TO BEST PRACTICE." IF NOT MET, THE CONTRACTOR IS TO STOP WORK UNTIL THE CONFLICT IS RESOLVED. IF NECESSARY, A WAIVER SHALL BE OBTAINED, SIGNED BY THE DIRECTOR, OFFICE OF TRAFFIC AND SAFETY.
 12. THE CONTRACTOR SHALL DELIVER APS CONTROL UNIT TO SHOP FOR TESTING AND PROGRAMMING.
 13. INSTALL CONDUIT AND LOOP DETECTORS PRIOR TO THE INSTALLATION OF PAVEMENT MARKINGS. REFER TO SIGNING AND PAVEMENT MARKING PLANS FOR ADDITIONAL DETAILS.
 14. VERIFY PROPOSED GEOMETRICS PRIOR TO INSTALLING SIGNAL EQUIPMENT.
 15. THE CONTRACTOR SHALL REPAIR ANY DAMAGE TO EXISTING SIDEWALKS CAUSED BY THE INSTALLATION OF SIGNAL EQUIPMENT.

WR&A

Whitman, Requardt and Associates, LLP
Engineers, Architects and Planners

801 South Caroline Street
Baltimore, Maryland 21201
410-235-3450

APPROVALS

TEAM LEADER _____

ASST. DIR. CHIEF _____

DIRECTOR CHIEF _____

OFFICE DIRECTOR _____

REVISIONS

2 REDLINE REVISION NO. 2
REVISE CONDUIT RUN
MARCH 17, 2009

1 REDLINE REVISION NO. 1
PEDESTRIAN POLE RELOCATION
SEPTEMBER 15, 2008

1 INSTALLED COUNTDOWN AND AUDIBLE PEDESTRIAN SIGNALS
CONTRACT NO. PG5695177 3/12/07

SIGNALIZATION PLAN

STATE OF MARYLAND
DEPARTMENT OF TRANSPORTATION
STATE HIGHWAY ADMINISTRATION

OFFICE OF TRAFFIC & SAFETY
TRAFFIC ENGINEERING DESIGN DIVISION

MD 214 (Central Avenue) and Addison Road
Seat Pleasant, Maryland

SCALE 1" = 20' DATE 8/7/82 CONTRACT NO. BW96382

DESIGNED BY _____ COUNTY PRINCE GEORGES

DRAWN BY J. HOYAS LOGMILE 16021400.87

CHECKED BY S. RENZI TMS NO. 1528

FAP NO. SEE TITLE SHEET TOD NO. _____

TS NOTS-25G-GI DRAWING TSP-3 OF TSP-5 SHEET NO. ### OF ###