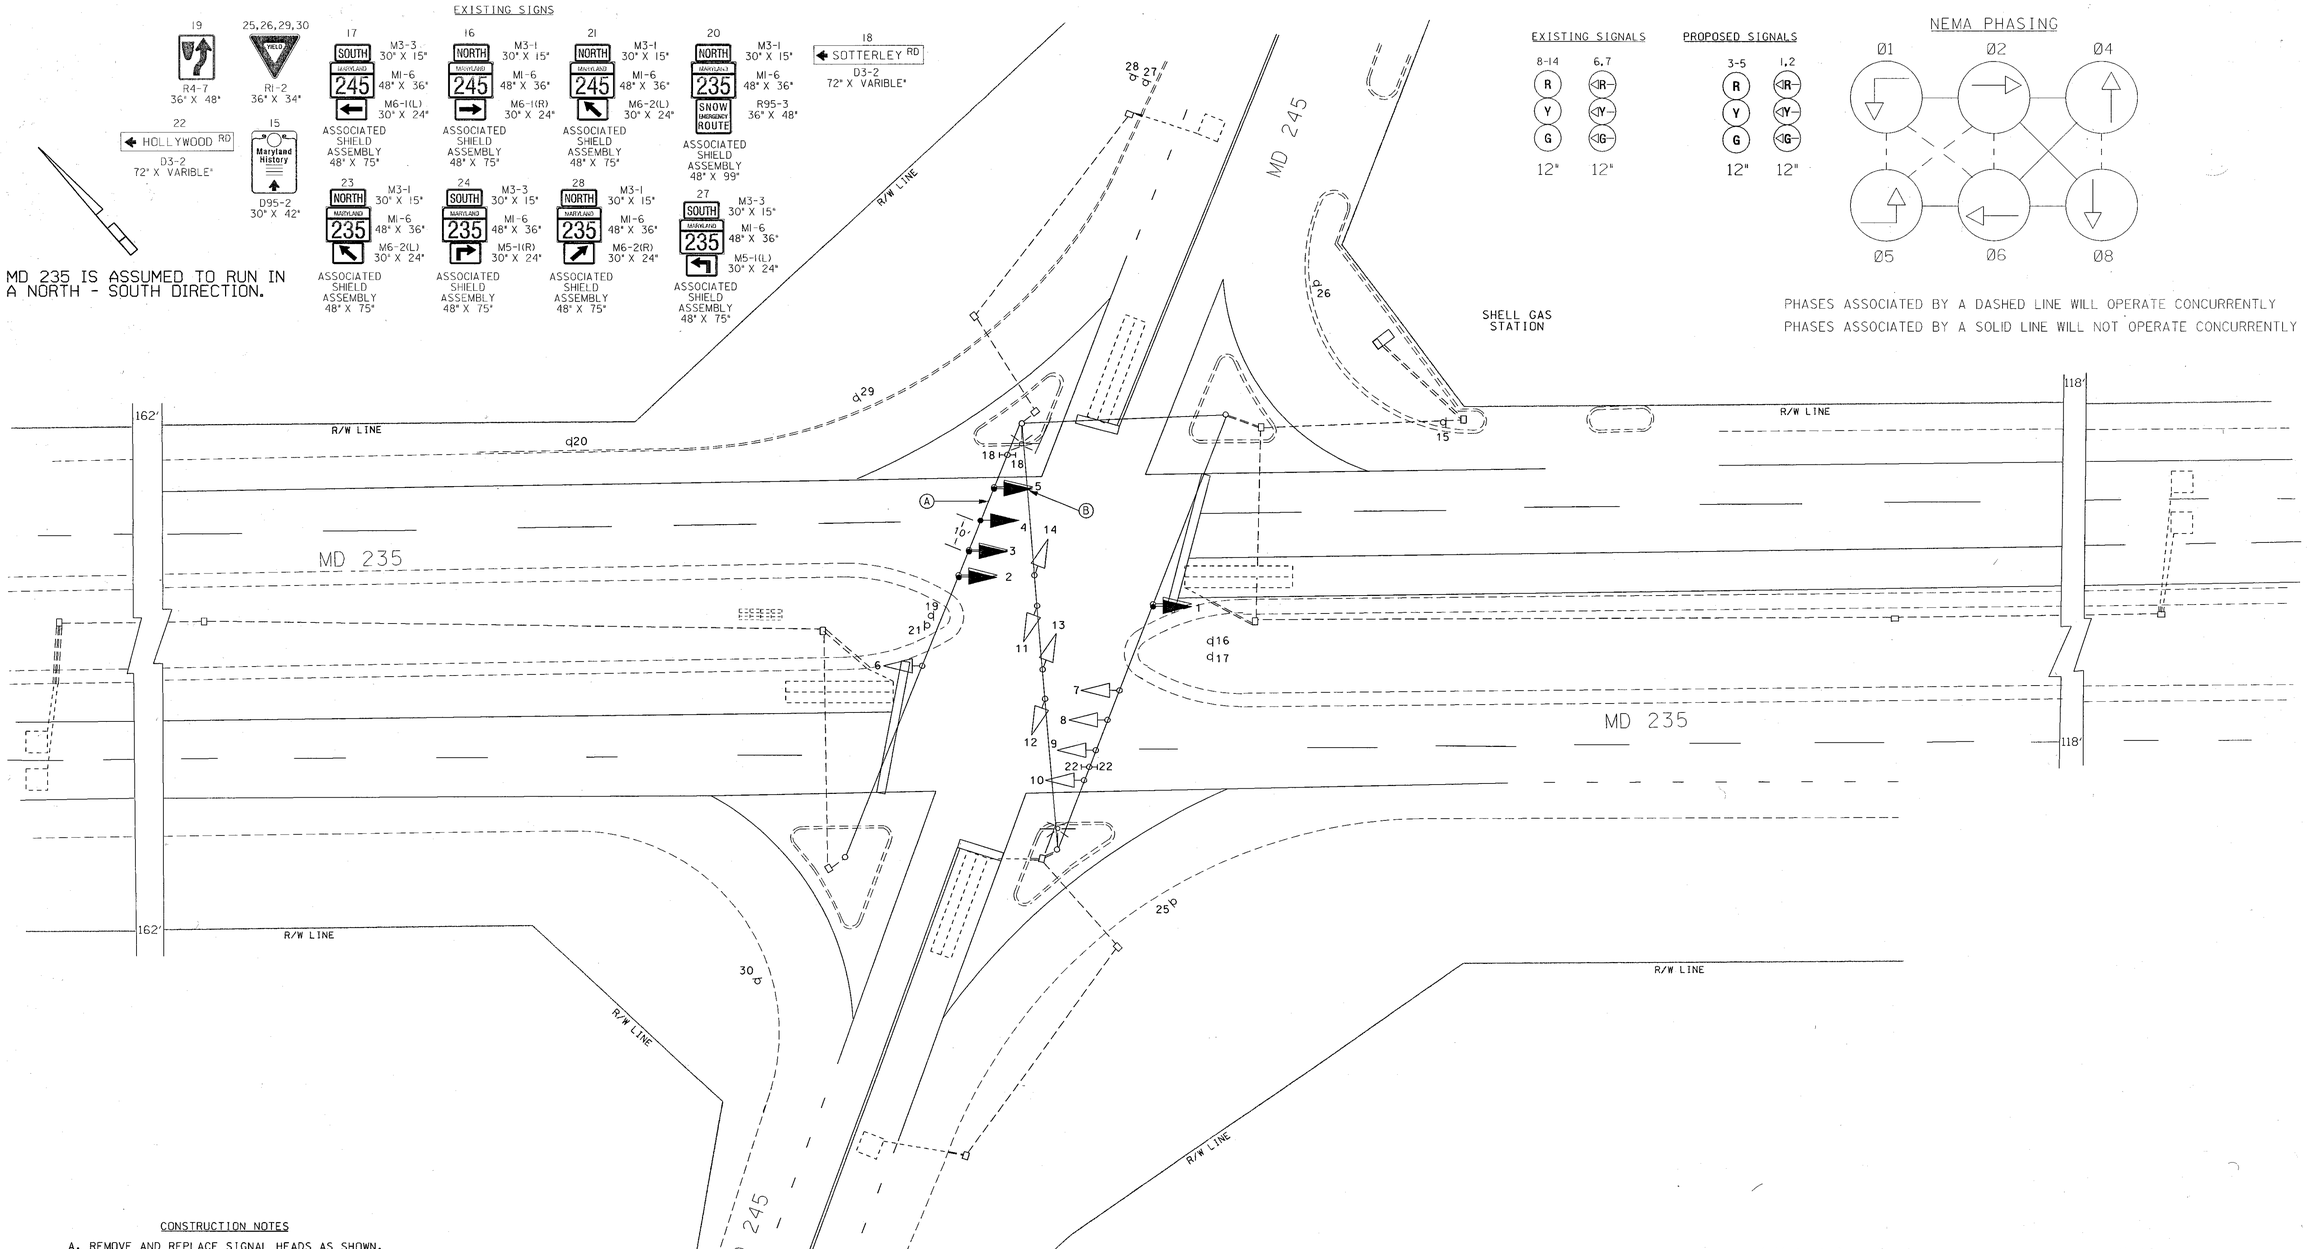

CONSTRUCTION NOTES

A. REMOVE AND REPLACE SIGNAL HEADS AS SHOWN.

B. INSTALL NEW SIGNAL HEAD AS SHOWN.

SHA#:SM100SF010B010 TOD#:XDLCG54-48

REVISIONS	APPROVALS
	ORIGINAL TEAM LEADER, TRAFFIC ENGINEERING DESIGN DIVISION
	ASST. CHIEF TRAFFIC ENGINEERING DESIGN DIVISION
ⓑ 4/2004 INSTALL ADDITIONAL SIGNAL HEAD IN NB DIRECTION AND REPLACE EXISTING SIGNAL HEADS WITH BLACK FACES. CJW	ON CHIEF, TRAFFIC ENGINEERING DESIGN DIVISION
C 4/1982 REDRAW TO SHOW EXISTING GEOMETRICS. TMZ	FILE DIRECTOR, TRAFFIC & SAFETY

MARYLAND DOT - STATE HIGHWAY ADMINISTRATION

Office of Traffic & Safety

TRAFFIC ENGINEERING DESIGN DIVISION

MD 235 & MD 245

DRAWN BY:	THOMAS ZAYDEL	F.A.P. NO.		TS NO. 996D	SHEET NO.
CHECKED BY:		S.H.A. NO.	SM 414-026-570		
SCALE:	1"=20'	COUNTY:	SAINT MARY'S	T.I.M.S. NO. 0063	1 OF 2
DATE:	APRIL, 1982	LOG MILE:	18023520.78		