F.H.WA. REGION NO.	STATE	FED. AID PROJ. NO.	SHEET NO.	TOTAL SHEETS
3	MD.		2	7

NOTE (1) STRIPING & STOP BARS SHOWN ARE PROPOSED

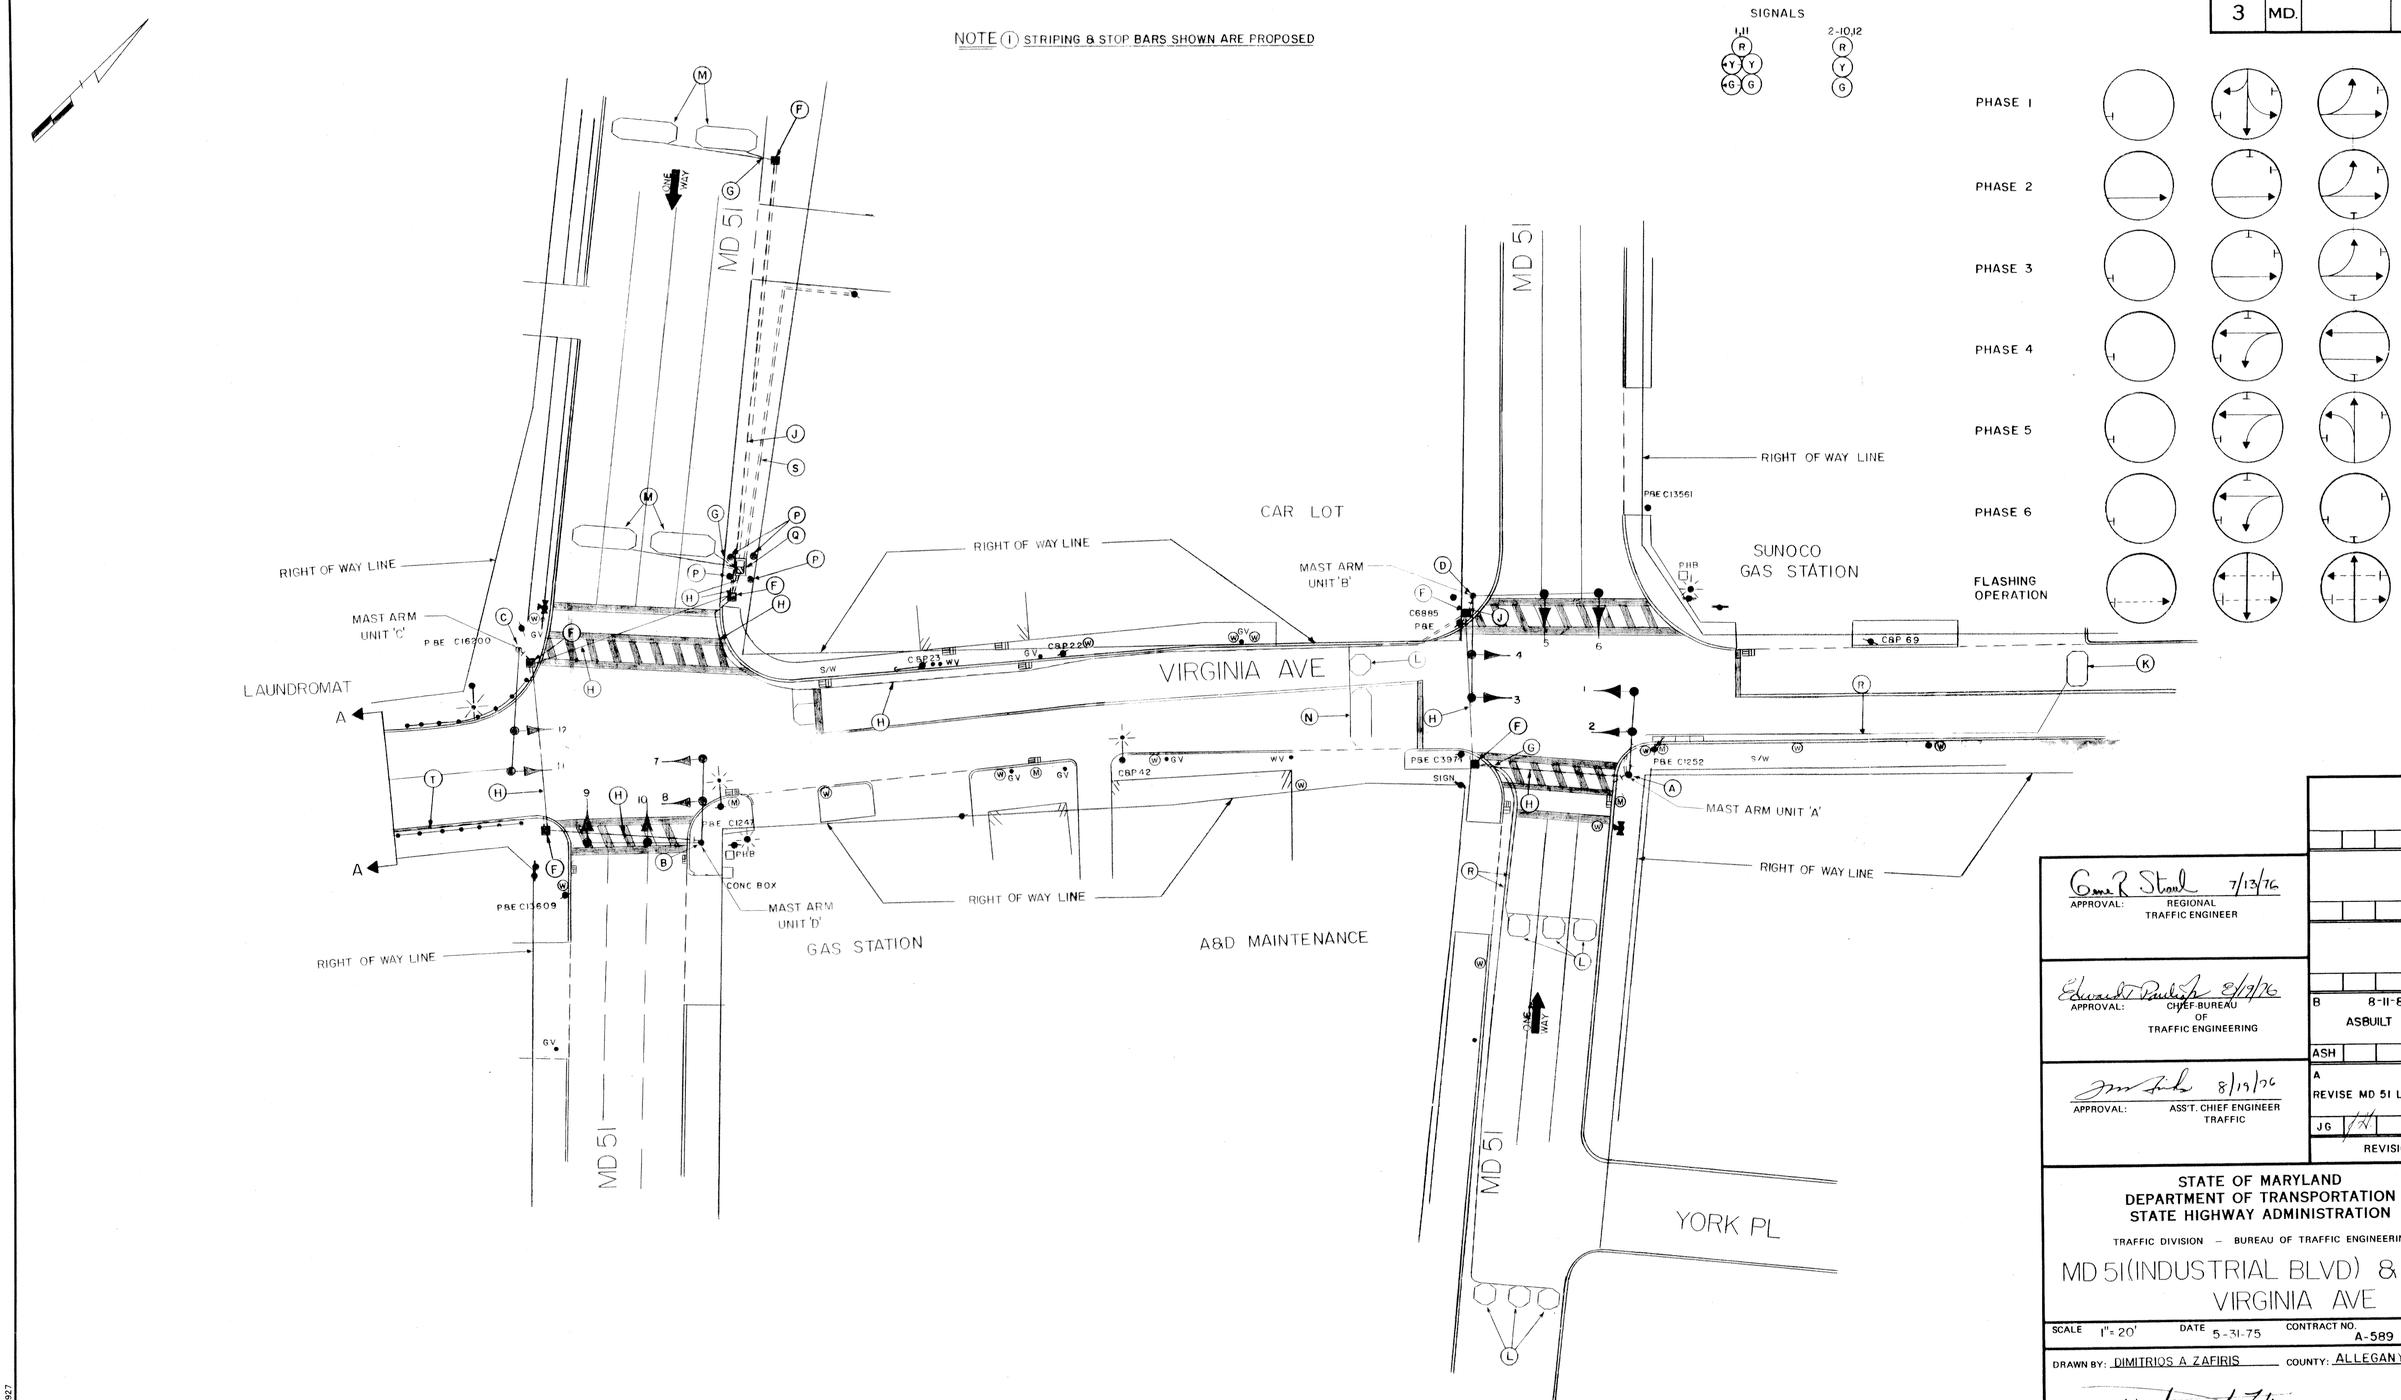

APPROVAL: REGIONAL TRAFFIC ENGINEER 7/13/76

APPROVAL: CHIEF-BUREAU OF TRAFFIC ENGINEERING 8/19/76

APPROVAL: ASS'T. CHIEF ENGINEER TRAFFIC 8/19/76

B 8-11-83 ASBUILT

ASH

A 4-10-78 REVISE MD 51 LOOP DET.

JG

REVISIONS

STATE OF MARYLAND
DEPARTMENT OF TRANSPORTATION
STATE HIGHWAY ADMINISTRATION

TRAFFIC DIVISION – BUREAU OF TRAFFIC ENGINEERING

MD 51 (INDUSTRIAL BLVD) & VIRGINIA AVE

SCALE 1" = 20' DATE 5-31-75 CONTRACT NO. A-589-501-685

DRAWN BY: DIMITRIOS A ZAFIRIS COUNTY: ALLEGANY

DESIGNED BY: SIGNAL NO.:

CHECKED BY: A. Budnichuk

DRAWING NO. TS-499 B

~~EAST 01005101.24 / WEST 01005101.24~~

01005101.24

BRUNING 44-511 19927