K&E BALTIMORE 17 0193 PHOENIX 10-76 MC 4186

| F.H.W.A. REGION NO. | STATE | FED. AID PROJ. NO. | SHEET NO. | SHEETS |
|---|---|---|---|---|
| 3 | MD. | | 2 | 5 |

NOTE: (1) STRIPING AND STOP BAR SHOWN ARE PROPOSED

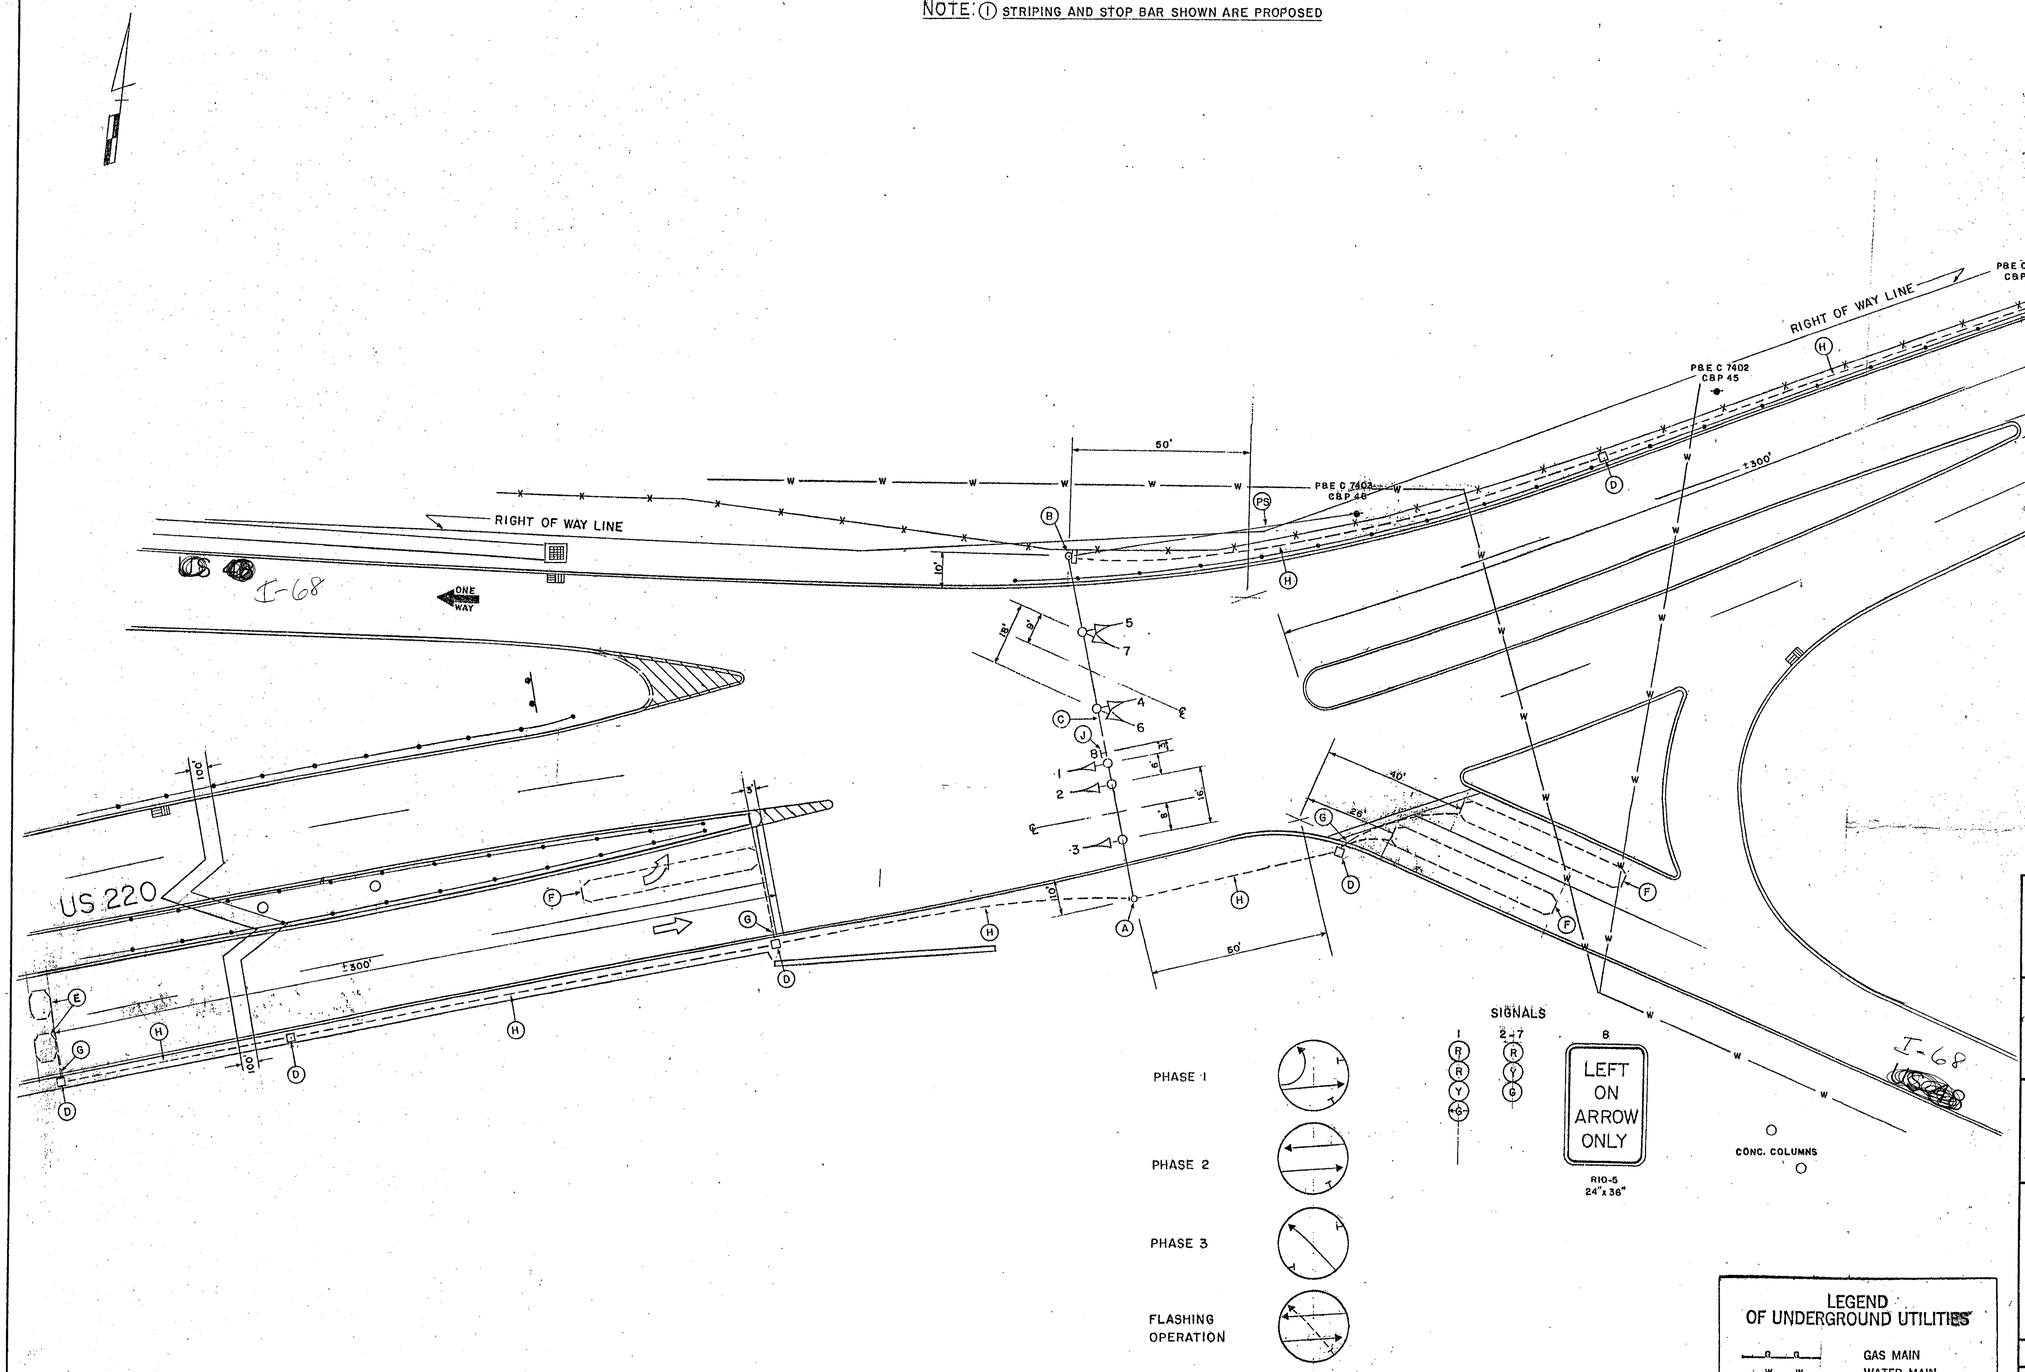


LEGEND OF UNDERGROUND UTILITIES

| | |
|---|---|
| G G | GAS MAIN |
| W W | WATER MAIN |
| S S | SEWER MAIN |
| E E | ELECTRIC CABLES |
| T T | TELEPHONE CABLES |
| A A | AERIAL CABLES |

APPROVAL: REGIONAL TRAFFIC ENGINEER

APPROVAL: CHIEF BUREAU OF TRAFFIC ENGINEERING — 9/17/78

APPROVAL: ASS'T. CHIEF ENGINEER TRAFFIC — 9/17/78

REVISIONS

STATE OF MARYLAND
DEPARTMENT OF TRANSPORTATION
STATE HIGHWAY ADMINISTRATION

TRAFFIC DIVISION – BUREAU OF TRAFFIC ENGINEERING

I 68 RAMP

US 220 & (US 48) OLD

SURVEY BK. #19218

| SCALE | DATE | CONTRACT NO. |
|---|---|---|
| 1" = 20' | 4-78 | A-617-501-685 |

DRAWN BY: JS J GORDON COUNTY: ALLEGANY

DESIGNED BY: J Gordon U.E. SIGNAL NO.:

CHECKED BY: 9/6/78

DRAWING NO. TS-1566

01 0220 18 70