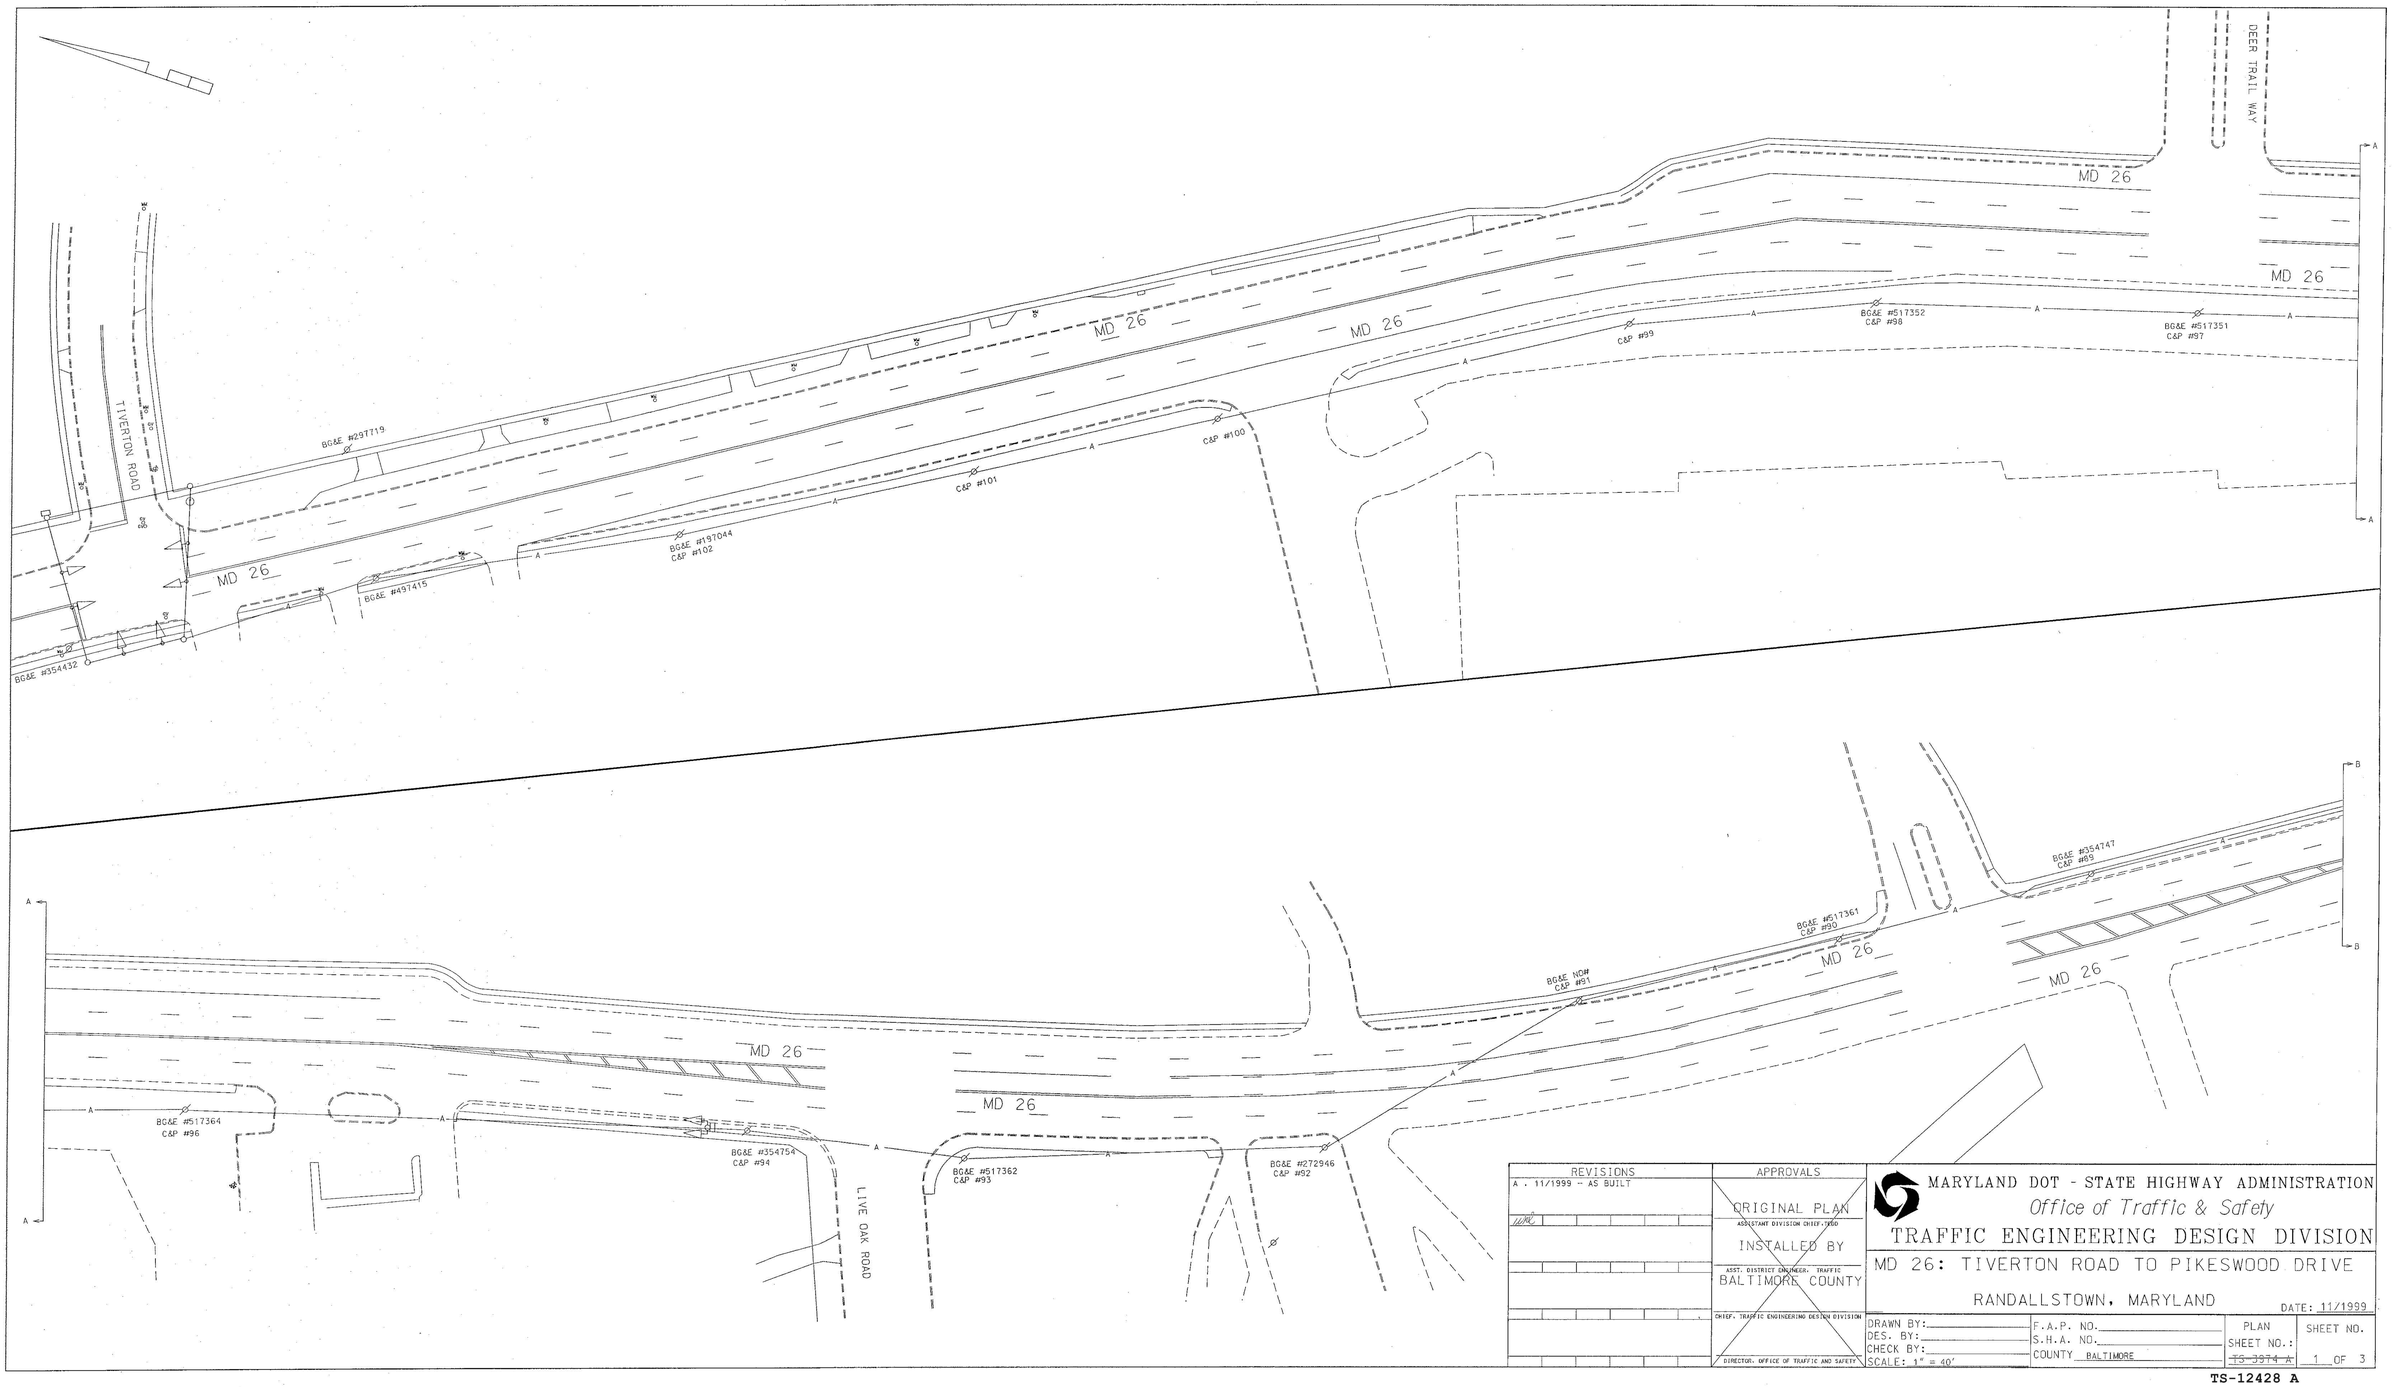

REVISIONS	APPROVALS
A . 11/1999 -- AS BUILT	ORIGINAL PLAN ASSISTANT DIVISION CHIEF, TSD INSTALLED BY ASST. DISTRICT ENGINEER, TRAFFIC BALTIMORE COUNTY CHIEF, TRAFFIC ENGINEERING DESIGN DIVISION DIRECTOR, OFFICE OF TRAFFIC AND SAFETY

MARYLAND DOT - STATE HIGHWAY ADMINISTRATION

Office of Traffic & Safety

TRAFFIC ENGINEERING DESIGN DIVISION

MD 26: TIVERTON ROAD TO PIKESWOOD DRIVE

RANDALLSTOWN, MARYLAND

DATE: 11/1999

DRAWN BY:	F.A.P. NO.	PLAN SHEET NO.: ~~TS-3974-A~~	SHEET NO. 1 OF 3
DES. BY:	S.H.A. NO.		
CHECK BY:	COUNTY BALTIMORE		
SCALE: 1" = 40'			

TS-12428 A