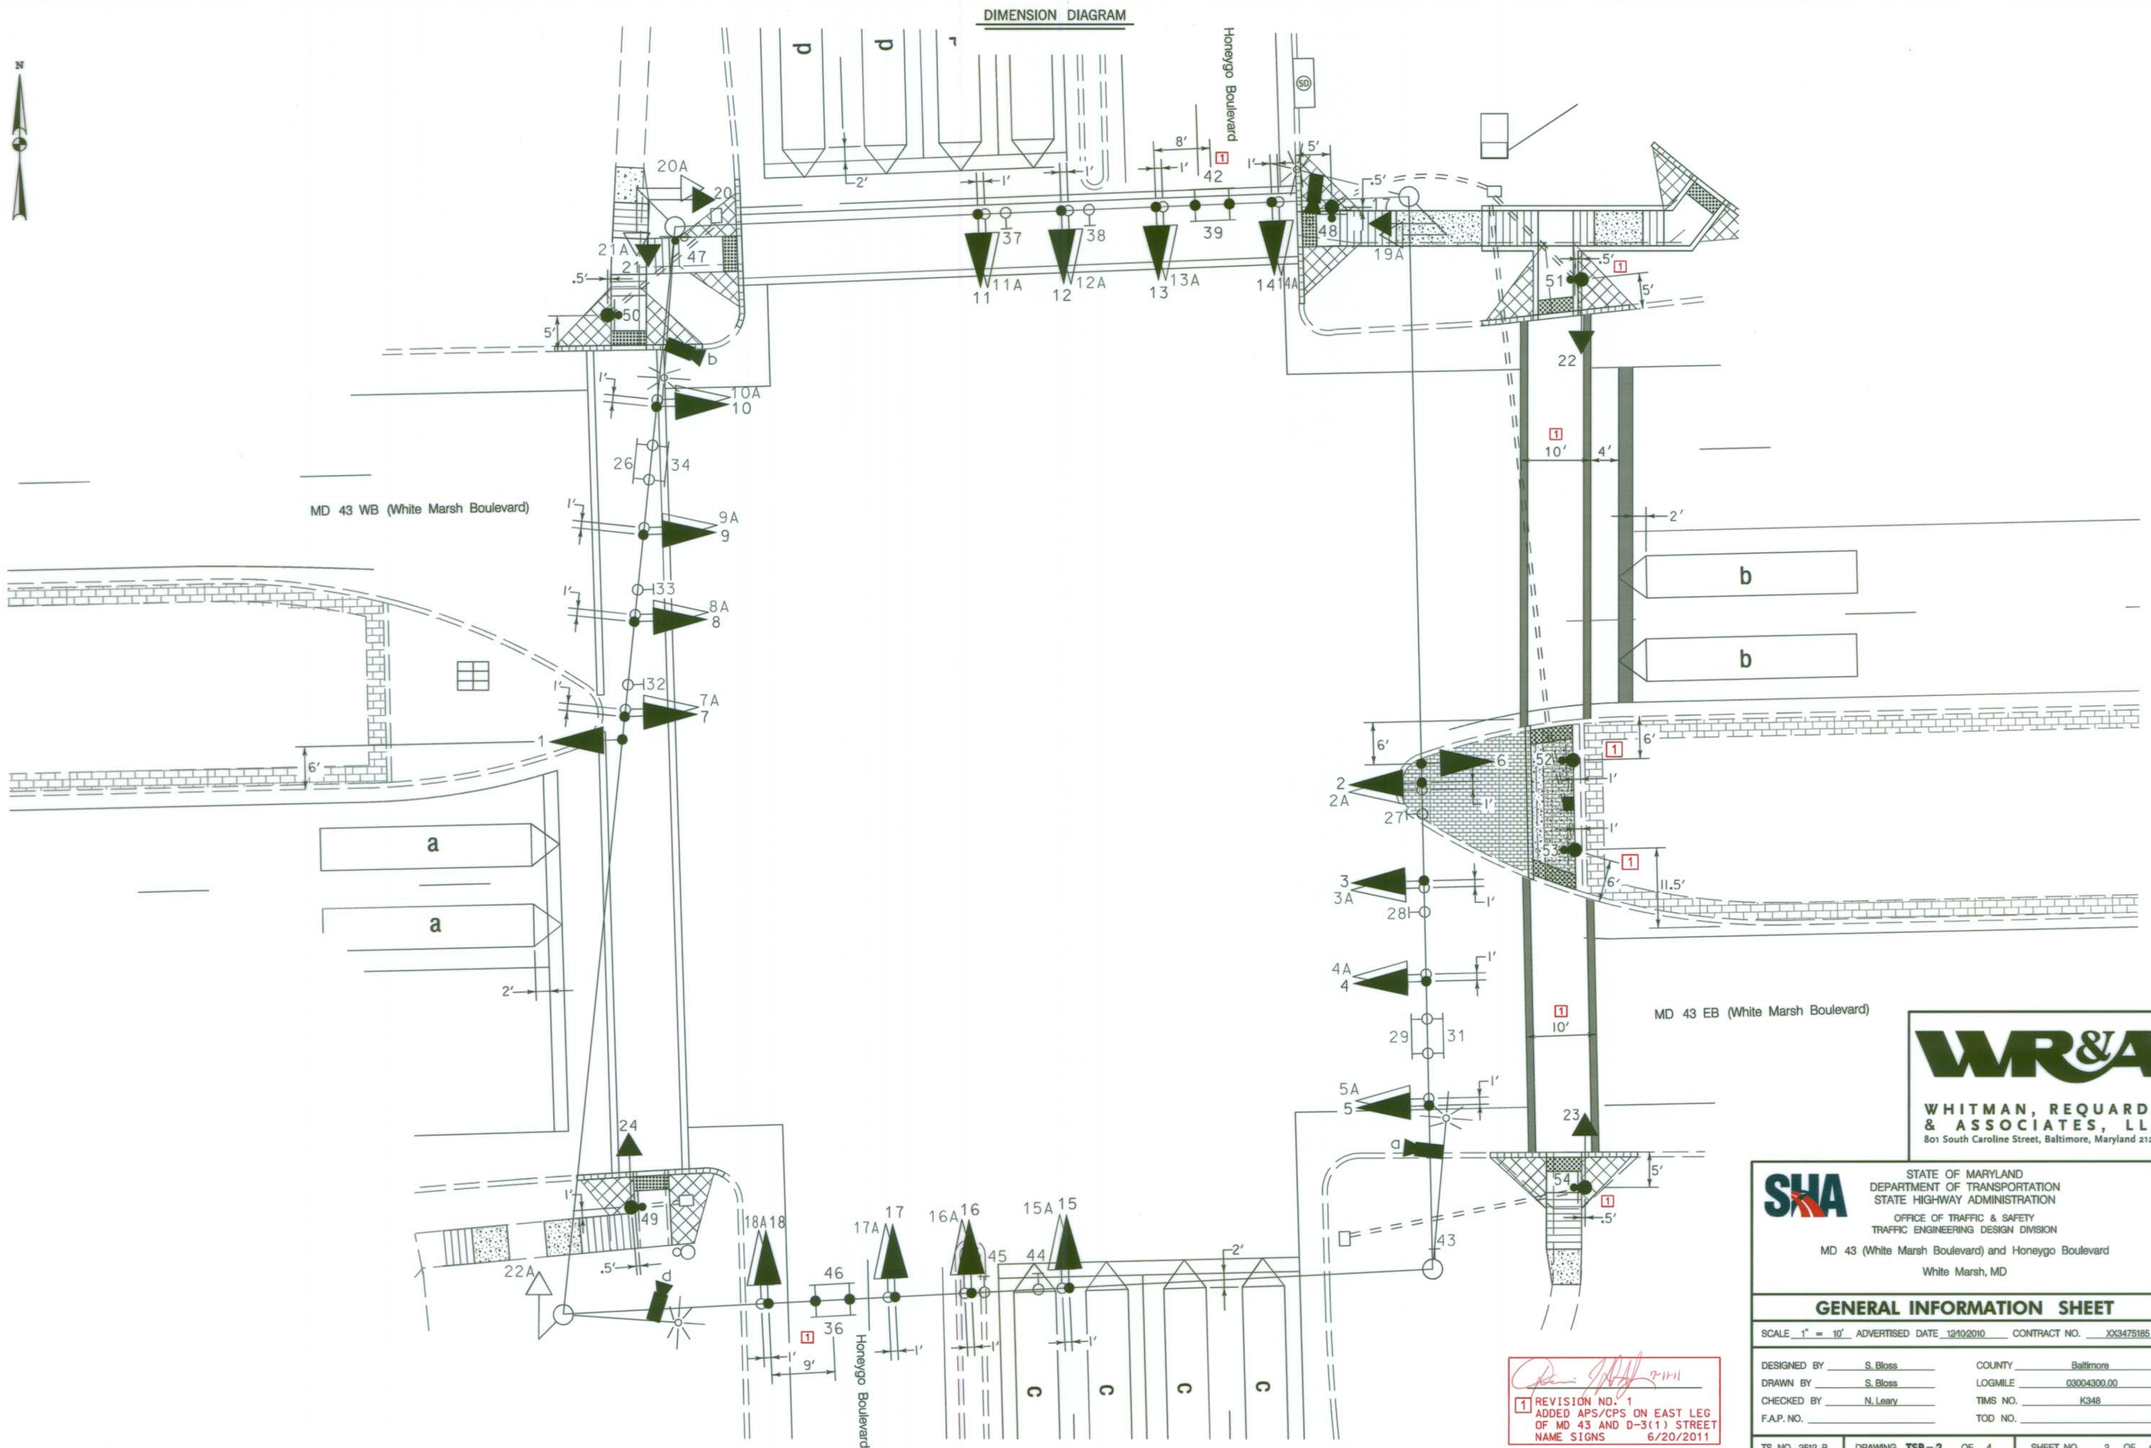

1 REVISION NO. 1
ADDED APS/CPS ON EAST LEG
OF MD 43 AND D-3(1) STREET
NAME SIGNS 6/20/2011

WR&A
WHITMAN, REQUARDT & ASSOCIATES, LLP
801 South Caroline Street, Baltimore, Maryland 21231

SHA
STATE OF MARYLAND
DEPARTMENT OF TRANSPORTATION
STATE HIGHWAY ADMINISTRATION
OFFICE OF TRAFFIC & SAFETY
TRAFFIC ENGINEERING DESIGN DIVISION

MD 43 (White Marsh Boulevard) and Honeygo Boulevard
White Marsh, MD

GENERAL INFORMATION SHEET

SCALE 1" = 10' ADVERTISED DATE 12/10/2010 CONTRACT NO. XX3475185

DESIGNED BY	S. Bloss	COUNTY	Baltimore
DRAWN BY	S. Bloss	LOGMILE	03004300.00
CHECKED BY	N. Leary	TIMS NO.	K348
F.A.P. NO.		TOD NO.	

TS NO. 2512 B	DRAWING TSP-2 OF 4	SHEET NO. 2 OF 4

PLOTTED: Friday, July 08, 2011 AT 03:49 PM
FILE: N:\31669-077\CADD\Redline\pSG-N002_md43_RL1.dgn

BY: sbloss