PHASE A	G	G	R	R	G	G
A YELLOW	Y	Y	R	R	Y	Y
PHASE B	R	R	G	G	R	R
B YELLOW	R	R	Y	Y	R	R
FLASHING OPERATION	FL/Y	FL/Y	FL/R	FL/R	FL/Y	FL/Y

PHASE CHART

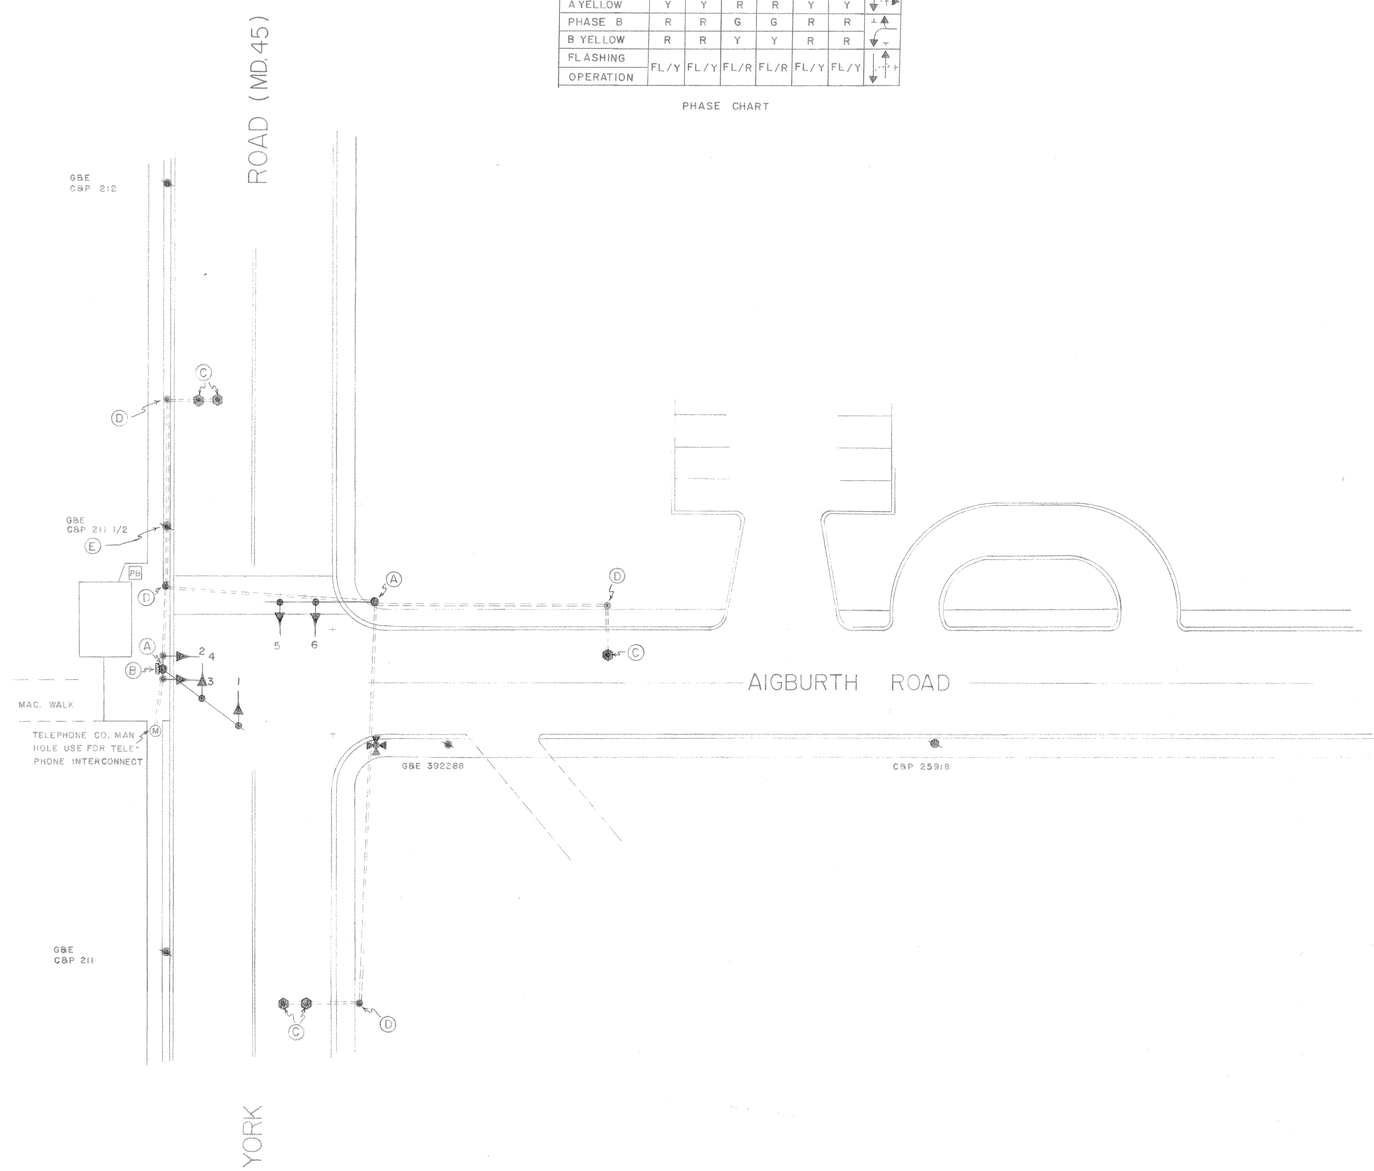

LEGEND		QUANTITY
A	20' MONOLEVER POLE WITH A 28' MAST ARM	2
B	TYPE "G" CABINET WITH A 1826 CONTROLLER	1
C	TRANSENSOR DETECTOR	5
D	SPLICE BOX	4
E	EXISTING FEED	

A	9-2-7
AS BUILT	

REVISIONS

APPROVAL: CHIEF - BUREAU OF TRAFFIC ENGINEERING

APPROVAL: ASS'T CHIEF ENGINEER TRAFFIC SAFETY

MARYLAND STATE ROADS COMMISSION
DIVISION OF TRAFFIC SAFETY
BUREAU OF TRAFFIC ENGINEERING

YORK ROAD (MD. 45) & AIGBURTH ROAD
SIGNAL NO 03234

DATE
SCALE 1" = 20'
DRAWN BY: Wm. MUNK
CONTRACT NO B-120X-475
COUNTY BALTIMORE
CHECKED BY:

DRAWING NO. TS-159A