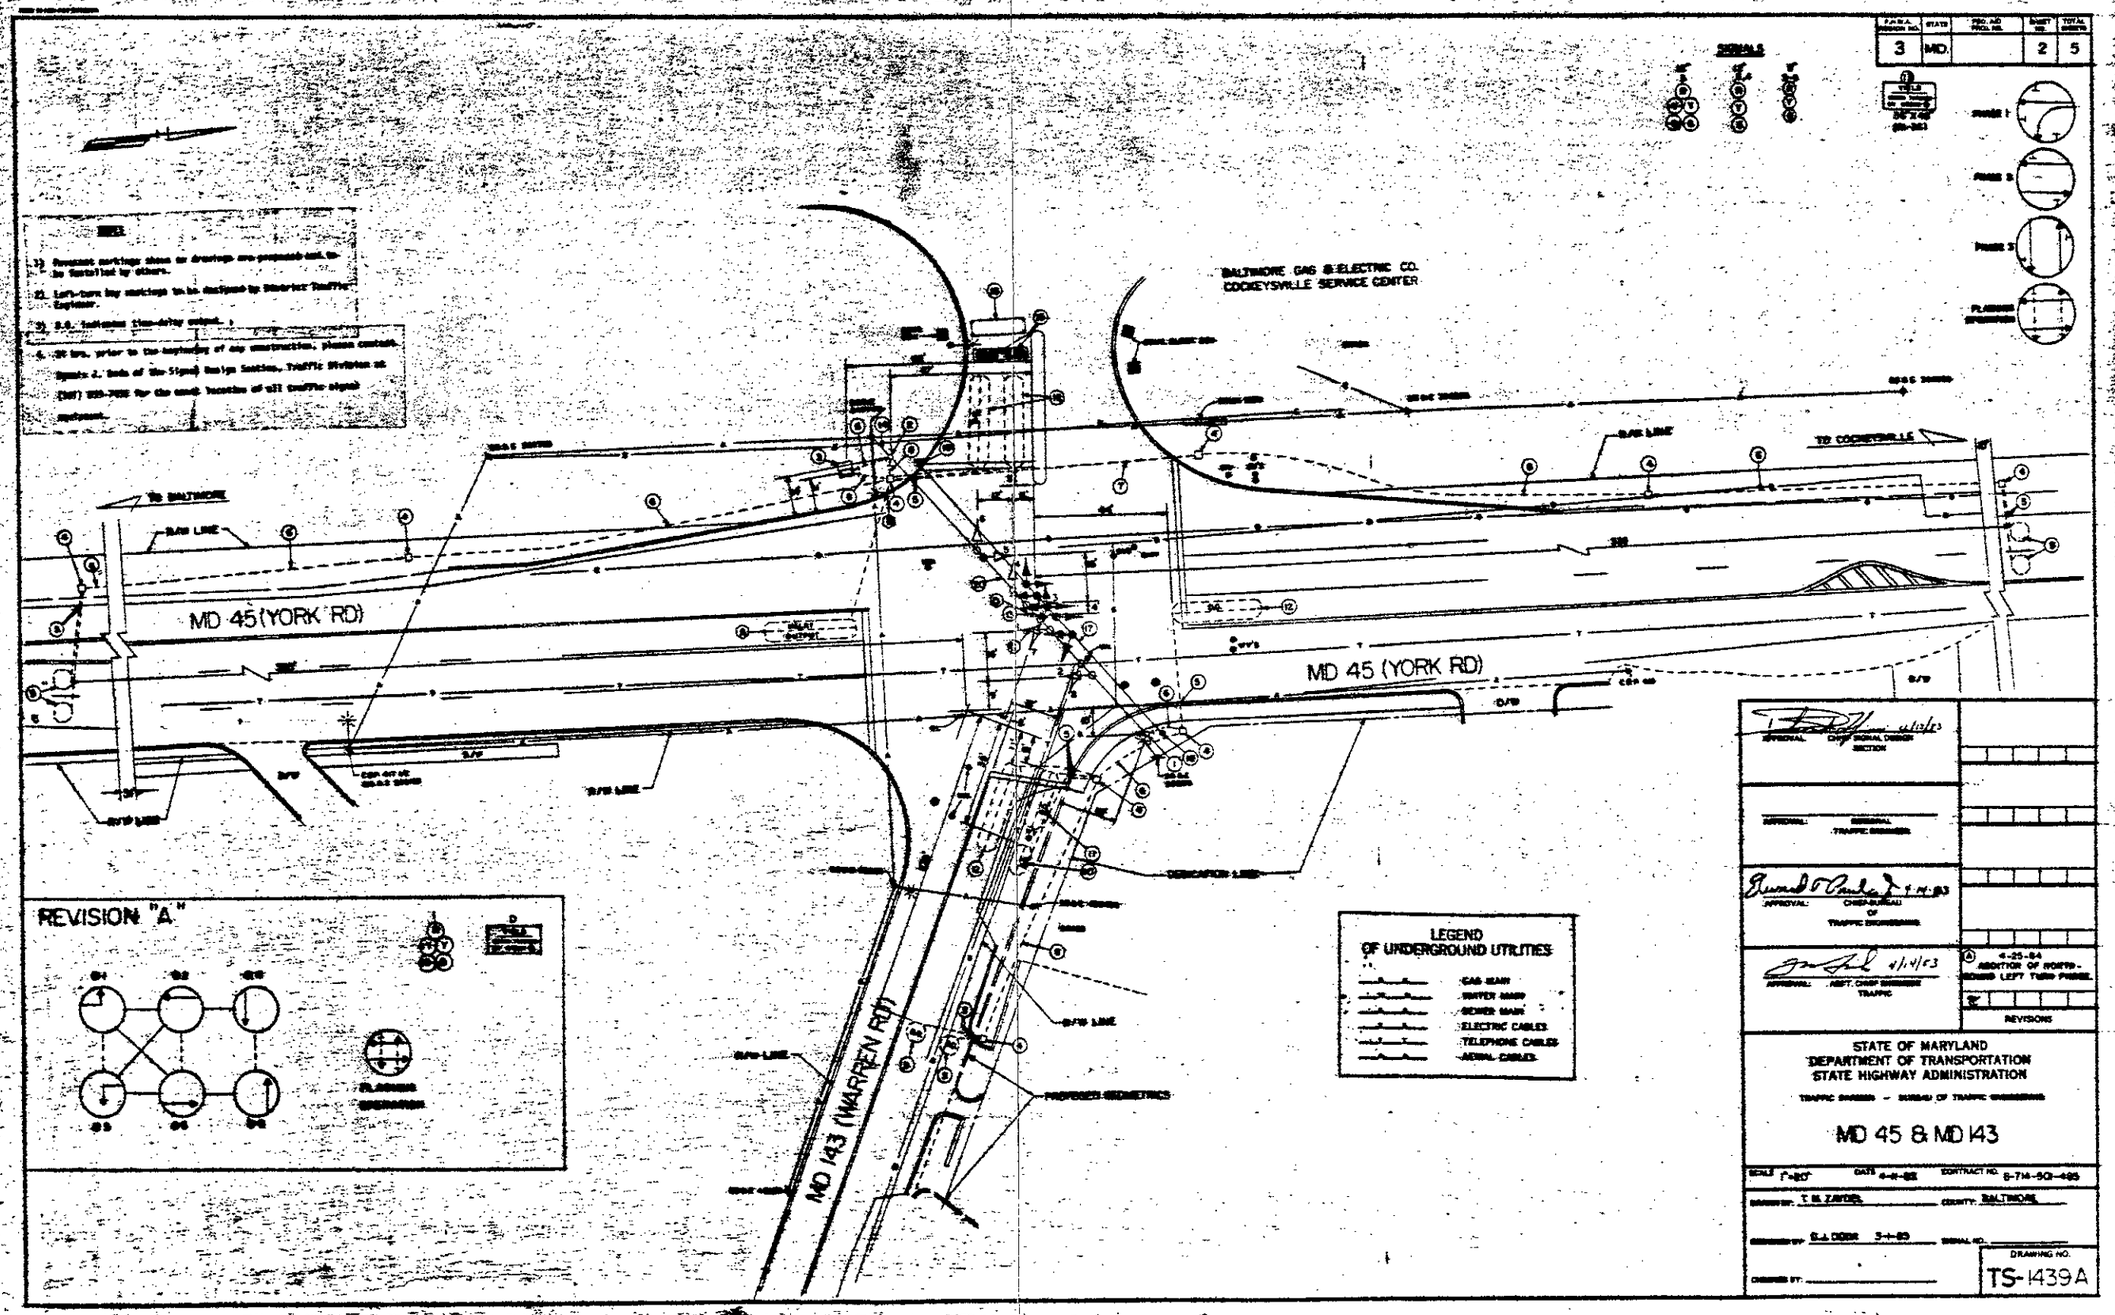

3
MD.
2
5
SIGNALS
BALTIMORE GAS & ELECTRIC CO.
COCKEYSVILLE SERVICE CENTER
TO BALTIMORE
TO COCKEYSVILLE
MD 45 (YORK RD)
MD 45 (YORK RD)
MD 143 (WARREN RD)
REVISION "A"
LEGEND
OF UNDERGROUND UTILITIES
GAS MAIN
WATER MAIN
SEWER MAIN
ELECTRIC CABLES
TELEPHONE CABLES
AERIAL CABLES
PROPOSED GEOMETRICS
APPROVAL: CHIEF SIGNAL DESIGN SECTION
APPROVAL: SIGNAL TRAFFIC ENGINEER
APPROVAL: CHIEF-BUREAU OF TRAFFIC ENGINEERING
APPROVAL: ASST. CHIEF ENGINEER TRAFFIC
4-25-84
ADDITION OF NORTH-BOUND LEFT TURN PHASE
REVISIONS
STATE OF MARYLAND
DEPARTMENT OF TRANSPORTATION
STATE HIGHWAY ADMINISTRATION
MD 45 & MD 143
SCALE 1"=20'
DATE 4-11-83
CONTRACT NO. 8-714-501-495
DRAWN BY: T. M. ZAYDEL
COUNTY: BALTIMORE
DESIGNED BY: G. J. DOBR 3-1-83
SIGNAL NO.
CHECKED BY:
DRAWING NO.
TS-1439A