| FHWA REGION NO. | STATE | FED. AID PROJ. NO. | SHEET NO. | TOTAL SHEETS |
|---|---|---|---|---|
| 3 | MD | | | |

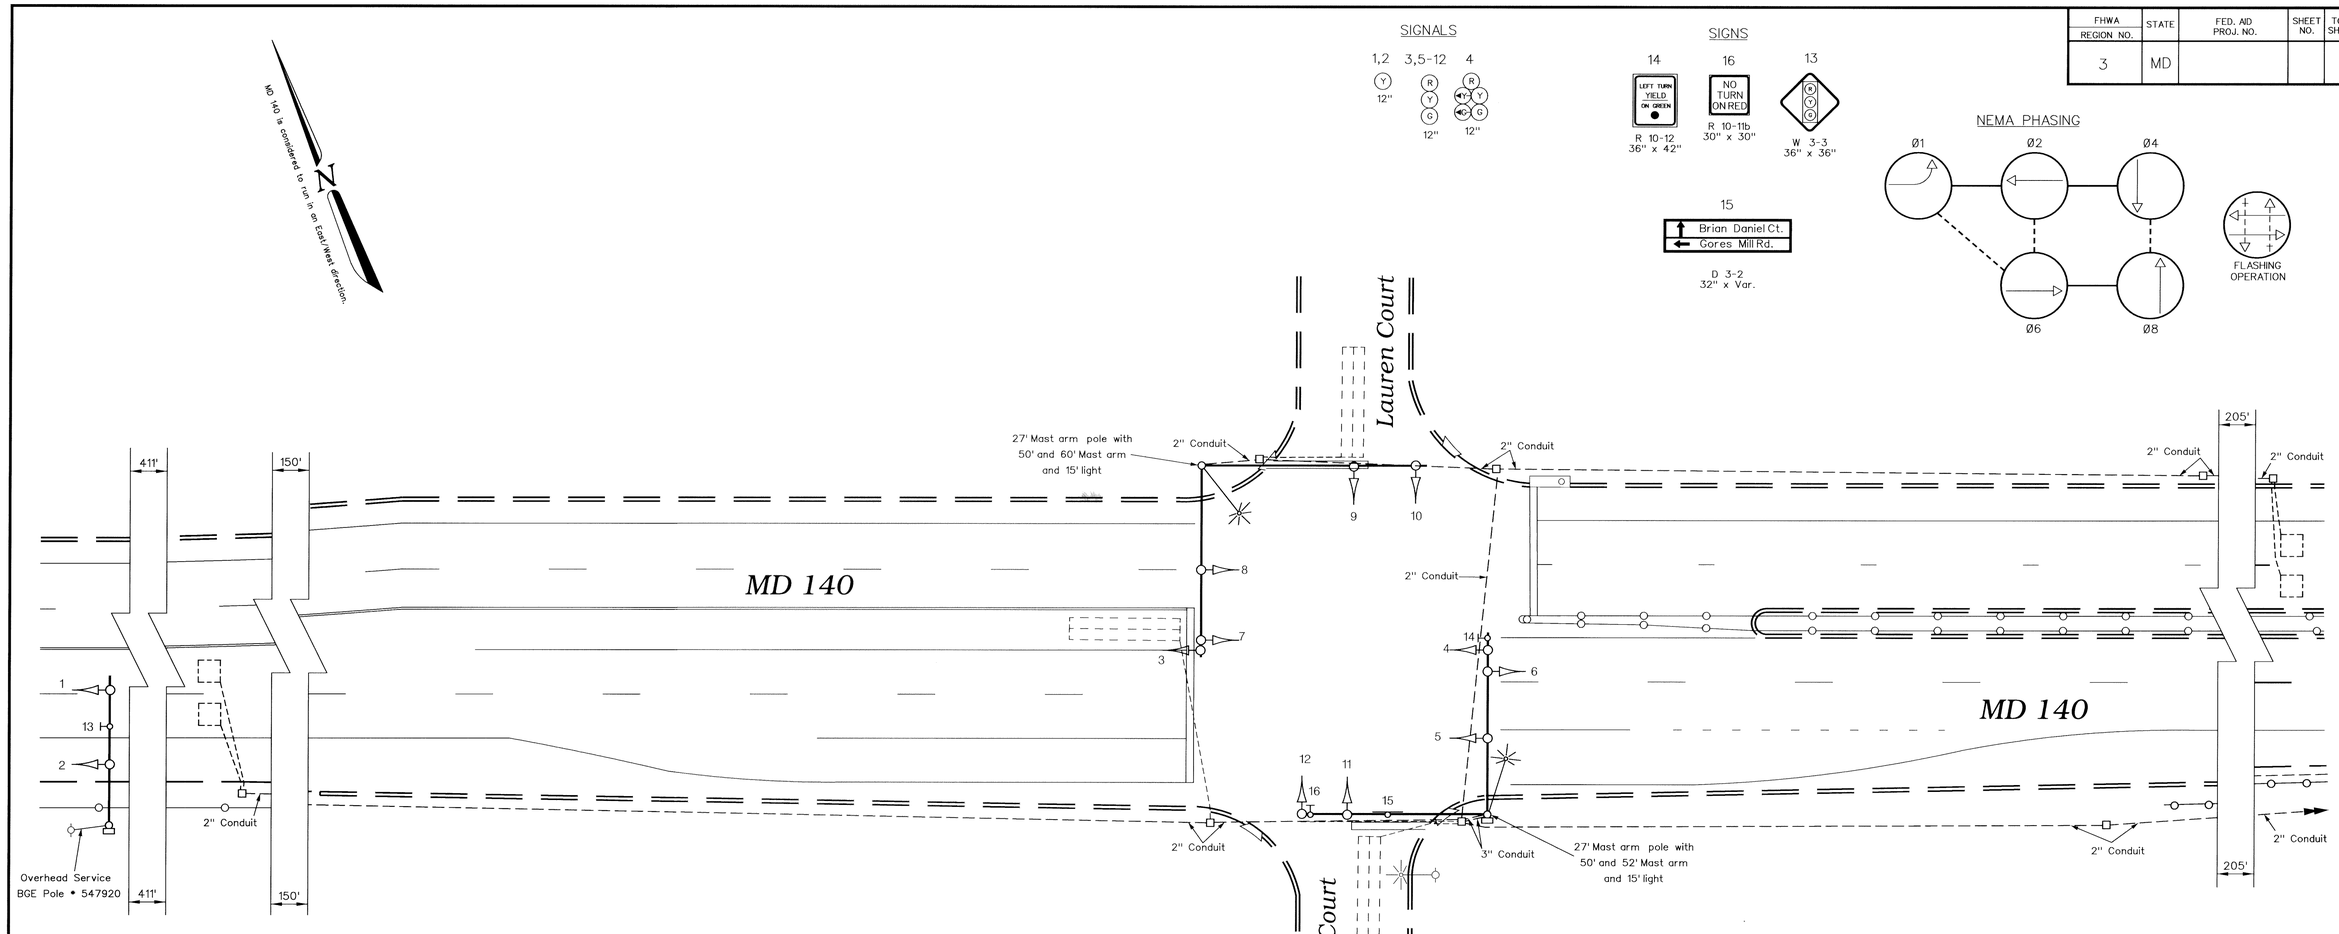


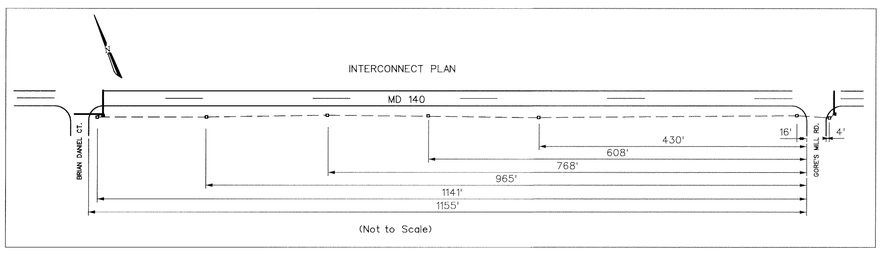


"AS-BUILT"


The Traffic Group
The Traffic Group, Inc.
Suite 600
40 W. Chesapeake Avenue
Towson, Maryland 21204
410-583-8405
1-800-583-8411
Fax 410-321-8458
Job. No. 960705
ASBUILT.DGN


GEOMETRIC LEGEND

EXISTING GEOMETRICS
PROPOSED GEOMETRICS

UTILITY LEGEND

| | |
|---|---|
| G | GAS MAIN |
| W | WATER MAIN |
| S | SEWER MAIN |
| E | ELECTRIC CABLES |
| D | STORM DRAIN |
| A | AERIAL CABLES |
| T | TELEPHONE CABLES |

REVISIONS

© ASBUILT September 13, 1996
S.H.A. No.:855-25057061
FJH

APPROVALS

ASST. DIVISION CHIEF TRAFFIC ENGINEERING DESIGN DIVISION
CHIEF, TRAFFIC ENGINEERING DESIGN DIVISION
ASST. DISTRICT ENGINEER - TRAFFIC
DIRECTOR, OFFICE OF TRAFFIC & SAFETY
ORIGINAL ON FILE

MDOT – STATE HIGHWAY ADMINISTRATION
*Office of Traffic & Safety*
TRAFFIC ENGINEERING DESIGN DIVISION

DRAWN BY: G. Simmers
DES. BY: G. Simmers
CHK. BY:

(Traffic Signal Plan)
# MD 140 at Brian Daniel Court/ Lauren Court

COUNTY: BALTIMORE
LOG MILE • 031450011.60

DATE: April 30, 1996
SCALE: 1" = 20'
F.A.P. NO. N/A
S.H.A. NO.
TS/STD. NO. 3629
SHEET NO. 1 of 1