

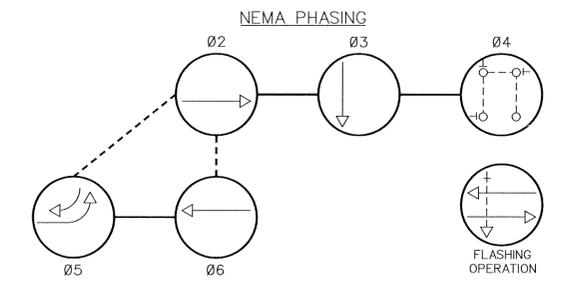


FHWA REGION NO.	STATE	FED. AID PROJ. NO.	SHEET NO.	TOTAL SHEETS
3	MD			

MD 140 is considered to run in a North/South direction.

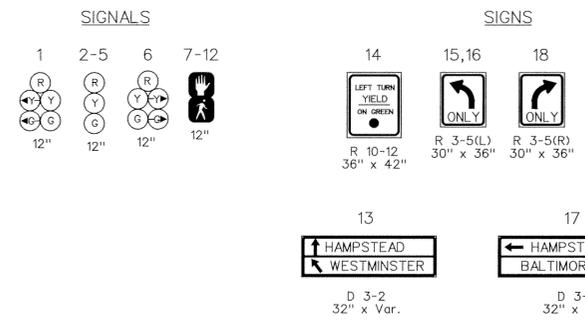


**PHASING NOTES:**  
 1. PHASES ASSOCIATED BY A SOLID LINE WILL NOT OPERATE CONCURRENTLY  
 2. PHASES ASSOCIATED BY A DASHED LINE WILL OPERATE CONCURRENTLY

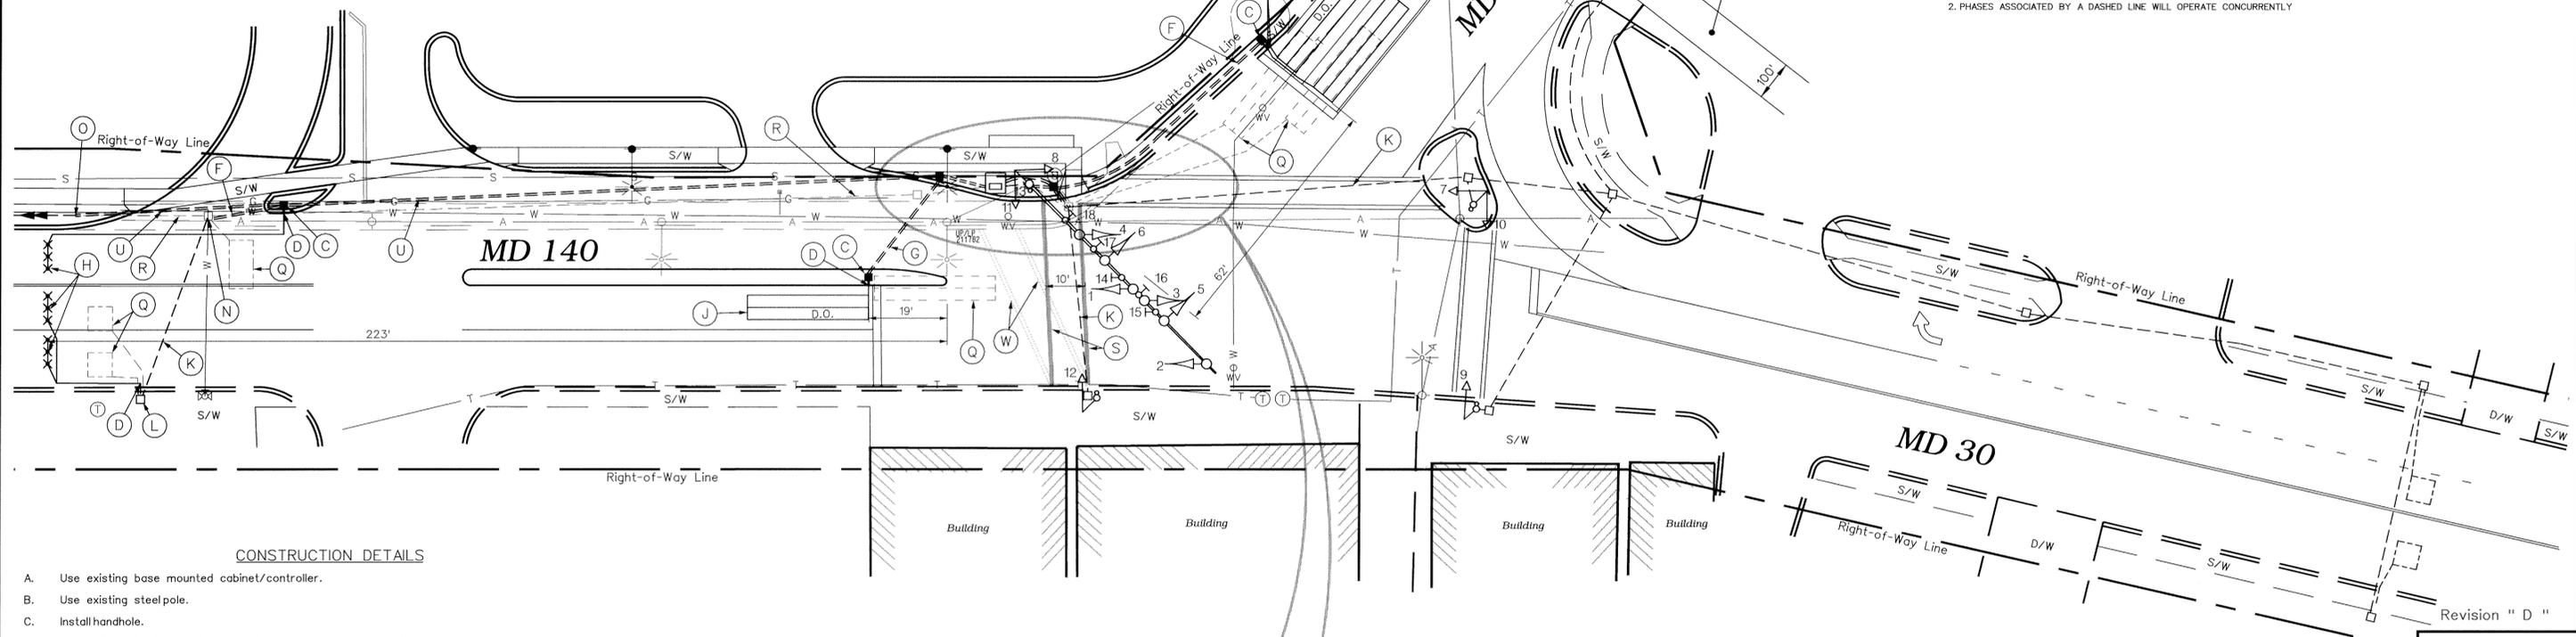


**CONSTRUCTION DETAILS**

- A. Use existing base mounted cabinet/controller.
- B. Use existing steel pole.
- C. Install handhole.
- D. Install 1 in. liquid tight flexible conduit for loop detector lead-in.
- E. Install 2 in. polyvinyl chloride [Schedule 80] electrical conduit - trenched. Tie to existing elbow in cabinet base.
- F. Install 2 in. polyvinyl chloride [Schedule 80] electrical conduit - trenched during construction.
- G. Install 2 in. polyvinyl chloride [Schedule 80] electrical conduit - slotted in roadway.
- H. Install micro-loop probes (set of 3).
- J. Install 6 ft. x 30 ft. quadrupole type vehicle loop detector (3-6-3 turns).
- K. Use existing conduit.
- L. Use existing handhole.
- M. Pullback all existing cables. Tie a new piece of 3 in. conduit to each existing conduit with a 30° elbow. Remove existing handhole. Rerun cables in new conduit.
- N. Tie a 2 in. piece of conduit to the existing conduit with a 30° elbow. Remove existing handhole.
- O. Pullback existing Interconnect cable. Tie new conduit to existing conduit. Rerun to cabinet in new conduit.
- P. Remove existing handhole.
- Q. Disconnect existing loop detector.
- R. Cap and abandon existing conduit.
- S. Install 12 in wide pavement marking - white for crosswalk.
- T. Install handhole on existing conduit run.
- U. Install 3 in. polyvinyl chloride [Schedule 80] electrical conduit - trenched during construction.
- V. Install 3 in. polyvinyl chloride [Schedule 80] electrical conduit - trenched. Tie to existing elbow in pole base.
- W. Remove existing pavement markings by grinding.

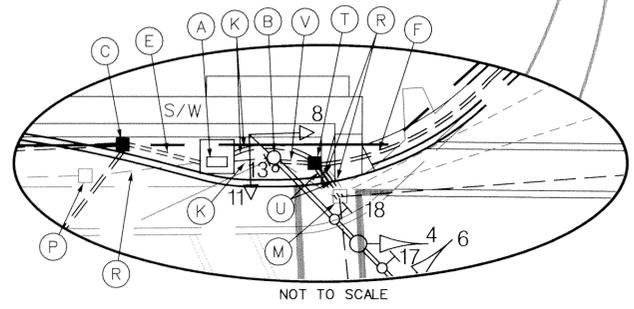

**NOTES**

1. "D.O." indicates delay output loop detector.
2. Geometrics shall be confirmed prior to the installation of signal equipment.
3. Loop detectors and conduits shall be installed prior to the installation of pavement markings.
4. Pavement markings detailed are proposed and are to be installed by the Contractor in accordance with S.H.A. standards. All other pavement markings will be installed as part of the highway contract.
5. Revision 'D' is a revision to the traffic signal built in October, 1995 under S.H.A. Contract No.: B-333X-000-485.
6. All underground and overhead utilities shown on these plans are schematic and are not to be considered complete. The Contractor shall be responsible for notifying all utility companies prior to construction so that all utilities may be located in the field. If the Contractor perceives that a conflict between the utilities and the traffic signal equipment will occur, the Contractor shall notify the appropriate Project Engineer immediately.

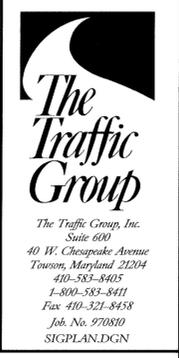

<p><b>GEOMETRIC LEGEND</b></p> <p>— — — — — EXISTING GEOMETRICS</p> <p>— — — — — PROPOSED GEOMETRICS</p> <p><b>UTILITY LEGEND</b></p> <p>— G — G — GAS MAIN</p> <p>— W — W — WATER MAIN</p> <p>— S — S — SEWER MAIN</p> <p>— E — E — ELECTRIC CABLES</p> <p>— D — D — STORM DRAIN</p> <p>— A — A — AERIAL CABLES</p> <p>— T — T — TELEPHONE CABLES</p>	<p><b>REVISIONS</b></p>	<p><b>APPROVALS</b></p> <p>ASST. DIVISION CHIEF TRAFFIC ENGINEERING DESIGN DIVISION</p> <p>CHIEF TRAFFIC ENGINEERING DESIGN DIVISION</p> <p>ASST. DISTRICT ENGINEER - TRAFFIC</p> <p>NOVEMBER 24, 1997</p> <p>Modify for new geometrics.</p> <p>S.H.A. No. BW996M82</p>	<p><b>MDOT - STATE HIGHWAY ADMINISTRATION</b></p> <p>Office of Traffic &amp; Safety</p> <p>TRAFFIC ENGINEERING DESIGN DIVISION</p> <p>(Traffic Signal Plan)</p> <p>MD 140 at MD 30</p>
	<p>DRAWN BY: W. Miller</p> <p>DES. BY: R. Bitt</p> <p>CHK. BY: A. Budnichuck</p> <p>DATE: October 20, 1997</p> <p>SCALE: 1" = 20'</p>	<p>COUNTY: BALTIMORE</p> <p>F.A.P. NO. N/A</p> <p>S.H.A. NO. B-333X-000-485</p>	<p>LOG MILE * 03003000.00</p> <p>TS/STD. NO. 435D</p> <p>SHEET NO. 1 of 2</p>