US 1 IS ASSUMED TO RUN
IN NORTH/SOUTH DIRECTION

PROJECT DESCRIPTION

THIS PROJECT INVOLVES THE REMOVAL OF THE EXISTING HANDICAPPED CROSSING HIB'S LOCATED ON NB/SB US 1 APPROACHING LEEDS AVENUE IN BALTIMORE COUNTY.

EXISTING SIGNALS

1-4

12"

EXISTING SIGNS

8.9 7.10

EXISTING SIGN
TO BE REMOVED

5.6

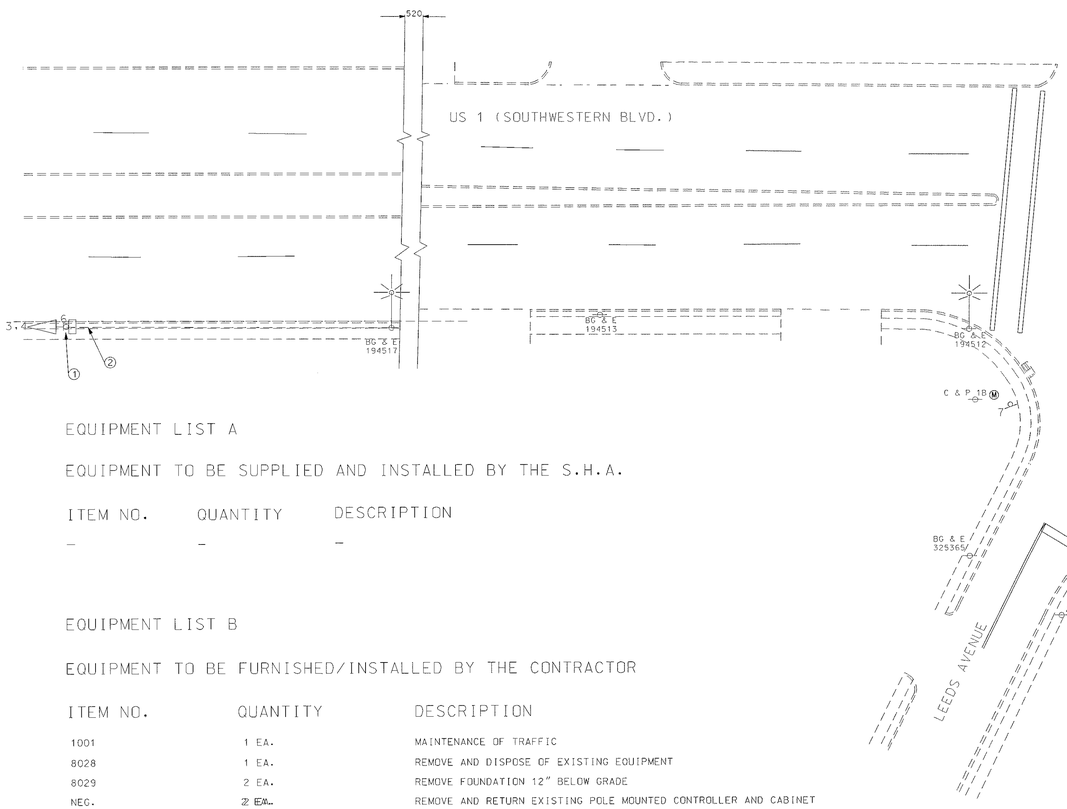

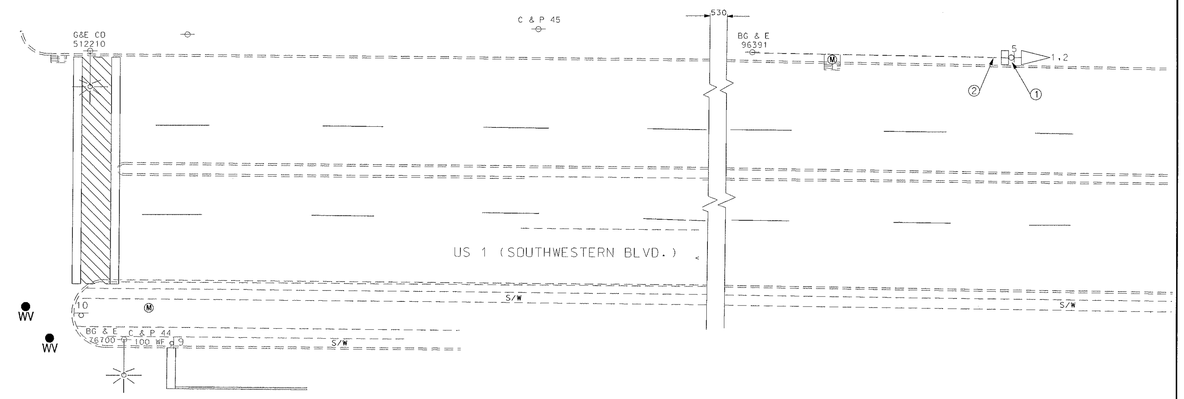

EQUIPMENT LIST A

EQUIPMENT TO BE SUPPLIED AND INSTALLED BY THE S.H.A.

ITEM NO.	QUANTITY	DESCRIPTION
-	-	-

EQUIPMENT LIST B

EQUIPMENT TO BE FURNISHED/INSTALLED BY THE CONTRACTOR

ITEM NO.	QUANTITY	DESCRIPTION
1001	1 EA.	MAINTENANCE OF TRAFFIC
8028	1 EA.	REMOVE AND DISPOSE OF EXISTING EQUIPMENT
8029	2 EA.	REMOVE FOUNDATION 12" BELOW GRADE
NEG.	2 EA.	REMOVE AND RETURN EXISTING POLE MOUNTED CONTROLLER AND CABINET

EQUIPMENT LIST C

EQUIPMENT TO BE RETURNED TO THE S.H.A.

ITEM NO.	QUANTITY	DESCRIPTION
8000	2 EA.	EXISTING POLE MOUNTED CONTROLLER AND CABINET

NOTE: ALL OTHER EQUIPMENT SHALL BECOME THE PROPERTY OF THE CONTRACTOR

CONSTRUCTION DETAILS

1. REMOVE EXISING PEDESTAL POLE, POLE MOUNT CABINET, SIGN AND SIGNAL HEADS. REMOVE EXISTING FOUNDATION 12' BELOW GRADE.
2. CAP AND ABANDON EXISTING CONDUIT.

NOTE: SERVICE TO BE DISCONNECTED BY BG & E.

UTILITY LEGEND

—G—G—	GAS MAIN
—W—W—	WATER MAIN
—S—S—	SEWER MAIN
—E—E—	ELECTRIC CABLES
—A—A—	AERIAL CABLES
—T—T—	TELEPHONE CABLES

REVISIONS	APPROVALS
(A) REMOVE EXIST HIB'S ON US 1-NB/SB APPROACHING LEEDS AVE. MAY 2000 SHA NO. OT 2000	NOTE: THIS IS A REVISION TO B-601-501-485 DATED 8-17-72 ORIGINAL PLAN ON FILE
GCP	DIRECTOR, TRAFFIC & SAFETY

MARYLAND DOT - STATE HIGHWAY ADMINISTRATION
Office of Traffic & Safety
TRAFFIC ENGINEERING DESIGN DIVISION
US 1 (SOUTHWESTERN BOULEVARD)
AT LEEDS AVENUE

DRAWN BY:	J.G. H. KILIAN	F.A.P. NO.	N/A	TS NO.	SHEET NO.
CHECKED BY:		S.H.A. NO.	23854 T2502859	TS-673 (A)	
SCALE:	1" = 20'	COUNTY:	BALTIMORE	T.I.M.S. NO.	1 OF 1
DATE:	8-17-72	LOG MILE:	03000103.39	E-645	