F.H.W.A. REGION NO.	STATE	FED. AID PROJ. NO.	SHEET NO.	TOTAL SHEETS
3	MD.			

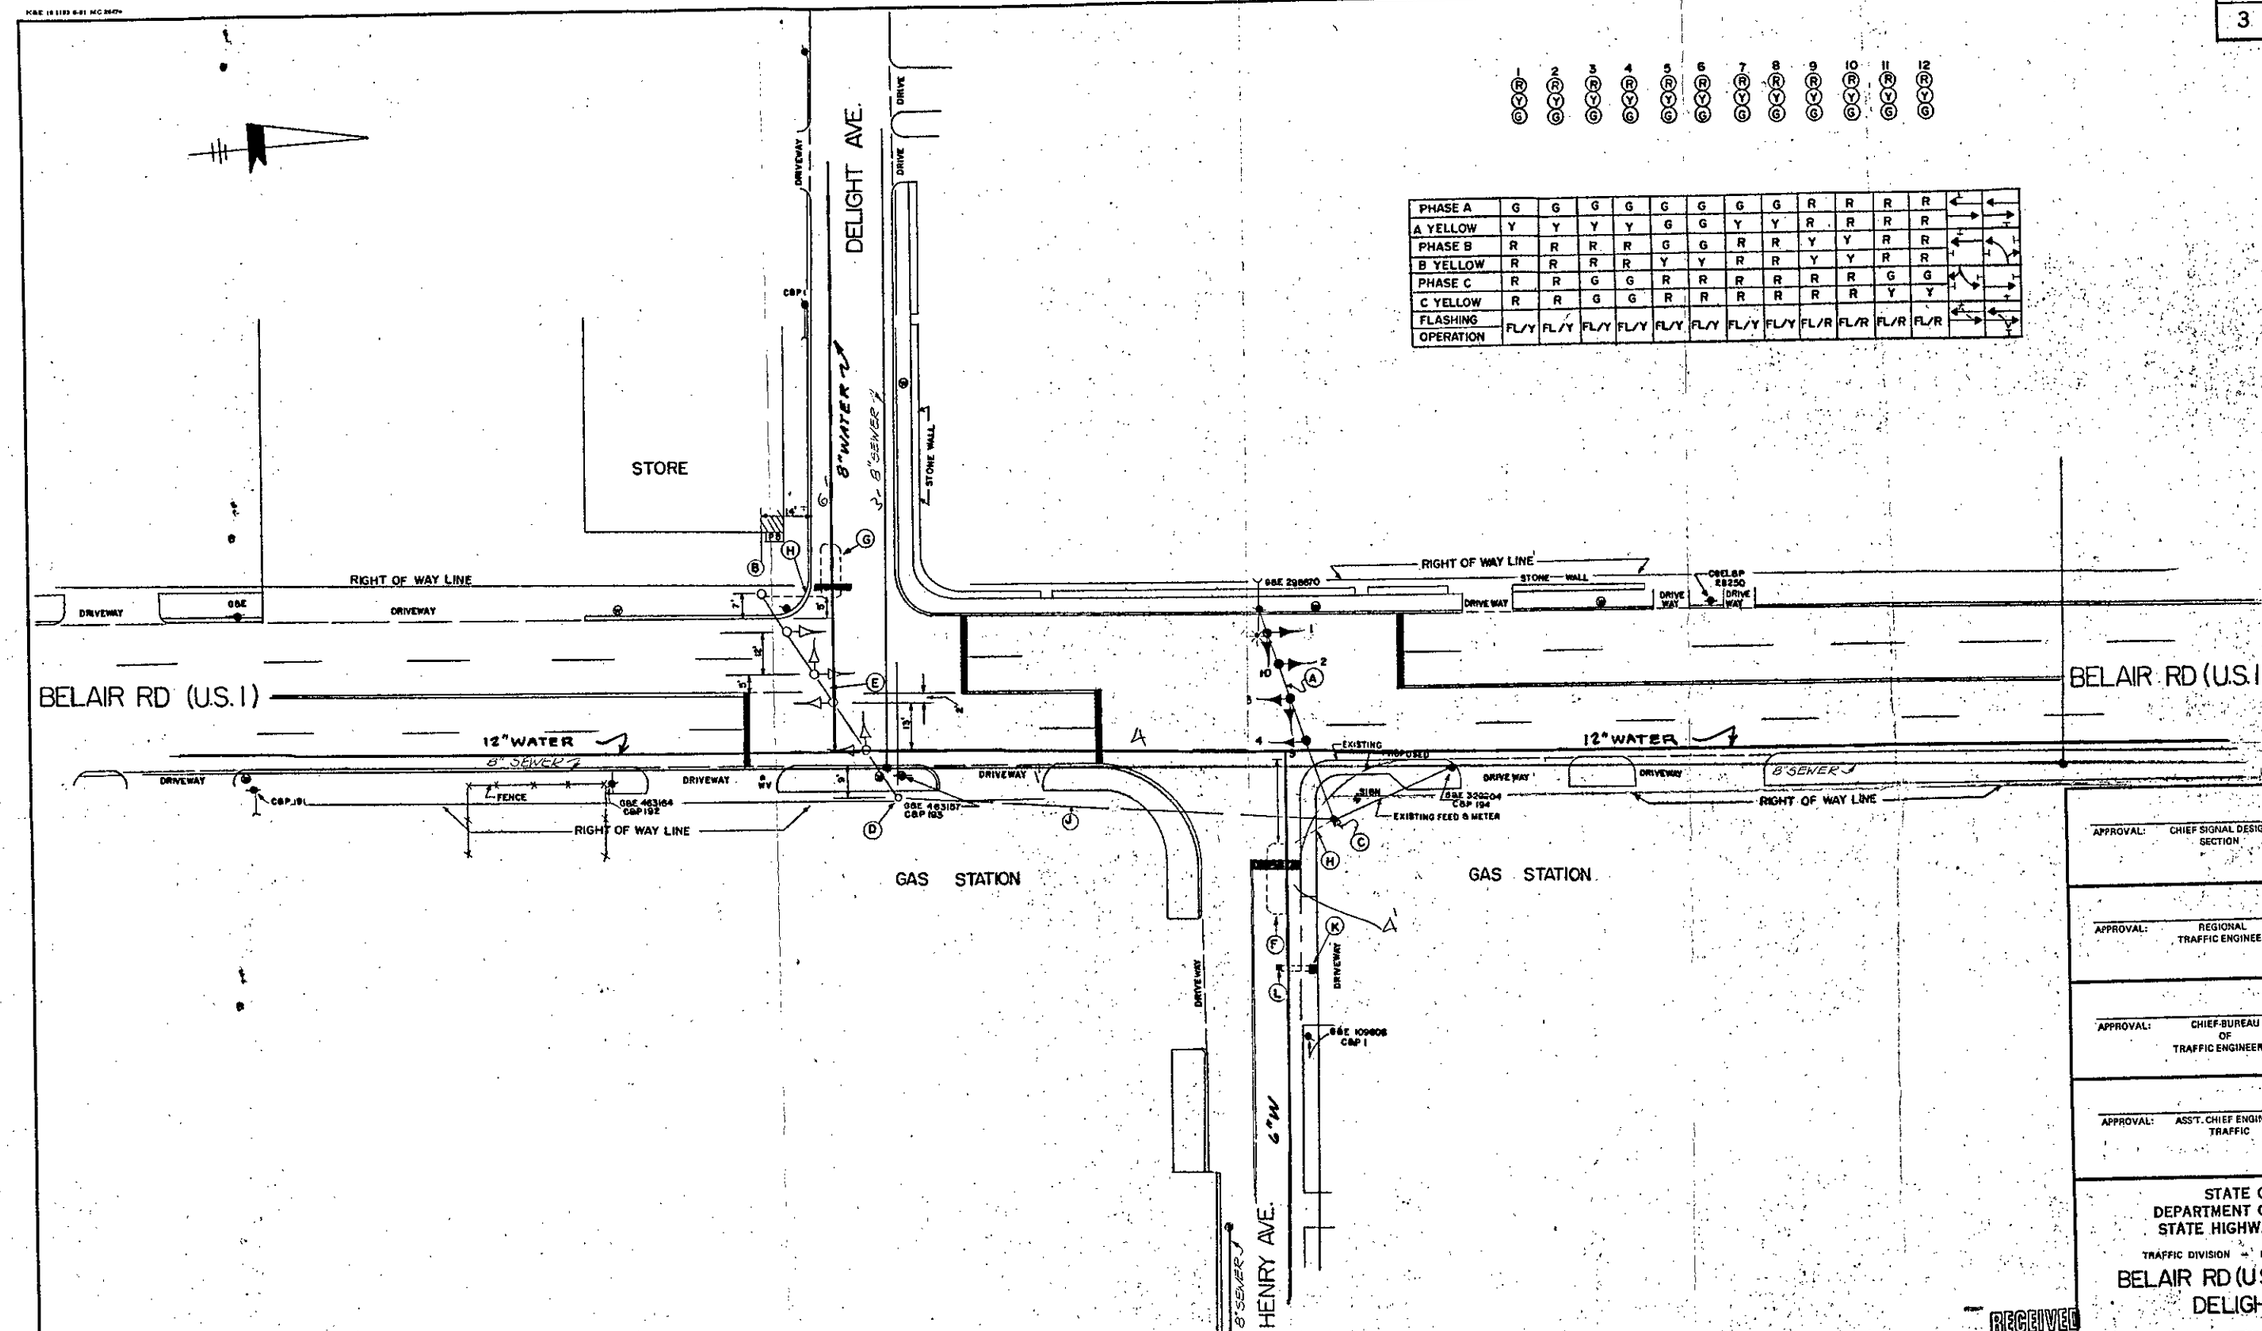

	1	2	3	4	5	6	7	8	9	10	11	12
PHASE A	G	G	G	G	G	G	G	G	R	R	R	R
A YELLOW	Y	Y	Y	Y	G	G	Y	Y	R	R	R	R
PHASE B	R	R	R	R	G	G	R	R	Y	Y	R	R
B YELLOW	R	R	R	R	Y	Y	R	R	Y	Y	R	R
PHASE C	R	R	G	G	R	R	R	R	R	R	G	G
C YELLOW	R	R	G	G	R	R	R	R	R	R	Y	Y
FLASHING OPERATION	FL/Y	FL/Y	FL/Y	FL/Y	FL/Y	FL/Y	FL/Y	FL/Y	FL/R	FL/R	FL/R	FL/R

APPROVAL: CHIEF SIGNAL DESIGN SECTION

APPROVAL: REGIONAL TRAFFIC ENGINEER

APPROVAL: CHIEF-BUREAU OF TRAFFIC ENGINEERING

APPROVAL: ASS'T. CHIEF ENGINEER TRAFFIC

A 5-23-84 REDRAWN

REVISIONS

STATE OF MARYLAND
DEPARTMENT OF TRANSPORTATION
STATE HIGHWAY ADMINISTRATION

TRAFFIC DIVISION — BUREAU OF TRAFFIC ENGINEERING

BELAIR RD (U.S.1), HENRY AVE. & DELIGHT AVE.

SCALE 1" = 20' DATE 5-14-70 CONTRACT NO. 8-195X-475

DRAWN BY: W F FITCH COUNTY: BALTIMORE

DESIGNED BY: SIGNAL NO.:

CHECKED BY:

DRAWING NO. TS-102A

RECEIVED DISTRICT 4 MAR 27 1987 STATE HIGHWAY ADMINISTRATION

03000104.45

MIKE SEE IF 102C HAS DELIGHT AVE ON IT.