FHWA REGION NO.	STATE	FED. AID PROJ. NO.	SHEET NO.	TOTAL SHEETS
3	MD			

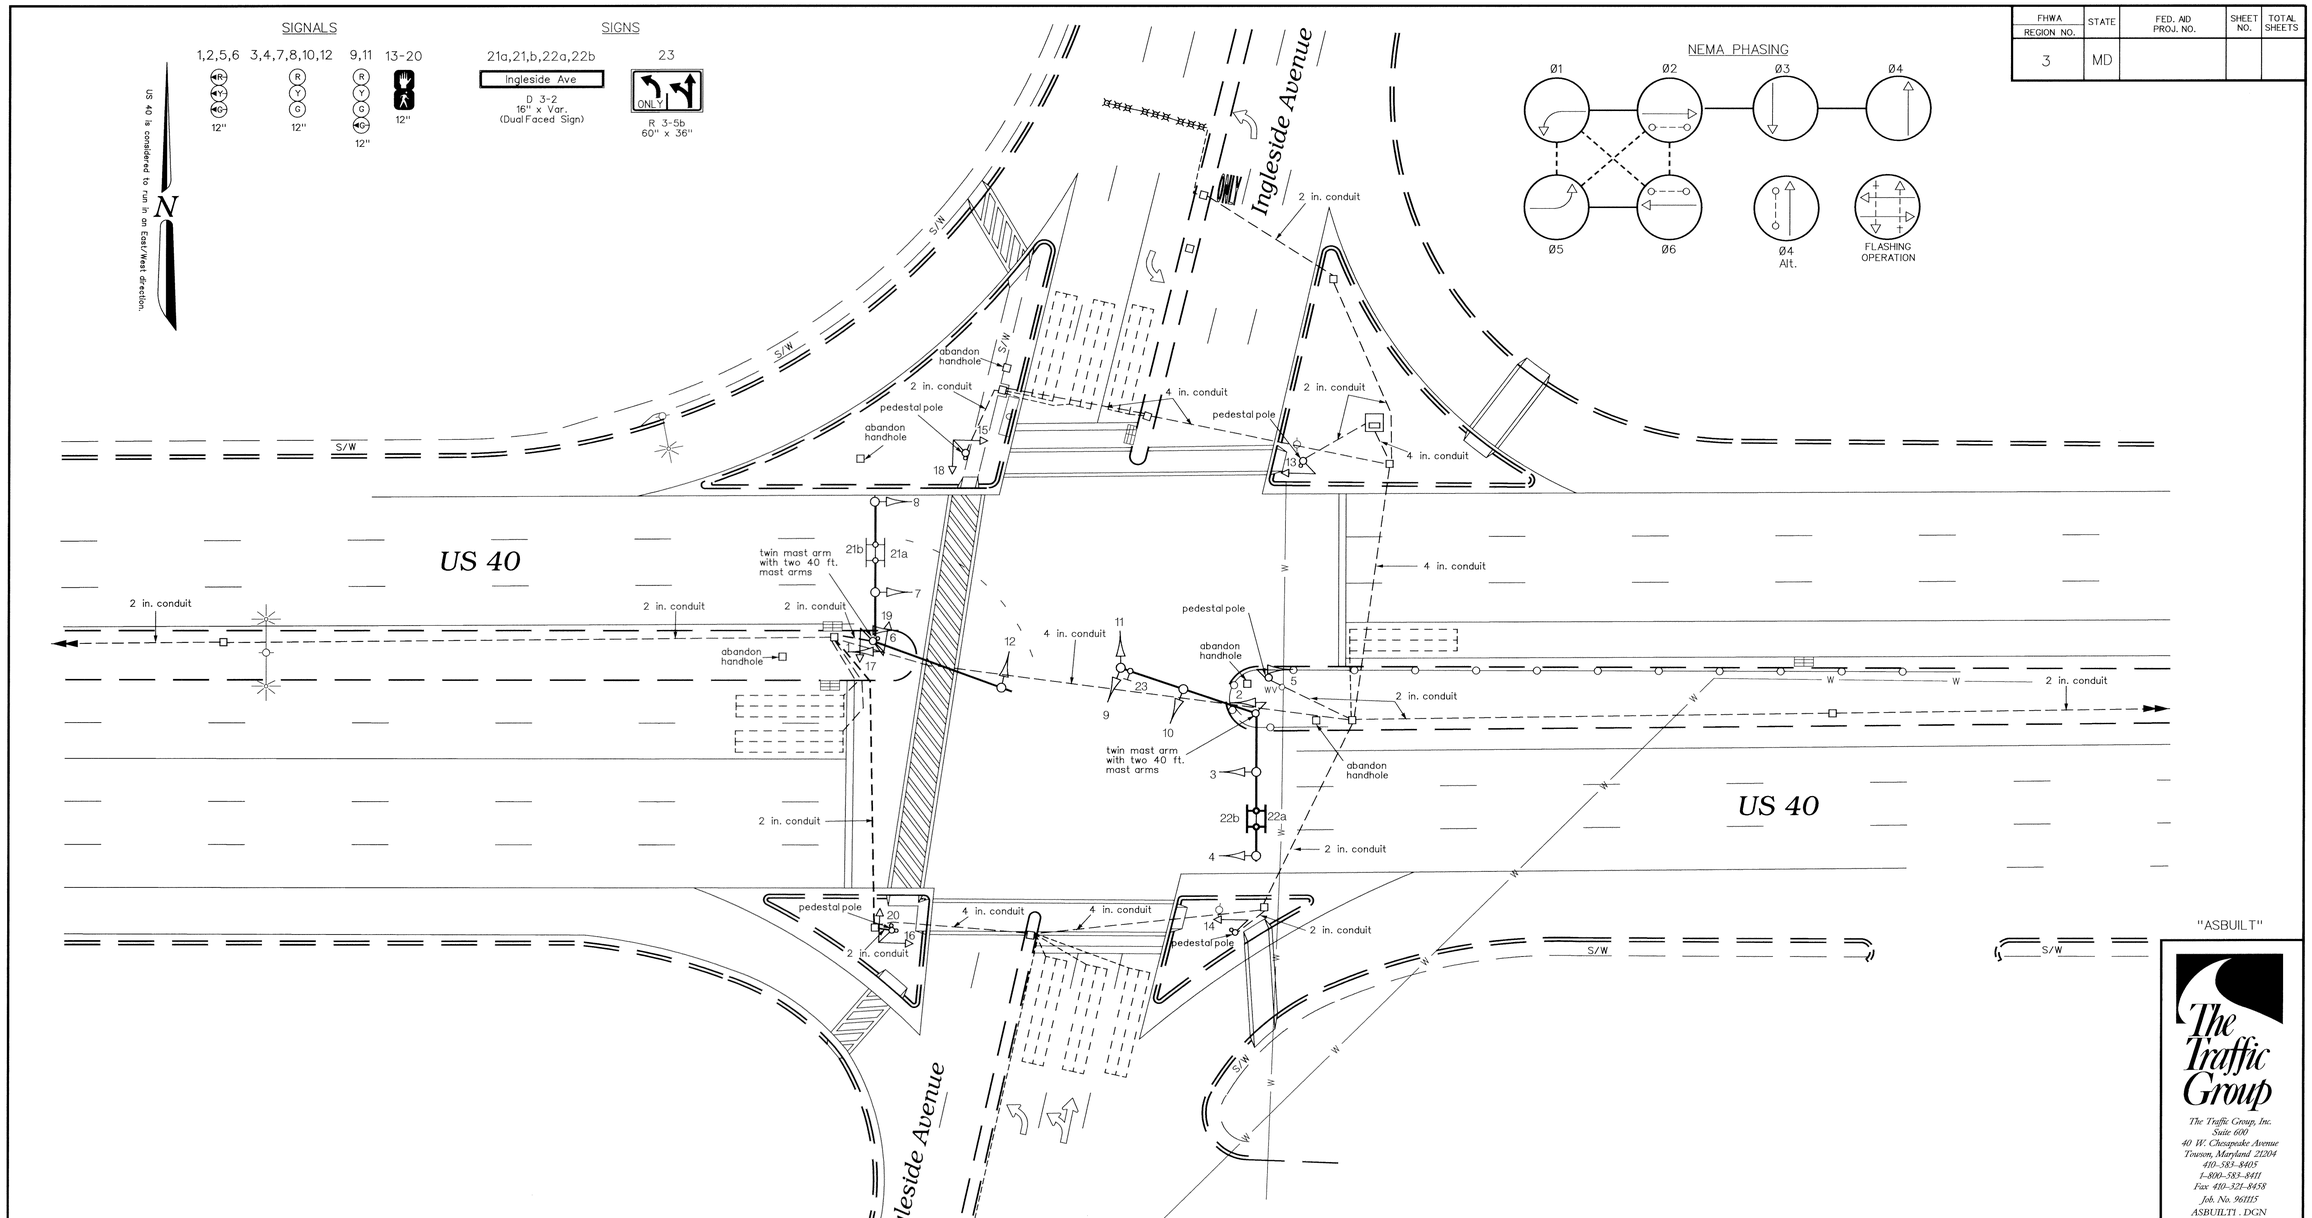

GEOMETRIC LEGEND

EXISTING GEOMETRICS

PROPOSED GEOMETRICS

UTILITY LEGEND

- G — GAS MAIN
- W — WATER MAIN
- S — SEWER MAIN
- E — ELECTRIC CABLES
- D — STORM DRAIN
- A — AERIAL CABLES
- T — TELEPHONE CABLES

REVISIONS

(B) ASBUILT May 1, 1997
S.H.A. No.:BW XXX-XXX-XXX
FHI

APPROVALS

ASST. DIVISION CHIEF TRAFFIC ENGINEERING DESIGN DIVISION

CHIEF, TRAFFIC ENGINEERING DESIGN DIVISION

ASST. DISTRICT ENGINEER - TRAFFIC

DIRECTOR, OFFICE OF TRAFFIC & SAFETY

ORIGINAL ON FILE

MDOT – STATE HIGHWAY ADMINISTRATION

Office of Traffic & Safety

TRAFFIC ENGINEERING DESIGN DIVISION

DRAWN BY: J. GORDON

DES. BY: N/A

CHK. BY: J. SPENCE

(Traffic Signal Plan)

US 40 at Ingleside Avenue

COUNTY: BALTIMORE LOG MILE • 03004002.28

DATE: 2/1/72 F.A.P. NO. N/A

SCALE: 1" = 20' S.H.A. NO. N/A

TS/STD. NO. *188B*

SHEET NO. 1 of 1