FHWA REGION NO.	STATE	FED. AID PROJ. NO.	SHEET NO.	TOTAL SHEETS
3	MD			

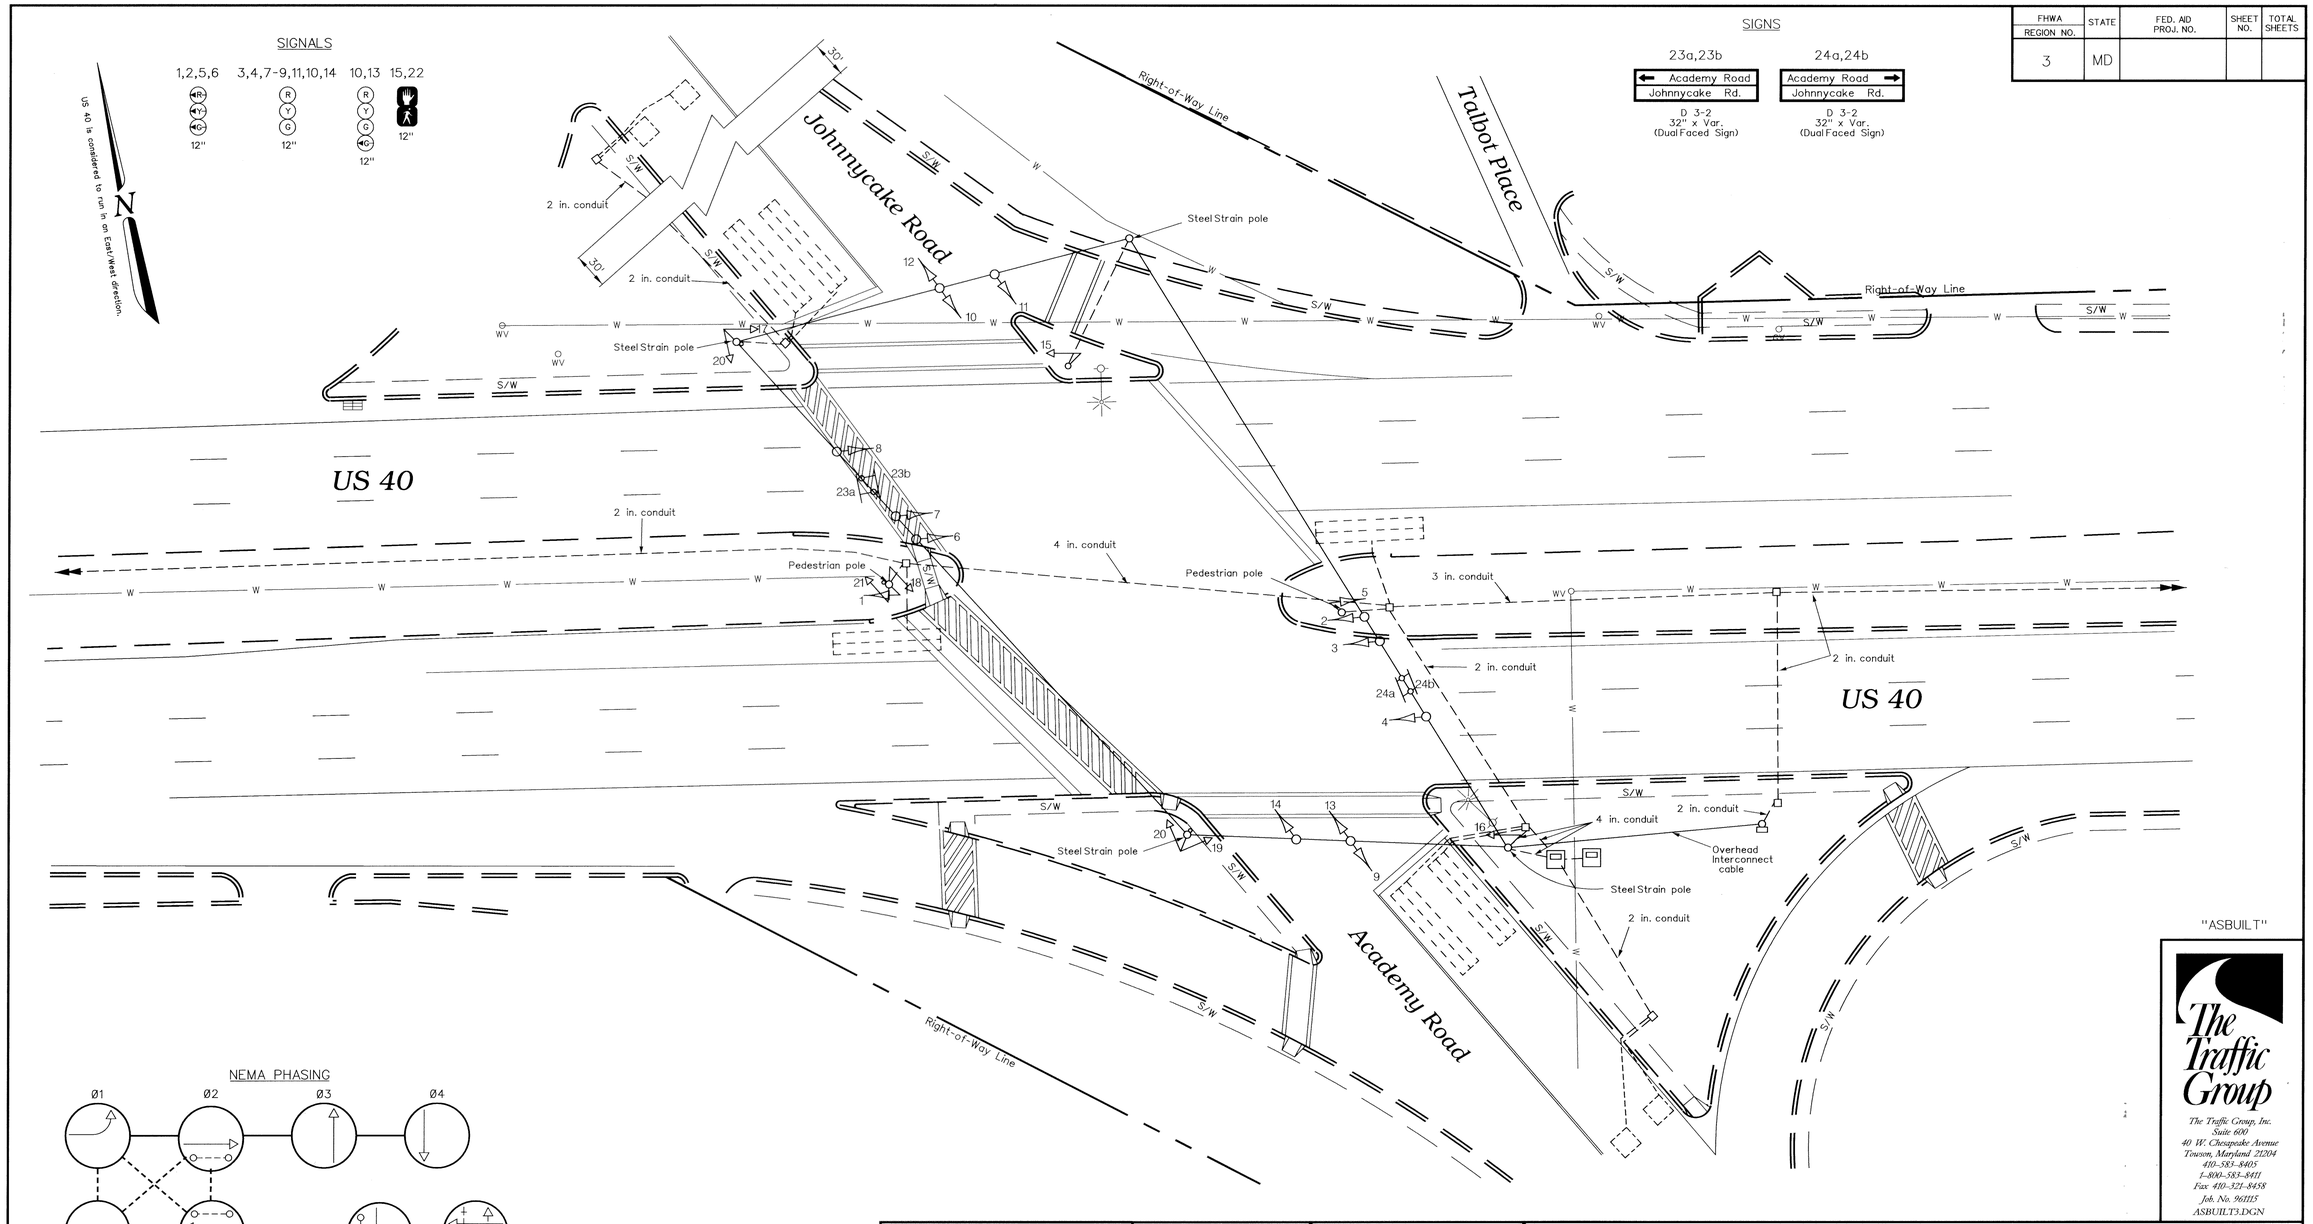

NEMA PHASING

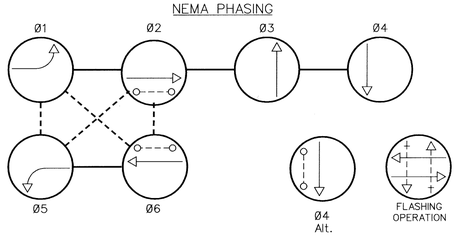

"ASBUILT"

The Traffic Group
The Traffic Group, Inc.
Suite 600
40 W. Chesapeake Avenue
Towson, Maryland 21204
410-583-8405
1-800-583-8411
Fax: 410-321-8458
Job. No. 961115
ASBUILT3.DGN

GEOMETRIC LEGEND

EXISTING GEOMETRICS

PROPOSED GEOMETRICS

UTILITY LEGEND

G — G	GAS MAIN
W — W	WATER MAIN
S — S	SEWER MAIN
E — E	ELECTRIC CABLES
D — D	STORM DRAIN
A — A	AERIAL CABLES
T — T	TELEPHONE CABLES

REVISIONS

© May 1, 1997
ASBUILT
S.H.A. No.:BW XXX-XXX-XXX
FTH

APPROVALS

ASST. DIVISION CHIEF TRAFFIC ENGINEERING DESIGN DIVISION

CHIEF, TRAFFIC ENGINEERING DESIGN DIVISION

ASST. DISTRICT ENGINEER - TRAFFIC

DIRECTOR, OFFICE OF TRAFFIC & SAFETY

ORIGINAL ON FILE

MDOT – STATE HIGHWAY ADMINISTRATION

Office of Traffic & Safety

TRAFFIC ENGINEERING DESIGN DIVISION

DRAWN BY: Bruce Thompson JG

DES. BY: (Des By)

CHK. BY: (Chk By)

(Traffic Signal Plan)

US 40 and Johnnycake Road/ Academy Road

COUNTY: Baltimore

LOG MILE • 03004003.22

DATE: Redraw 5/11/92

SCALE: 1" = 20'

F.A.P. NO. N/A

S.H.A. NO. (Sha No.)

TS/STD. NO. *887C*

SHEET NO. 1 of 1