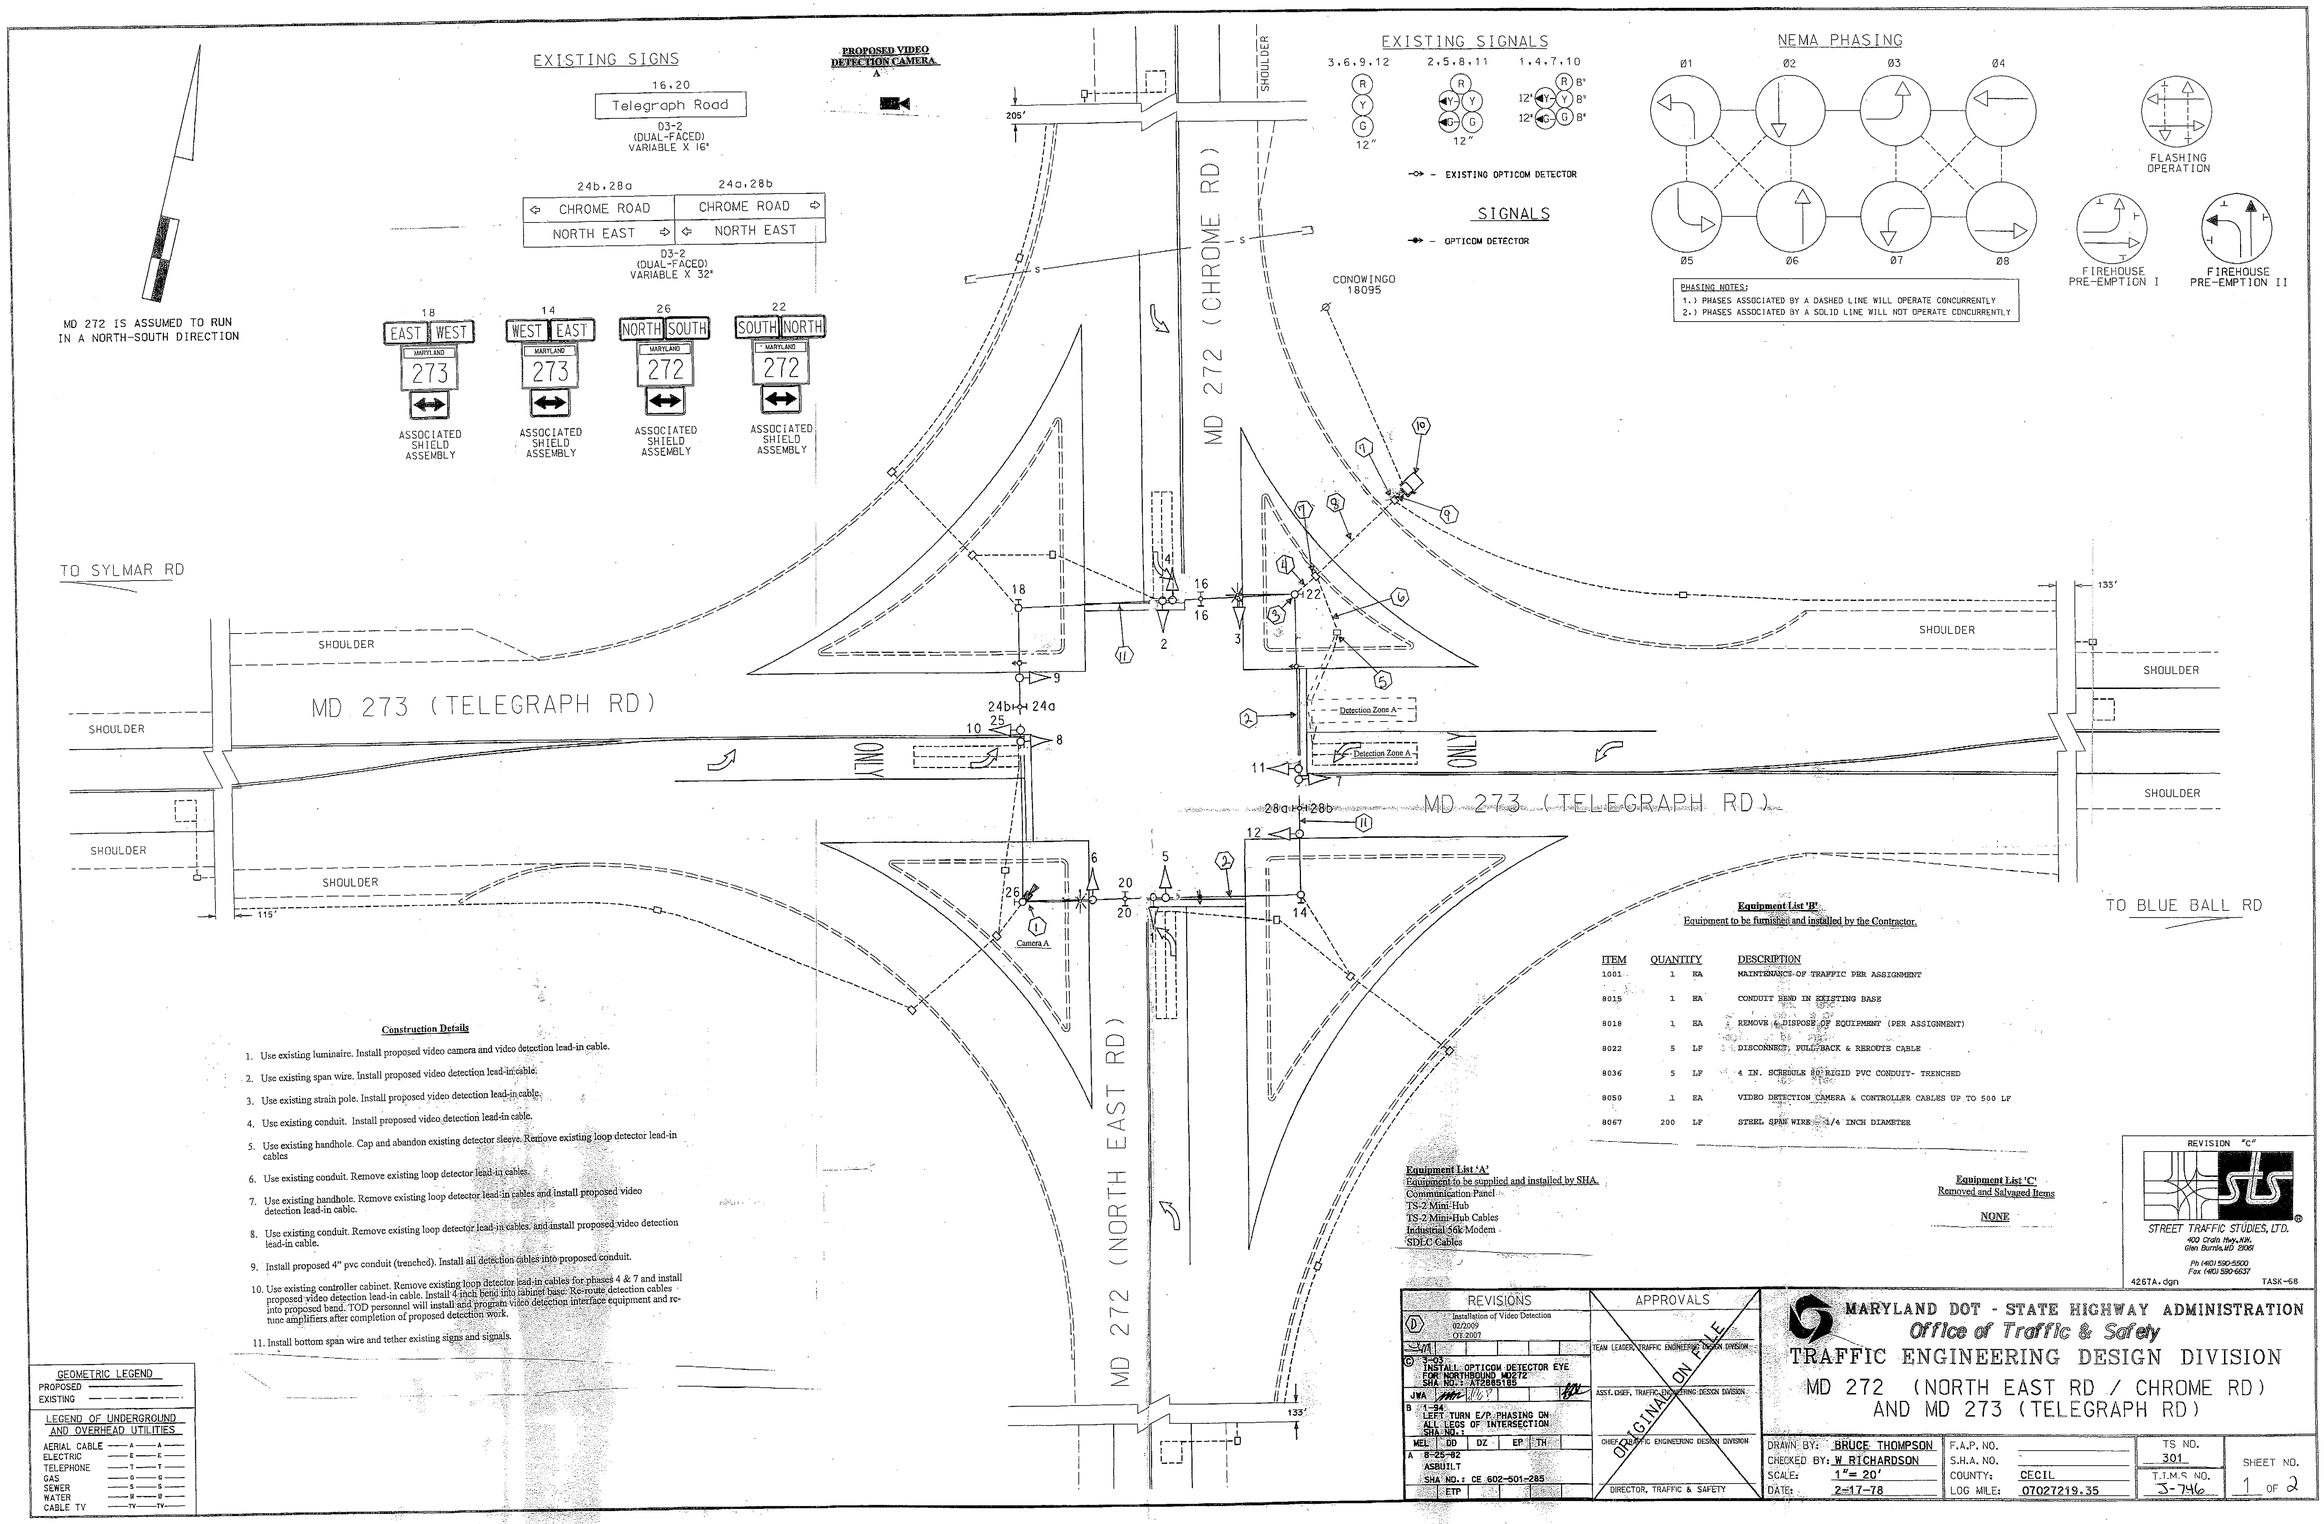

...\4267\4267a\4267a.dgn Feb. 24, 2003 13:47:19