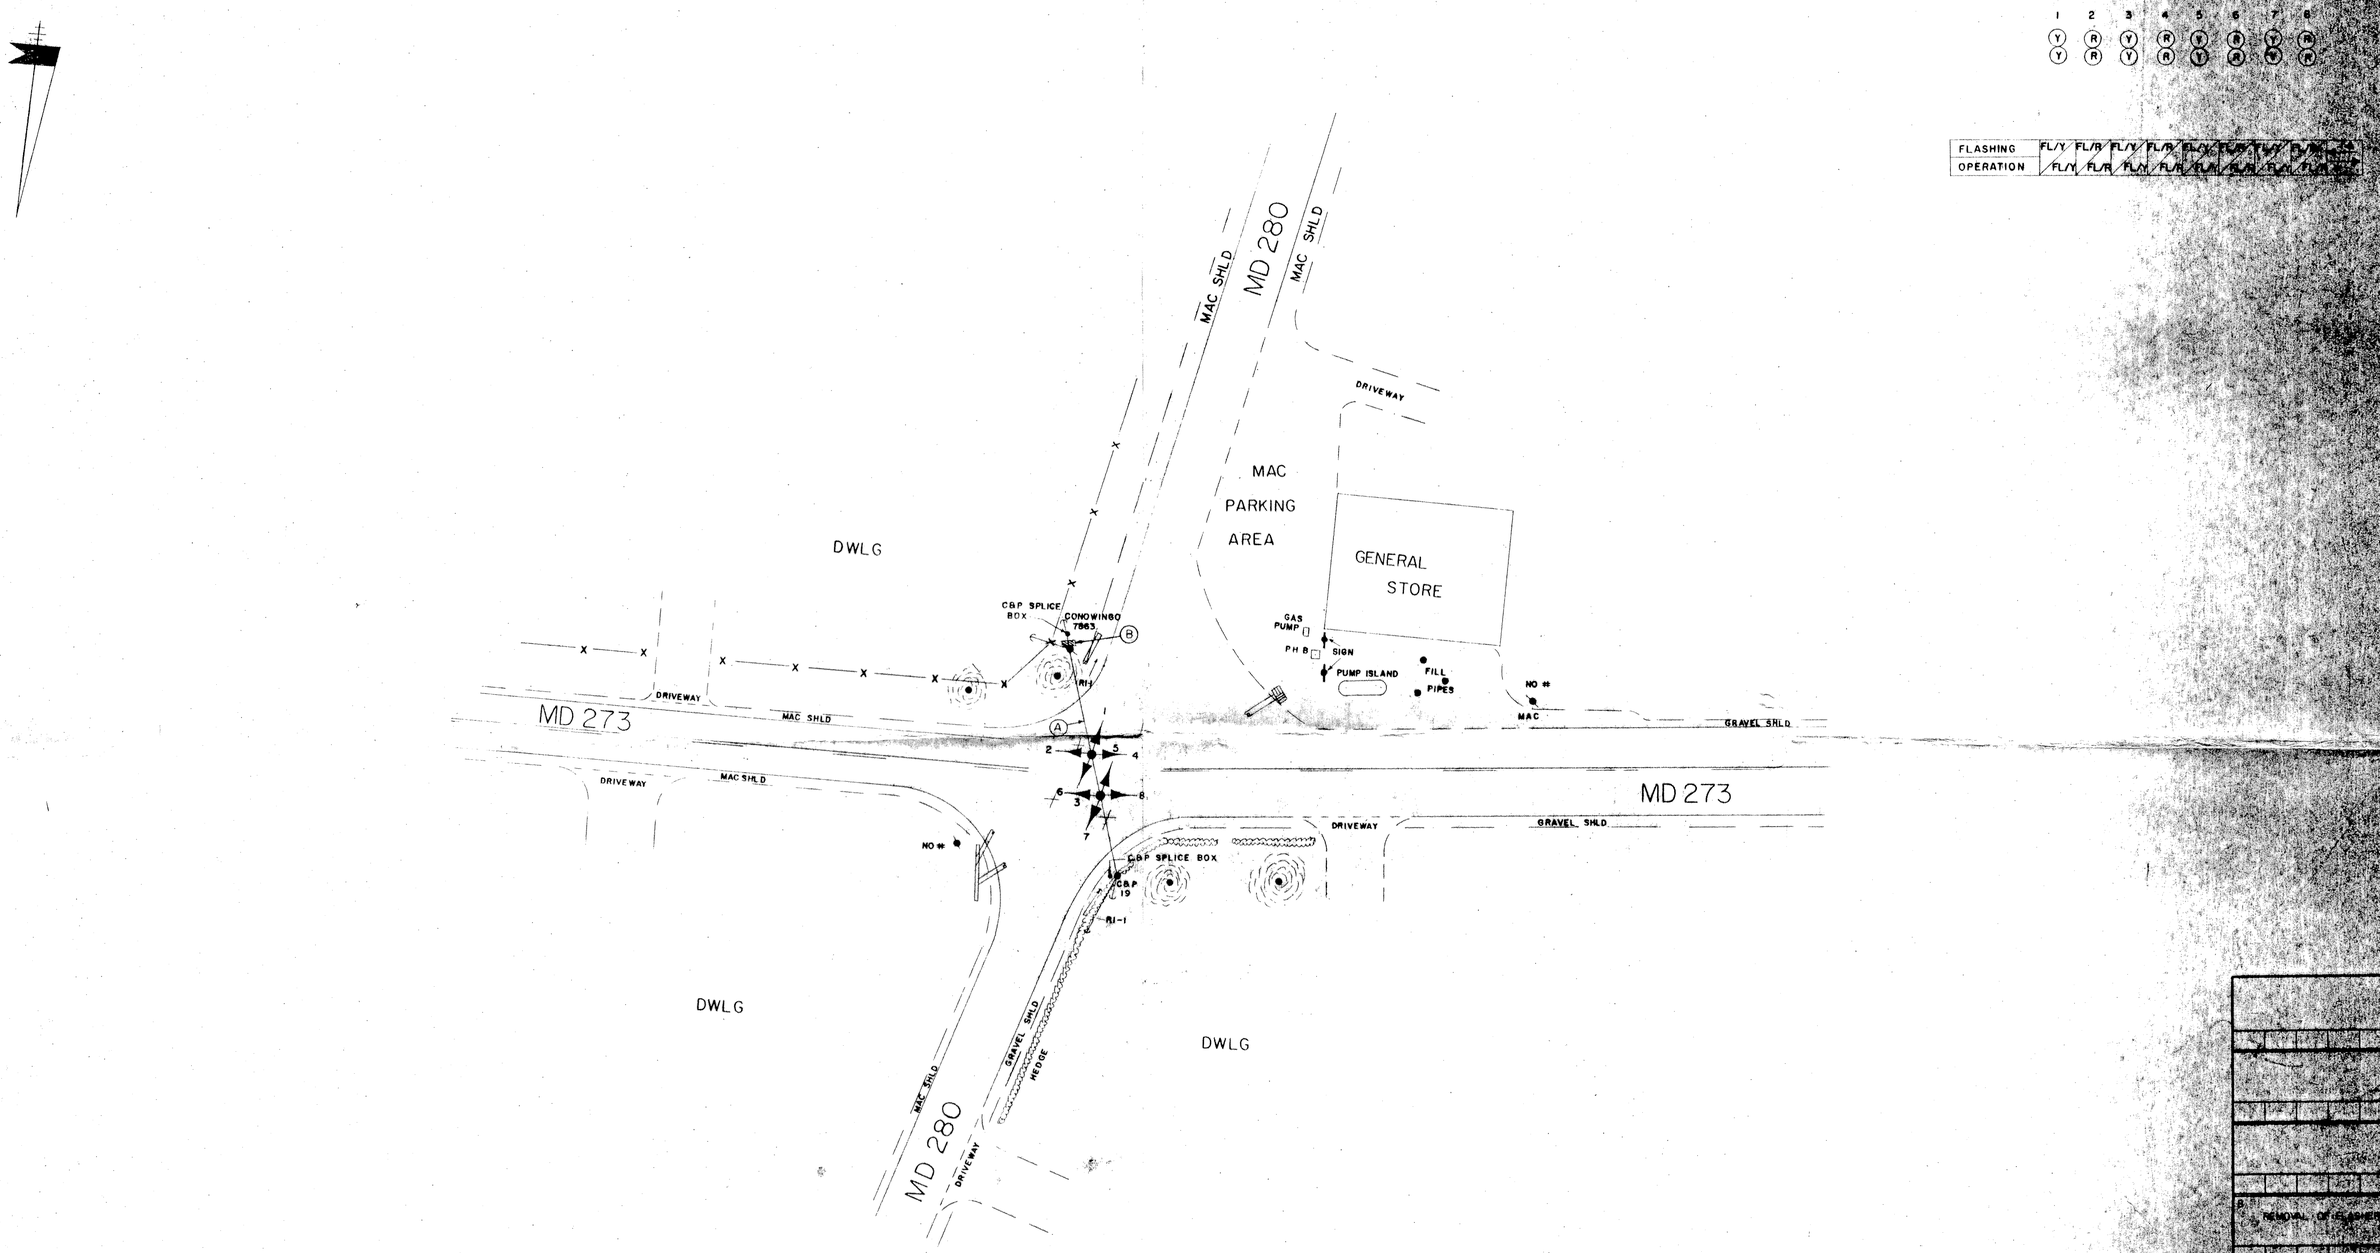

B	REMOVAL OF FLASHER
GEC	
A	GS BUILT
LET	JS
REVISIONS	

APPROVAL: CHIEF - BUREAU OF TRAFFIC ENGINEERING

APPROVAL: ASS'T CHIEF ENGINEER TRAFFIC SAFETY

MARYLAND STATE ROADS COMMISSION
DIVISION OF TRAFFIC SAFETY
BUREAU OF TRAFFIC ENGINEERING

MD 273 & MD 280

SIGNAL NO 07009

DATE FEB 15, 1971
SCALE 1" = 20'
DRAWN BY: LES TOWNSEND
CONTRACT NO
COUNTY CECIL
CHECKED BY: J. [illegible]

DRAWING NO. TS 304B