F H WA REGION NO	STATE	FED. AID PROJ. NO	SHEET NO.	TOTAL SHEETS
3	MD.			

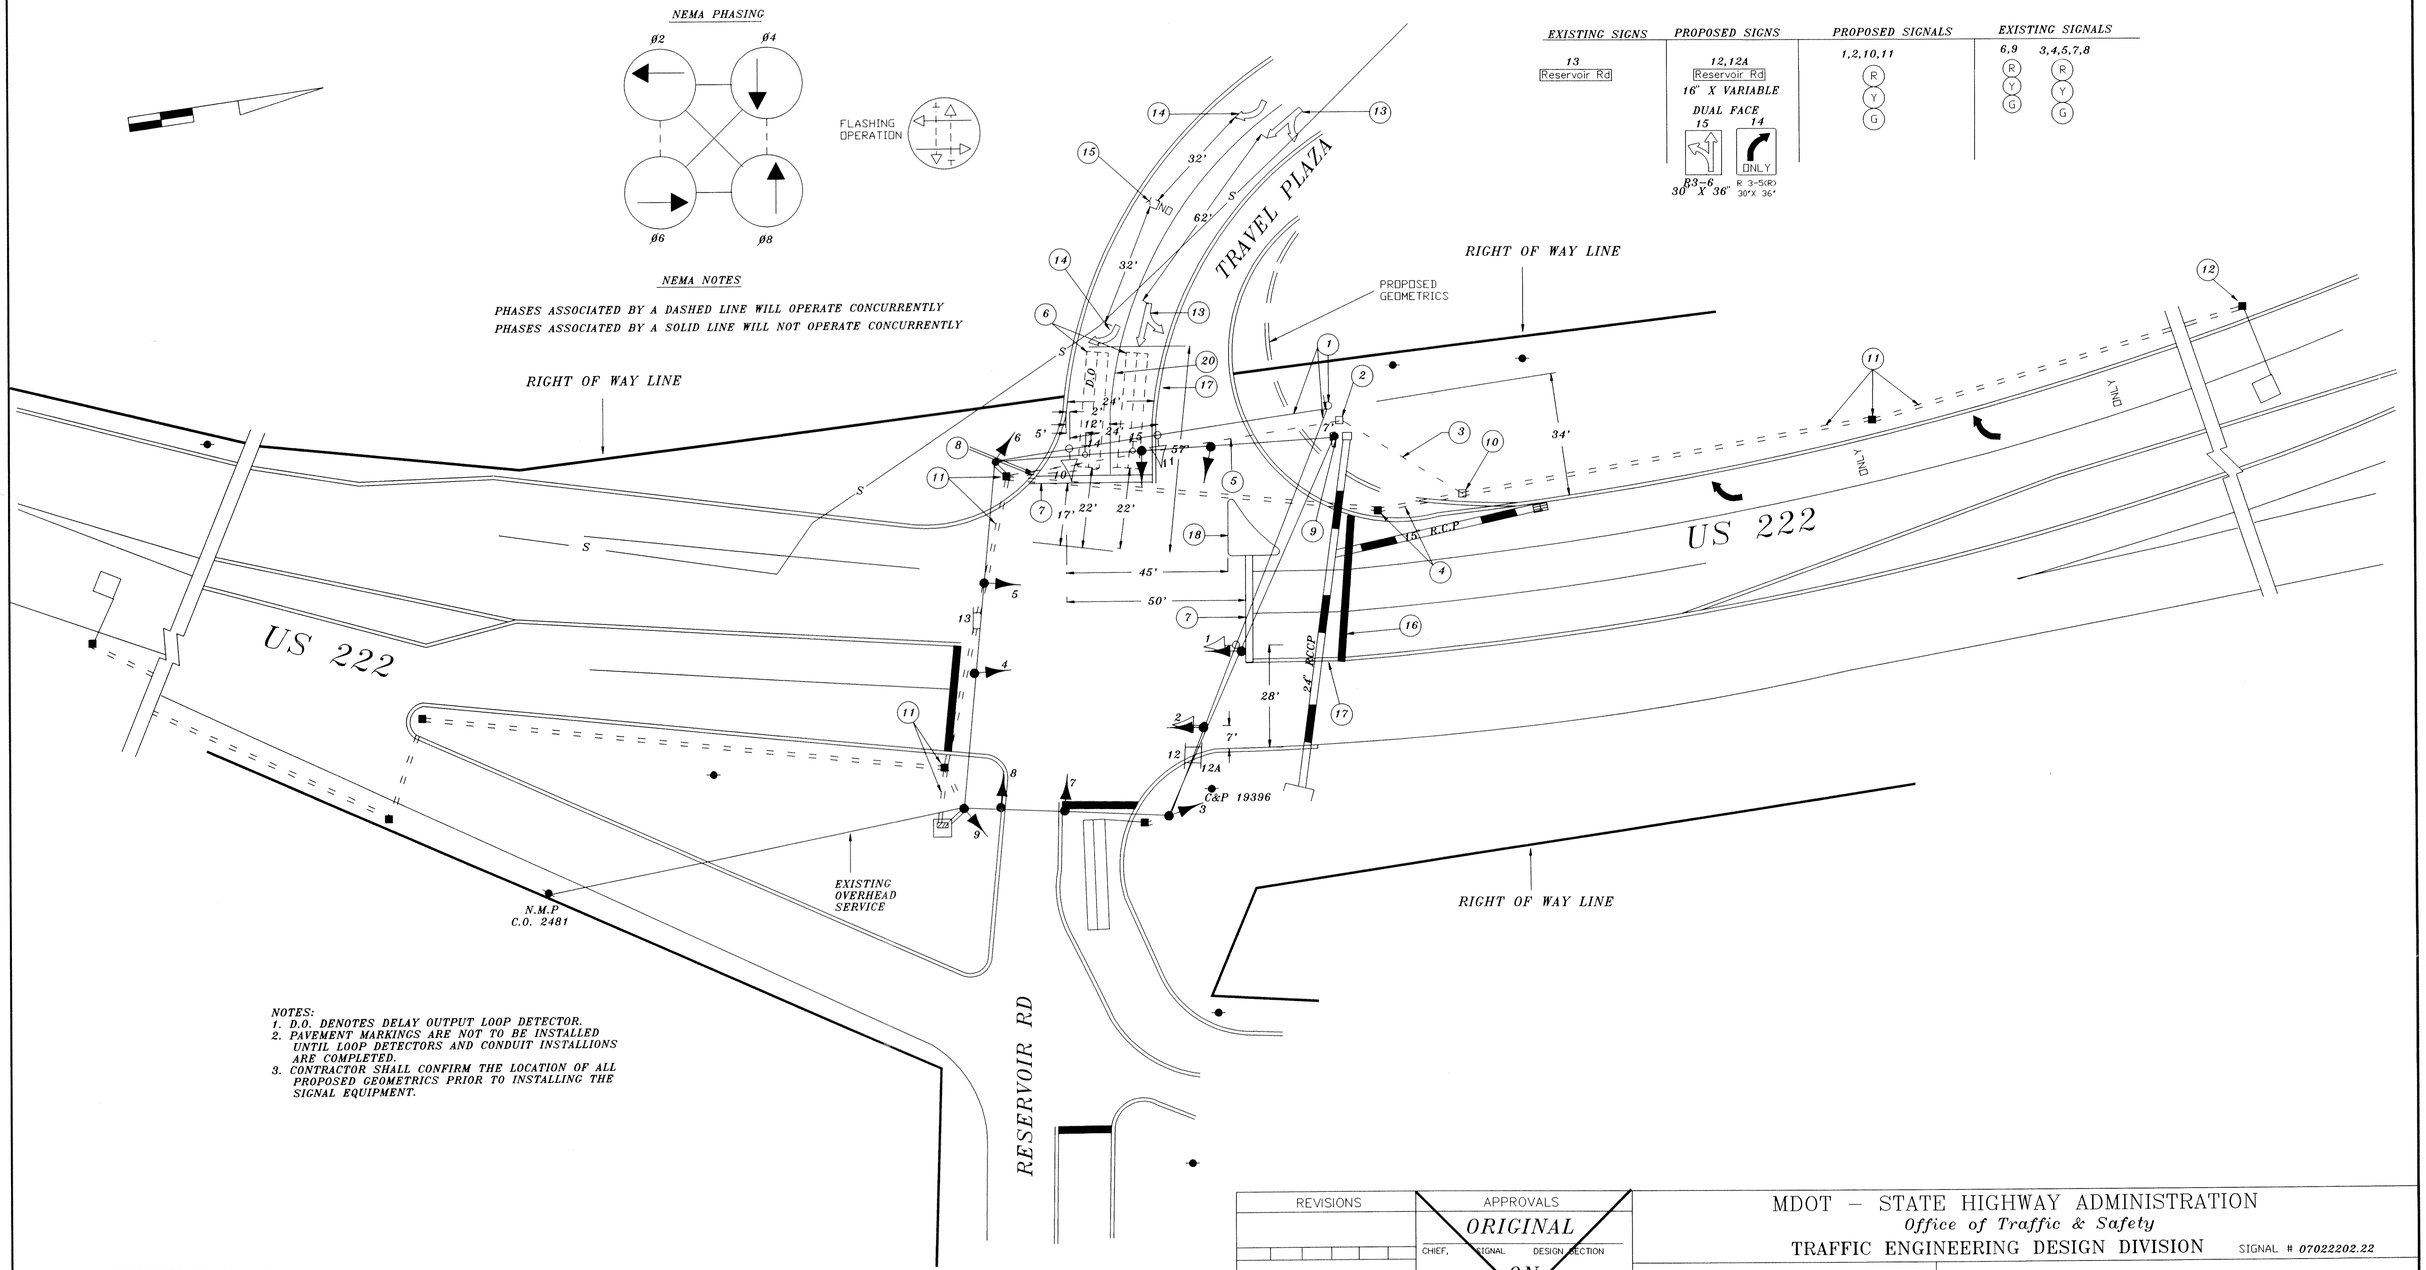

UTILITY LEGEND

—— G —— G ——	GAS MAIN
—— W —— W ——	WATER MAIN
—— S —— S ——	SEWER MAIN
—— E —— E ——	ELECTRIC CABLES
—— A —— A ——	AERIAL CABLES
—— T —— T ——	TELEPHONE CABLES

REVISIONS	APPROVALS
	ORIGINAL
	CHIEF, SIGNAL DESIGN SECTION
	ON
	ASST. DISTRICT ENGINEER, TRAFFIC
	CHIEF, TRAFFIC ENGINEERING DESIGN DIVISION
(A) ASBUILT 8/92 INSTALL NEW STRAIN POLE DUE TO NEW GEOMETRICS AND INSTALL NEW LOOP DETECTORS FOR EB TRVL PLAZA	FILE
7/92 CES 11/91 ESJ	DIRECTOR, OFFICE OF TRAFFIC & SAFETY

MDOT – STATE HIGHWAY ADMINISTRATION
Office of Traffic & Safety
TRAFFIC ENGINEERING DESIGN DIVISION

SIGNAL # 07022202.22

DRAWN BY: M.A.M OF THE TRAFFIC GROUP
DES. BY: M.A.M OF THE TRAFFIC GROUP
CHK. BY:

US 222 AND RESERVOIR ROAD

COUNTY: CECIL

DATE: 1/8/88
SCALE: 1" = 20'
F.A.P. NO.
S.H.A. NO. BW-159-801-212
TS/STD. NO. TS 2425 (A)
SHEET NO. ___ OF ___

F# 21

07022202.22