F.H.W.A. REGION NO.	STATE	FED. AID PROJ. NO.	SHEET NO.	TOTAL SHEETS
3	MD.		1	1

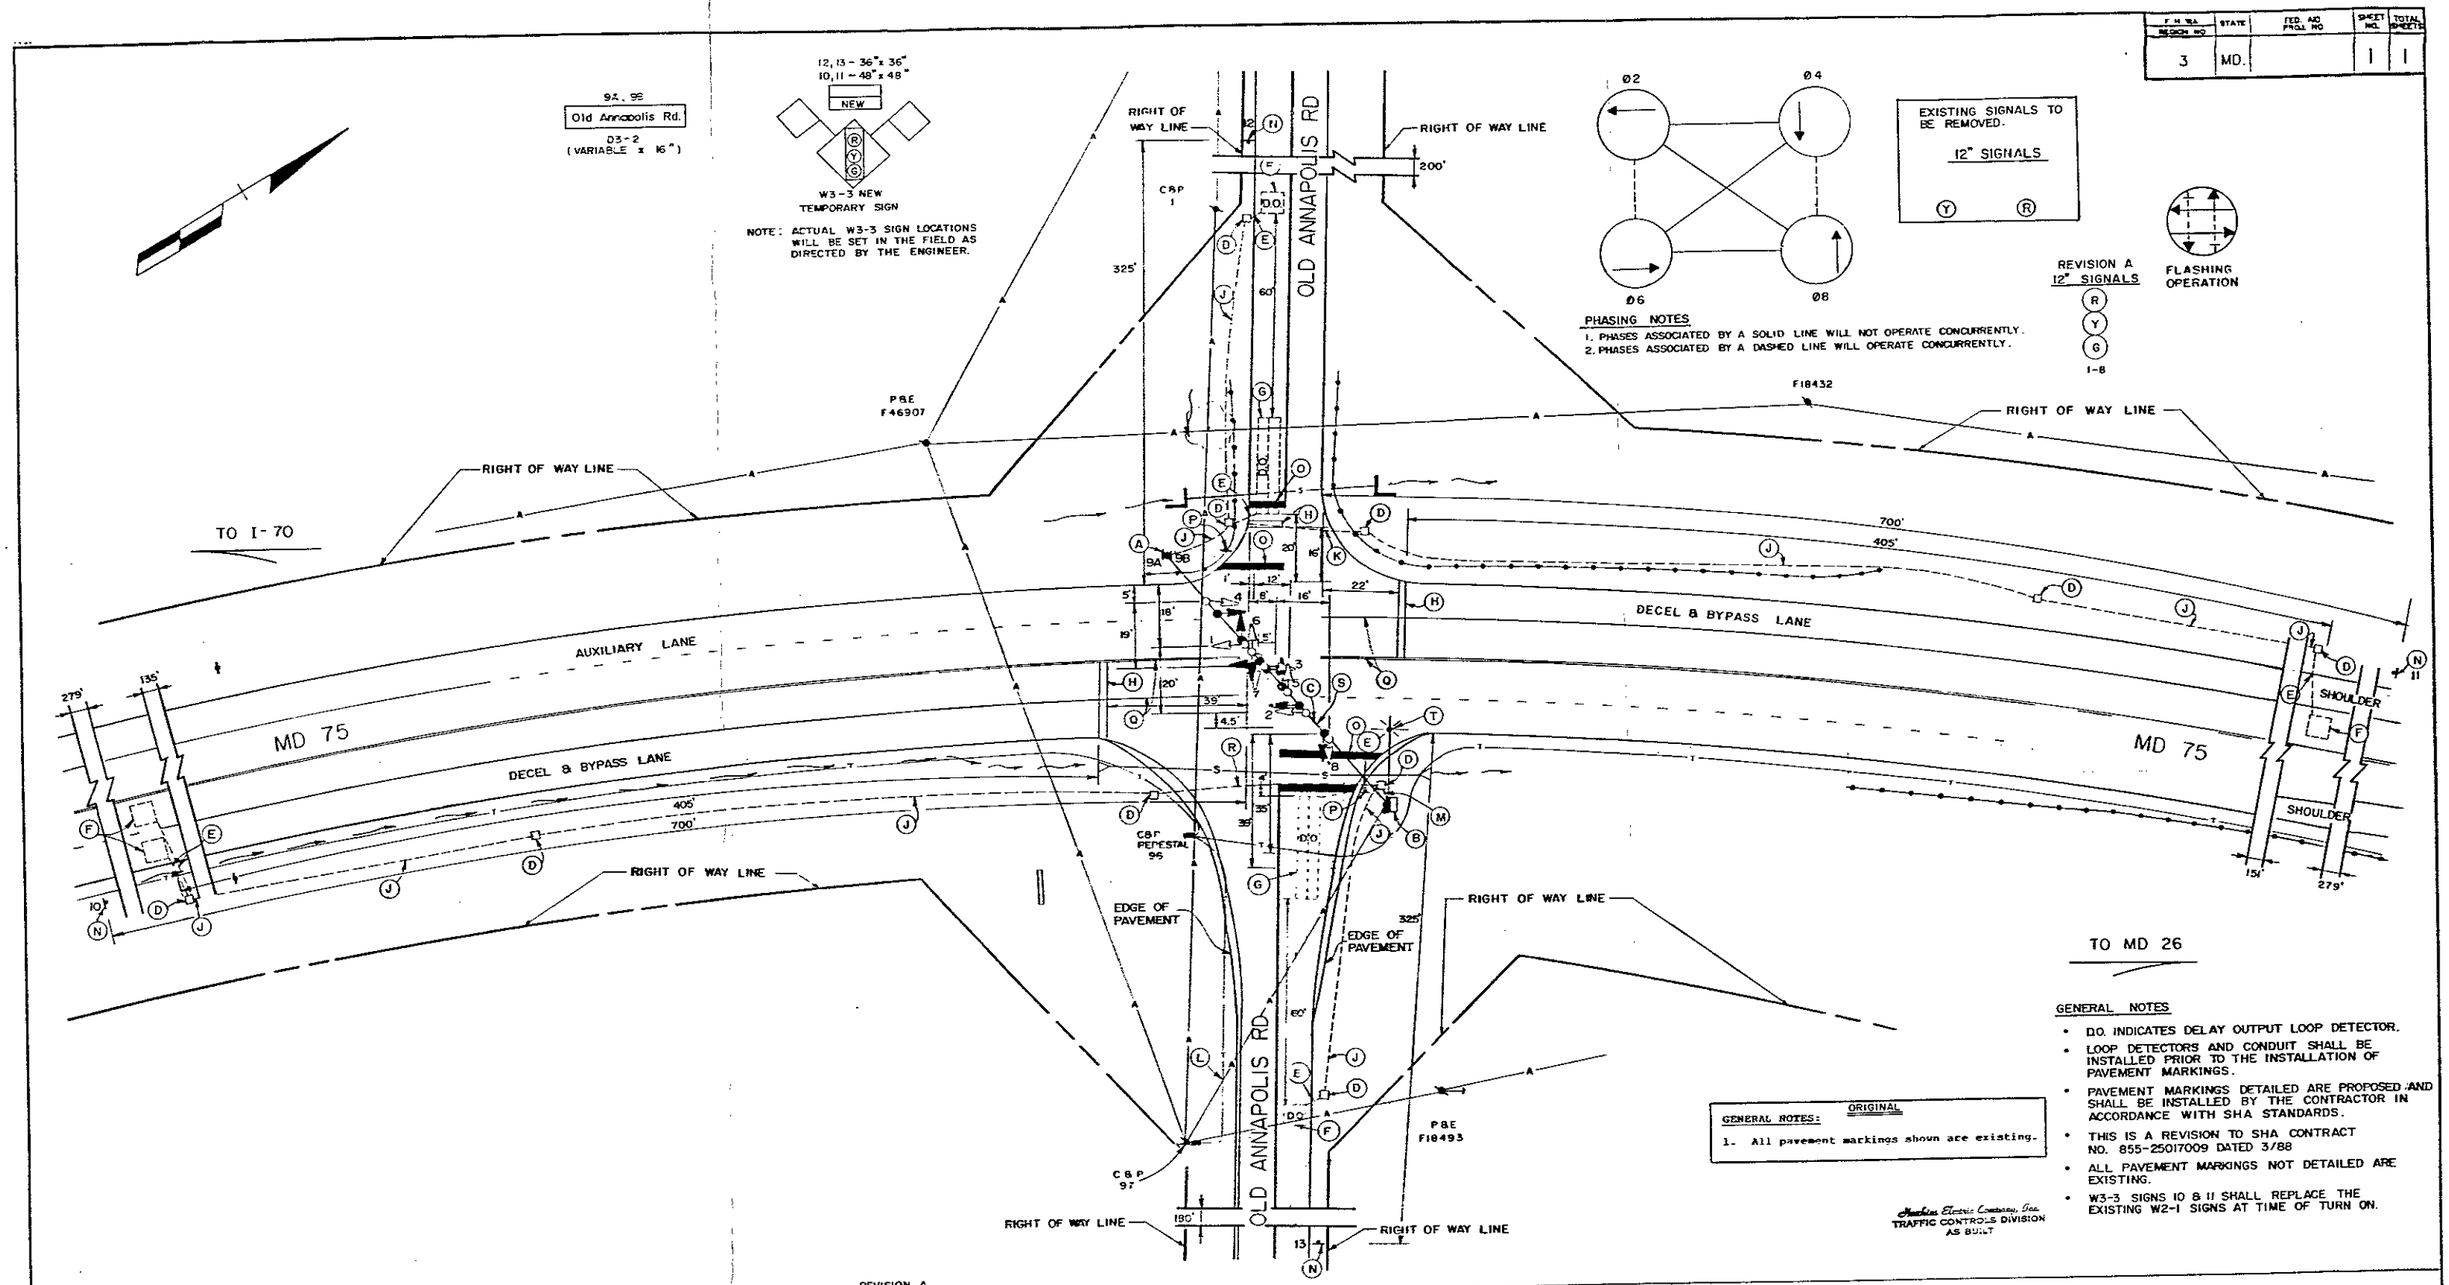

GENERAL NOTES

- D.O. INDICATES DELAY OUTPUT LOOP DETECTOR.
- LOOP DETECTORS AND CONDUIT SHALL BE INSTALLED PRIOR TO THE INSTALLATION OF PAVEMENT MARKINGS.
- PAVEMENT MARKINGS DETAILED ARE PROPOSED AND SHALL BE INSTALLED BY THE CONTRACTOR IN ACCORDANCE WITH SHA STANDARDS.
- THIS IS A REVISION TO SHA CONTRACT NO. 855-25017009 DATED 3/88
- ALL PAVEMENT MARKINGS NOT DETAILED ARE EXISTING.
- W3-3 SIGNS 10 & 11 SHALL REPLACE THE EXISTING W2-1 SIGNS AT TIME OF TURN ON.

ORIGINAL

GENERAL NOTES:

1. All pavement markings shown are existing.

Machine Electric Company, Inc.
TRAFFIC CONTROLS DIVISION
AS BUILT

REVISION A

LEGEND OF UNDERGROUND AND OVERHEAD UTILITIES

AERIAL CABLE — A — A — A — A
ELECTRIC — E — E — E — E
TELEPHONE — T — T — T — T
GAS — G — G — G — G
SEWER — S — S — S — S
WATER — W — W — W — W
CABLE TV — TV — TV — TV — TV

64896-32

BUCHART HORN, INC.
244 WEST BLOCK
THE QUADRANGLE
VILLAGE OF CROSS KEYS
BALTIMORE, MARYLAND 21210

STREET TRAFFIC STUDIES, LTD.
Suite 295, Commercentre East
1777 Reisterstown Road
Baltimore, Maryland 21208

REVISIONS

(A) AUG 1990 - AS BUILT SHA NO. 855-25017009, CONVERTED ICB TO FULL SIGNAL. 800-387-804-712

APPROVALS

CHIEF, SIGNAL DESIGN SECTION 3/22/88
ASST. DISTRICT ENGINEER, TRAFFIC 3/22/88
CHIEF, BUREAU OF TRAFFIC ENGINEERING 3-22-88
DEPUTY CHIEF ENGINEER, OFFICE OF TRAFFIC 3-24-88

MARYLAND DEPARTMENT OF TRANSPORTATION
STATE HIGHWAY ADMINISTRATION – OFFICE OF TRAFFIC
TRAFFIC ENGINEERING DIVISION

DRAWN BY: W J NIES (FOR STS)
DES. BY: R R ZACHERL (FOR STS)
CHK. BY: 3-22-88

MD 75 AND OLD ANNAPOLIS RD

SIGNAL NO. 10007511.96
COUNTY: FREDERICK

DATE: 11-2-87
SCALE: 1" = 20'
F.A.P. NO.
S.H.A. NO. 855-25017009
TS/FILE NO. 2427 A
SHEET NO. 1 OF 1

10007511.96