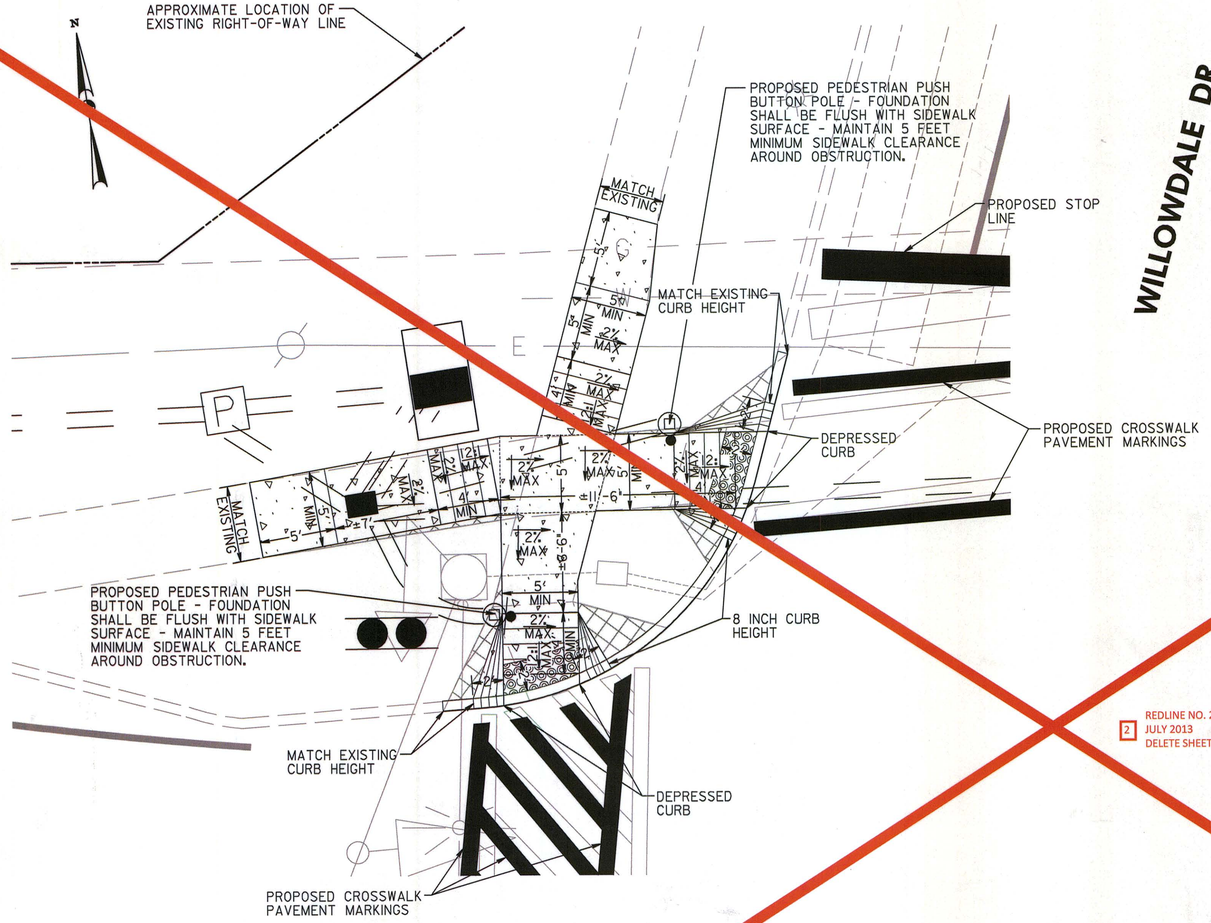

US 40 (W. PATRICK ST)

STANDARD TYPE A COMBINATION CURB AND GUTTER 12 INCH GUTTER PAN 8 INCH DEPTH SHA STD. NO. MD-620.02	
LOCATION	QUANTITY (LF)
NORTHWEST QUADRANT	37

5 INCH CONCRETE SIDEWALK	
LOCATION	QUANTITY (SF)
NORTHWEST QUADRANT	[illegible]

CLASS 2 EXCAVATION	
LOCATION	QUANTITY (CY)
NORTHWEST QUADRANT	1.0

DETECTABLE WARNING SURFACE SHA STD. NO. MD-655.40	
LOCATION	QUANTITY (SF)
NORTHWEST QUADRANT	21

2 REDLINE NO. 2 JULY 2013 DELETE SHEET AKB 5-13

SEE SHEET DE-1 FOR GENERAL NOTES AND DETAILS

LEGEND

- CONCRETE PAVEMENT
- DETECTABLE WARNING SURFACE SHA STD. NO. MD-655.40
- REMOVE EXISTING SIDEWALK PAID FOR AS CLASS 2 EXCAVATION

RK&K
RUMMEL, KLEPPER & KAHL, LLP
81 MOSHER STREET | BALTIMORE, MD 21217
PH: (410) 728-2900 FAX: (410) 728-3160
Engineers | Construction Managers | Planners | Scientists
www.rkk.com

STATE OF MARYLAND
DEPARTMENT OF TRANSPORTATION
STATE HIGHWAY ADMINISTRATION

US 40 (W PATRICK ST)
AT WILLOWDALE DR

RAMP DETAILS

SCALE 1" = 5' DATE MARCH 2013 CONTRACT NO. XX6505185

DESIGNED BY JDG COUNTY FREDERICK
DRAWN BY JBB LOGMILE 10004012.28
CHECKED BY ATD TIMS NO. L537
FAP NO. TOD NO.

TS NO. 907D-DE | DRAWING DE-2 OF 2 | SHEET NO. 4 OF 5

PLOTTED: Thursday, March 14, 2013 AT 08:37 AM
FILE: K:\projects\2008\08148_tcddes\Task 128_US 40 Willodale\CADD\Plan\pDE-P002_US40-Willowdale.dgn

By: jgolomb -