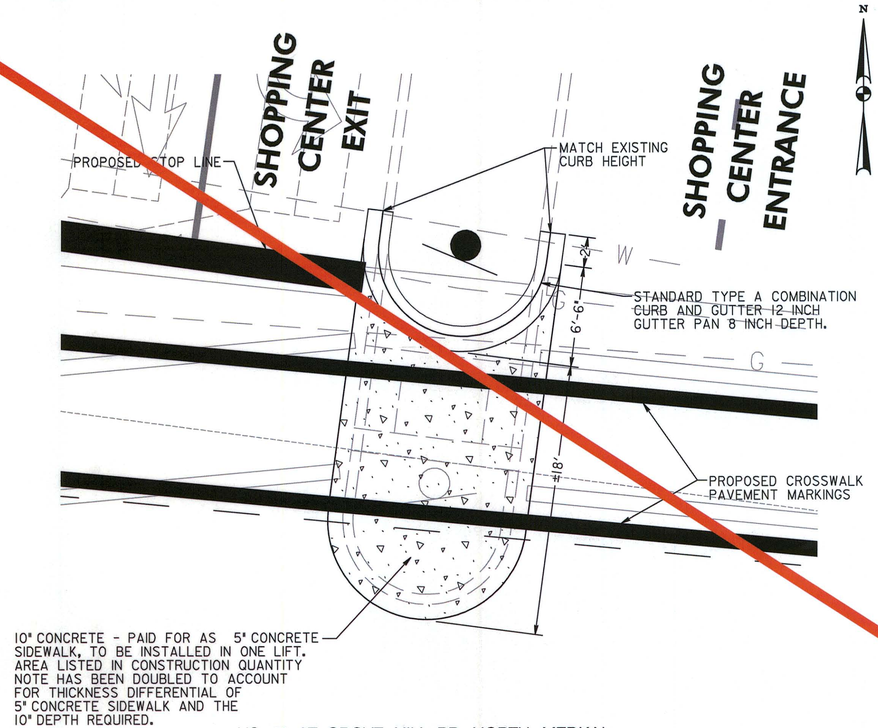

US 40 AT GROVE HILL RD NORTH MEDIAN

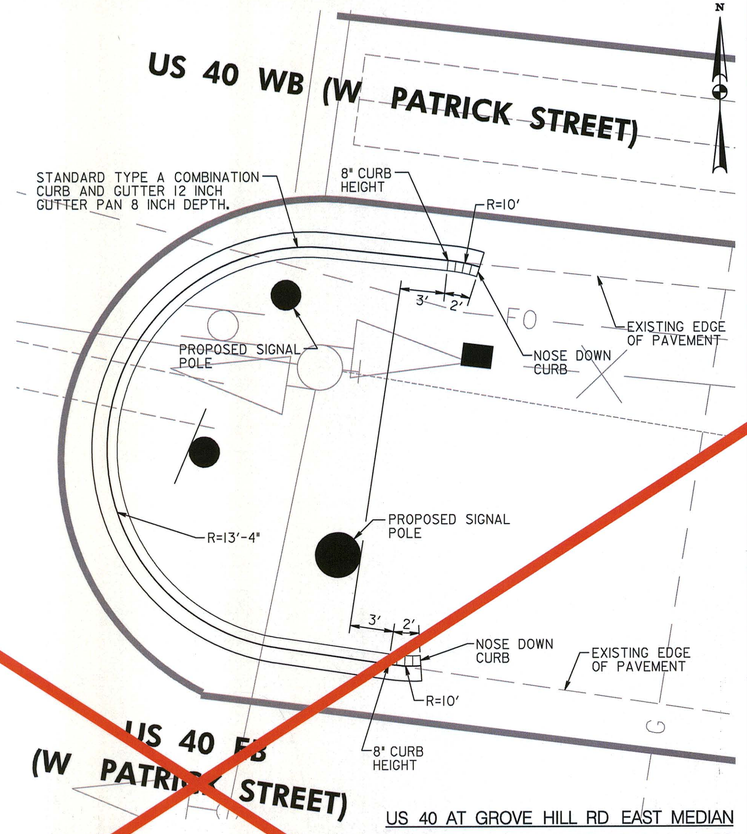

US 40 AT GROVE HILL RD EAST MEDIAN

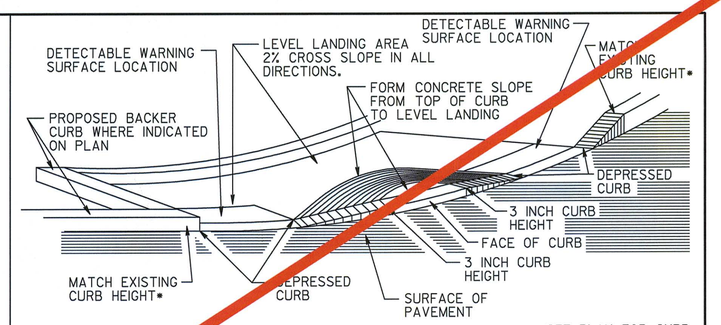

DETAIL A

ISOMETRIC VIEW
OF TYPICAL SLOPED CONCRETE ISLAND
SEE PLAN VIEW FOR DIMENSIONS
NOT TO SCALE

*SEE PLAN FOR CURB TRANSITION METHOD

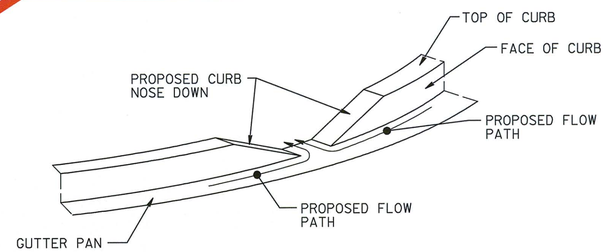

DETAIL B

ISOMETRIC VIEW
MEDIAN CURB DRAINAGE CUT THROUGH
SEE PLAN FOR ORIENTATION AND DIMENSIONS
NOT TO SCALE

NOTE: THE APPROXIMATE LOCATINO OF THE LOW POINT IS SHOWN ON PLAN FOR REFERENCE PURPOSES ONLY. THE CONTRACTOR IS RESPONSIBLE FOR FINDING THE LOW POINT IN THE MEDIAN AND INSTALLING THE MEDIAN CURB DRAINAGE CUT AT THAT LOCATION TO ENSURE POSITIVE DRAINAGE INTO THE MEDIAN.

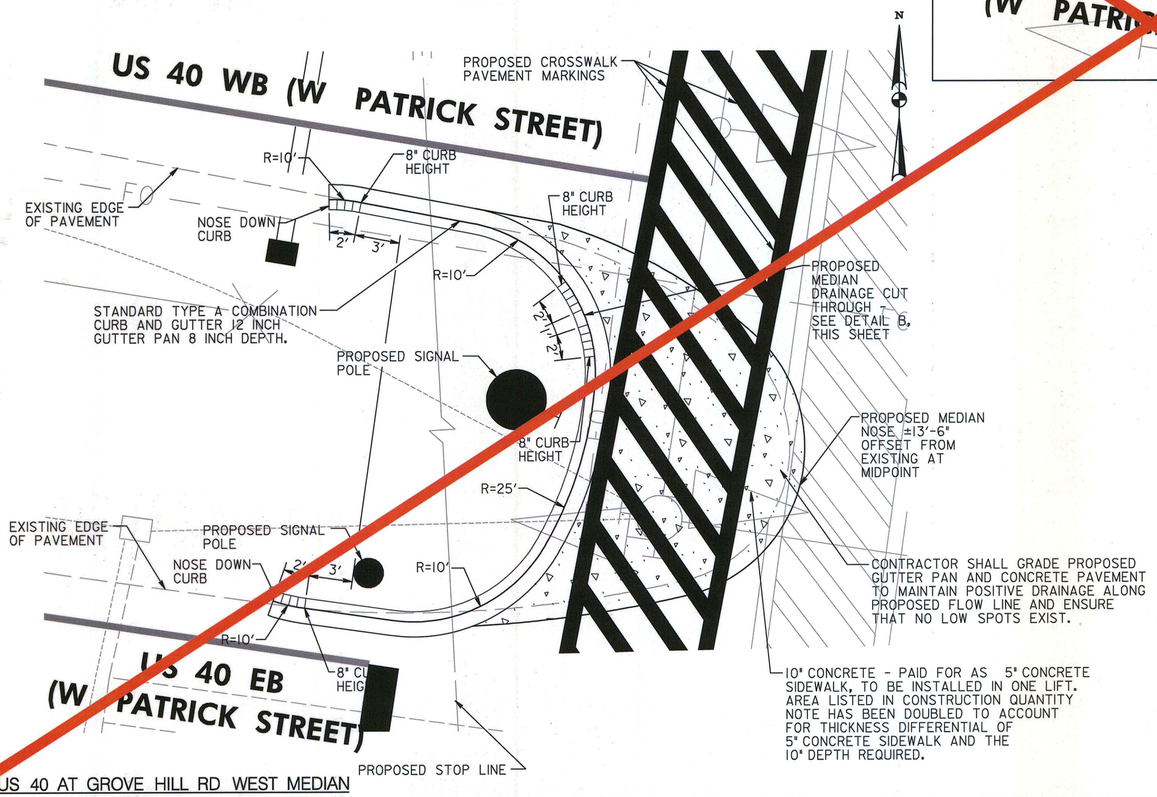

US 40 AT GROVE HILL RD WEST MEDIAN

SEE GENERAL NOTES ON SHEET DE-1

5 INCH CONCRETE SIDEWALK	
LOCATION	QUANTITY (SF)
NORTH MEDIAN	470
WEST MEDIAN	566

STANDARD TYPE A COMBINATION CURB AND GUTTER 12 INCH GUTTER PAN 8 INCH DEPTH SHA STD. NO. MD-620.02	
LOCATION	QUANTITY (LF)
NORTH MEDIAN	22
WEST MEDIAN	56
EAST MEDIAN	61

LEGEND

CONCRETE PAVEMENT

1 REDLINE NO. 1
JULY 2013
DELETE SHEET

RK&K
RUMMEL, KLEPPER & KAHL, LLP
81 MOSHER STREET | BALTIMORE, MD 21217
PH: (410) 728-2900 FAX: (410) 728-3160
Engineers | Construction Managers | Planners | Scientists
www.rkk.com

STATE OF MARYLAND
DEPARTMENT OF TRANSPORTATION
STATE HIGHWAY ADMINISTRATION

US 40 (W PATRICK ST) AT GROVE HILL RD FREDERICK, MARYLAND

RAMP DETAILS

SCALE	1" = 5'	DATE	MARCH 2013
CONTRACT NO.	XX6505185		
DESIGNED BY	JDG OF RK&K	COUNTY	FREDERICK
DRAWN BY	JBB OF RK&K	LOGMILE	10004011.92
CHECKED BY	ATD OF RK&K	TIMS NO.	L538
FAP NO.		TOD NO.	

TS NO. 3937B-DE	DRAWING DE-2 OF 2	SHEET NO. 4 OF 4

PLOTTED: Tuesday, March 19, 2013 AT 03:28 PM
FILE: K:\projects\2008\08148_tcddes\Task 129_US 40 Grove Hill\CADD\Plan\pDE-P002_US40-GroveHill.dgn

igolomb -