F.H.W.A. REGION NO.	STATE	FED. AID PROJ. NO.	SHEET NO.	TOTAL SHEETS
3	MD.		2	5

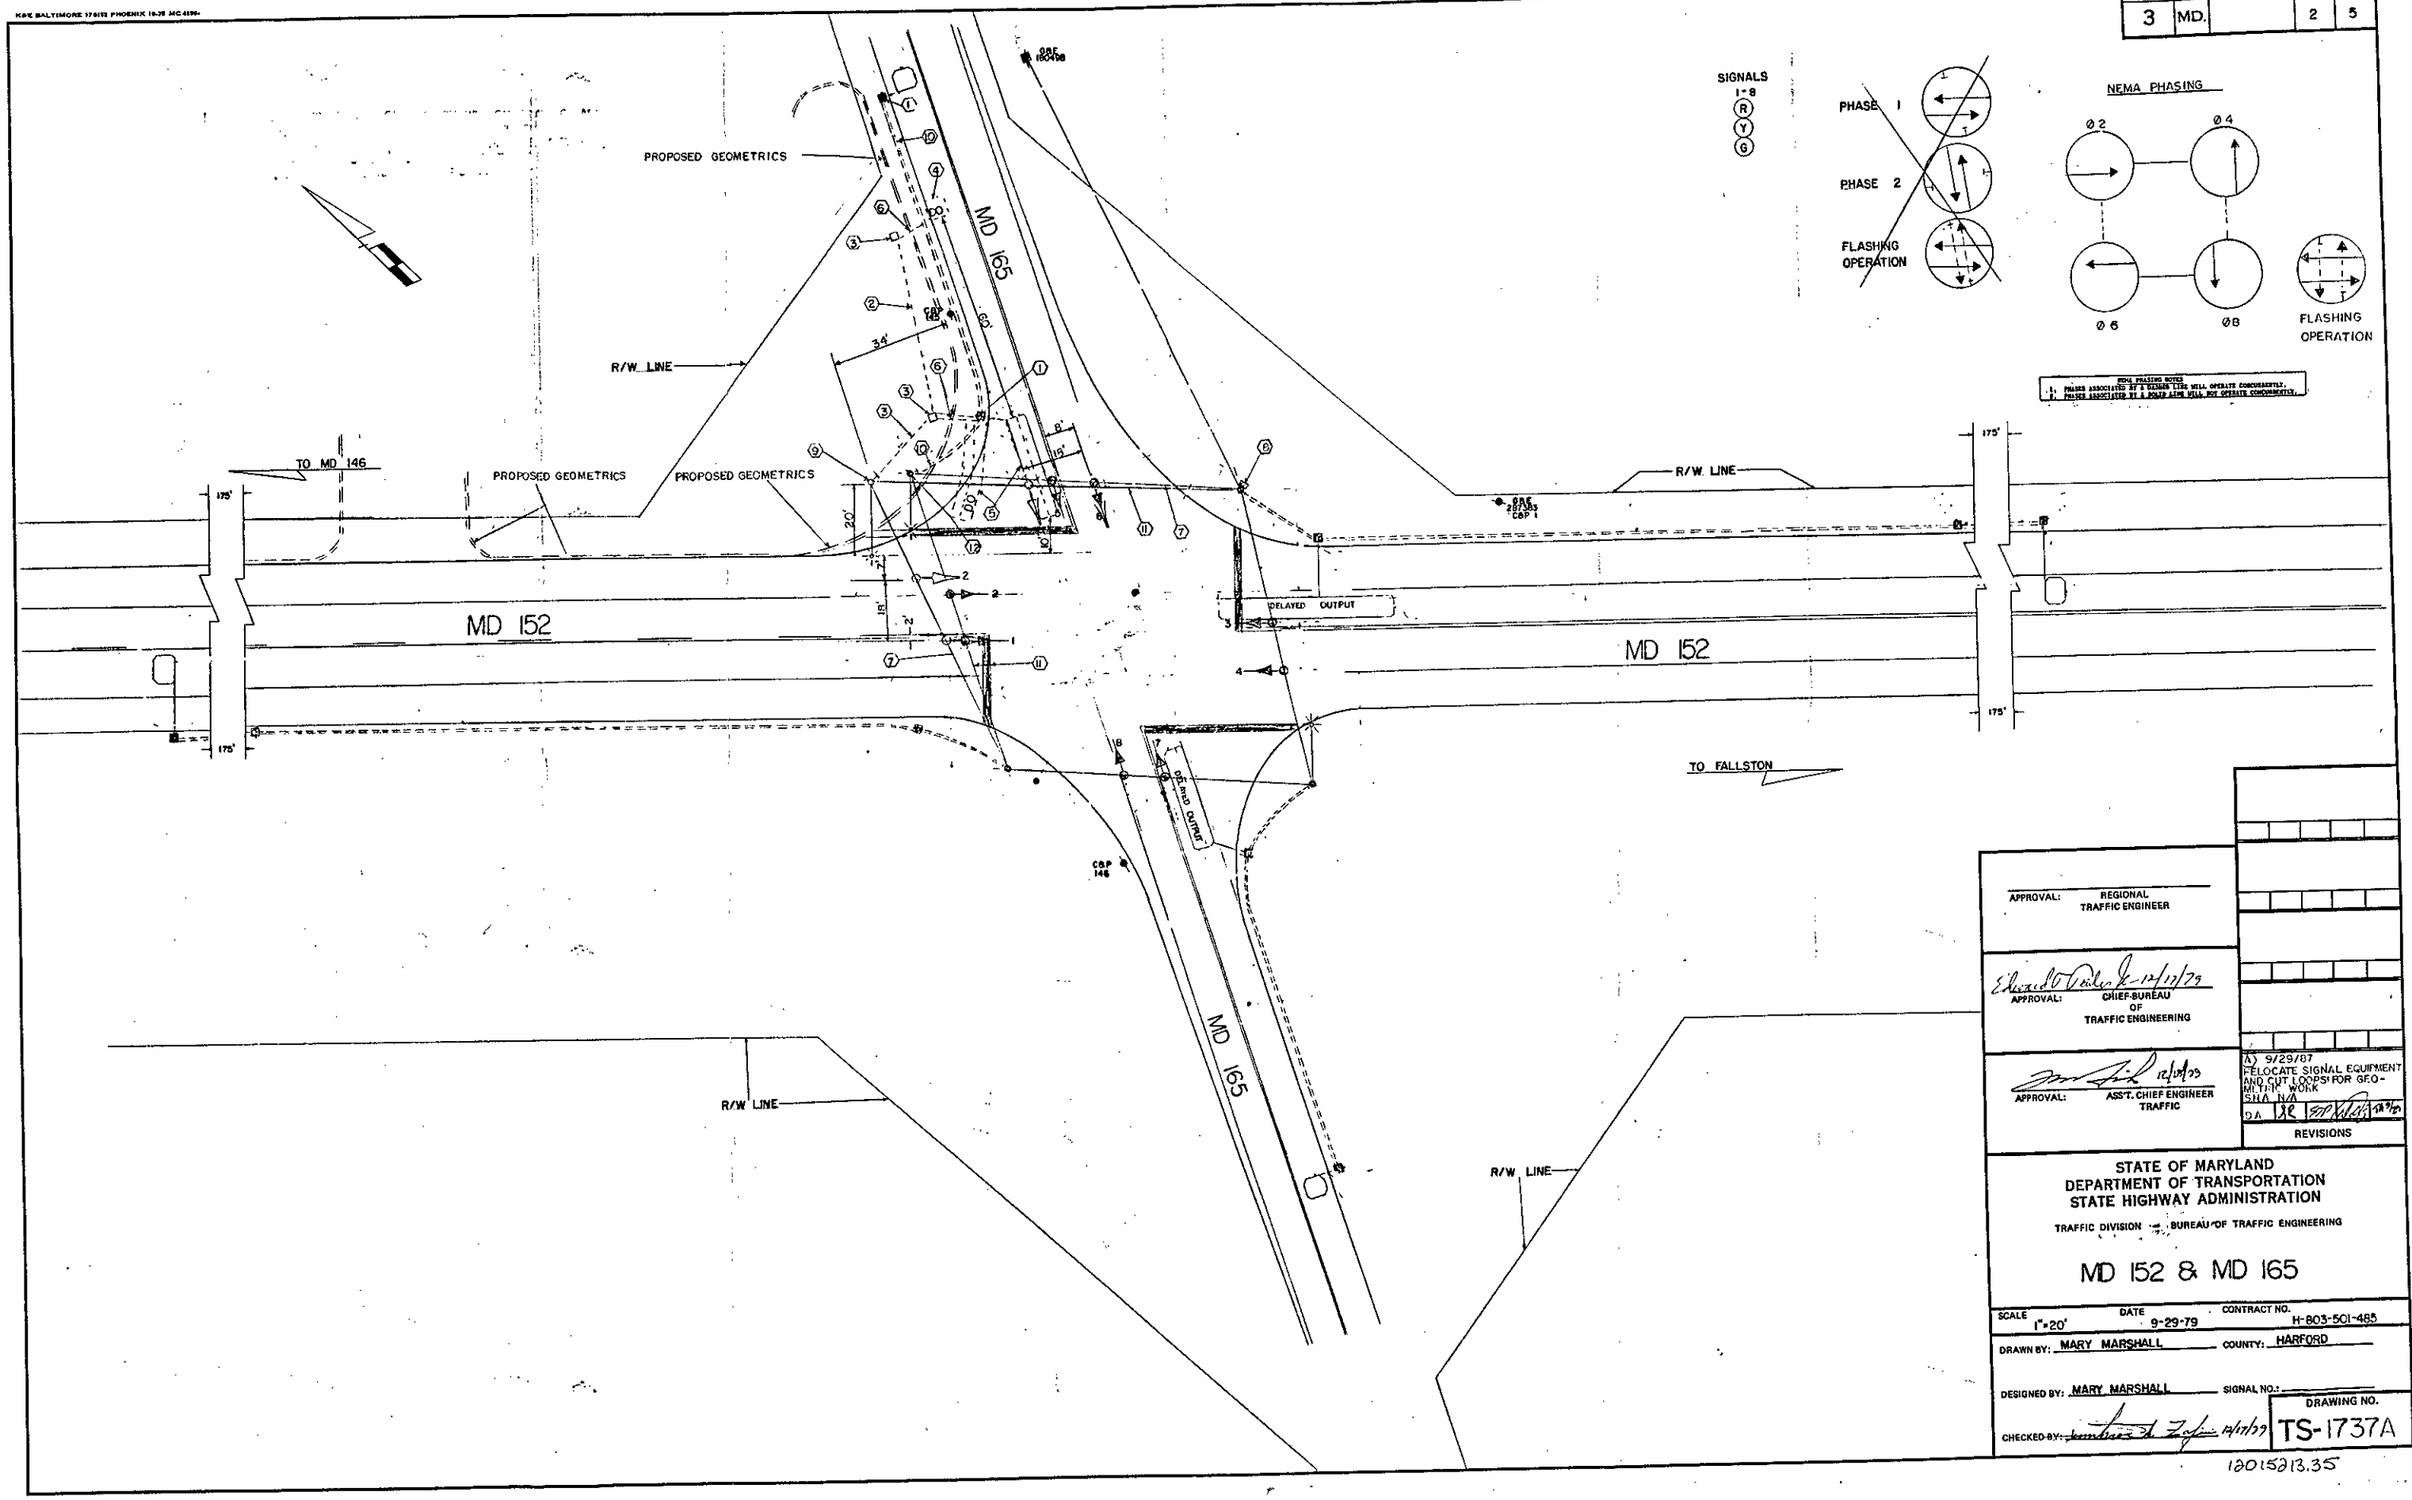

APPROVAL: REGIONAL TRAFFIC ENGINEER

APPROVAL: CHIEF-BUREAU OF TRAFFIC ENGINEERING 12/17/79

APPROVAL: ASS'T. CHIEF ENGINEER TRAFFIC 12/17/79

A) 9/29/87
RELOCATE SIGNAL EQUIPMENT AND CUT LOOPS FOR GEOMETRIC WORK
SHA N/A

REVISIONS

STATE OF MARYLAND
DEPARTMENT OF TRANSPORTATION
STATE HIGHWAY ADMINISTRATION

TRAFFIC DIVISION — BUREAU OF TRAFFIC ENGINEERING

MD 152 & MD 165

SCALE 1"=20' DATE 9-29-79 CONTRACT NO. H-803-501-485

DRAWN BY: MARY MARSHALL COUNTY: HARFORD

DESIGNED BY: MARY MARSHALL SIGNAL NO.:

CHECKED BY: 12/17/79

DRAWING NO. TS-1737A

12015213.35