F.H.WA. REGION NO.	STATE	FED. AID PROJ. NO.	SHEET NO.	TOTAL SHEETS
3	MD.	TQF-F-125-1(2)	8	16

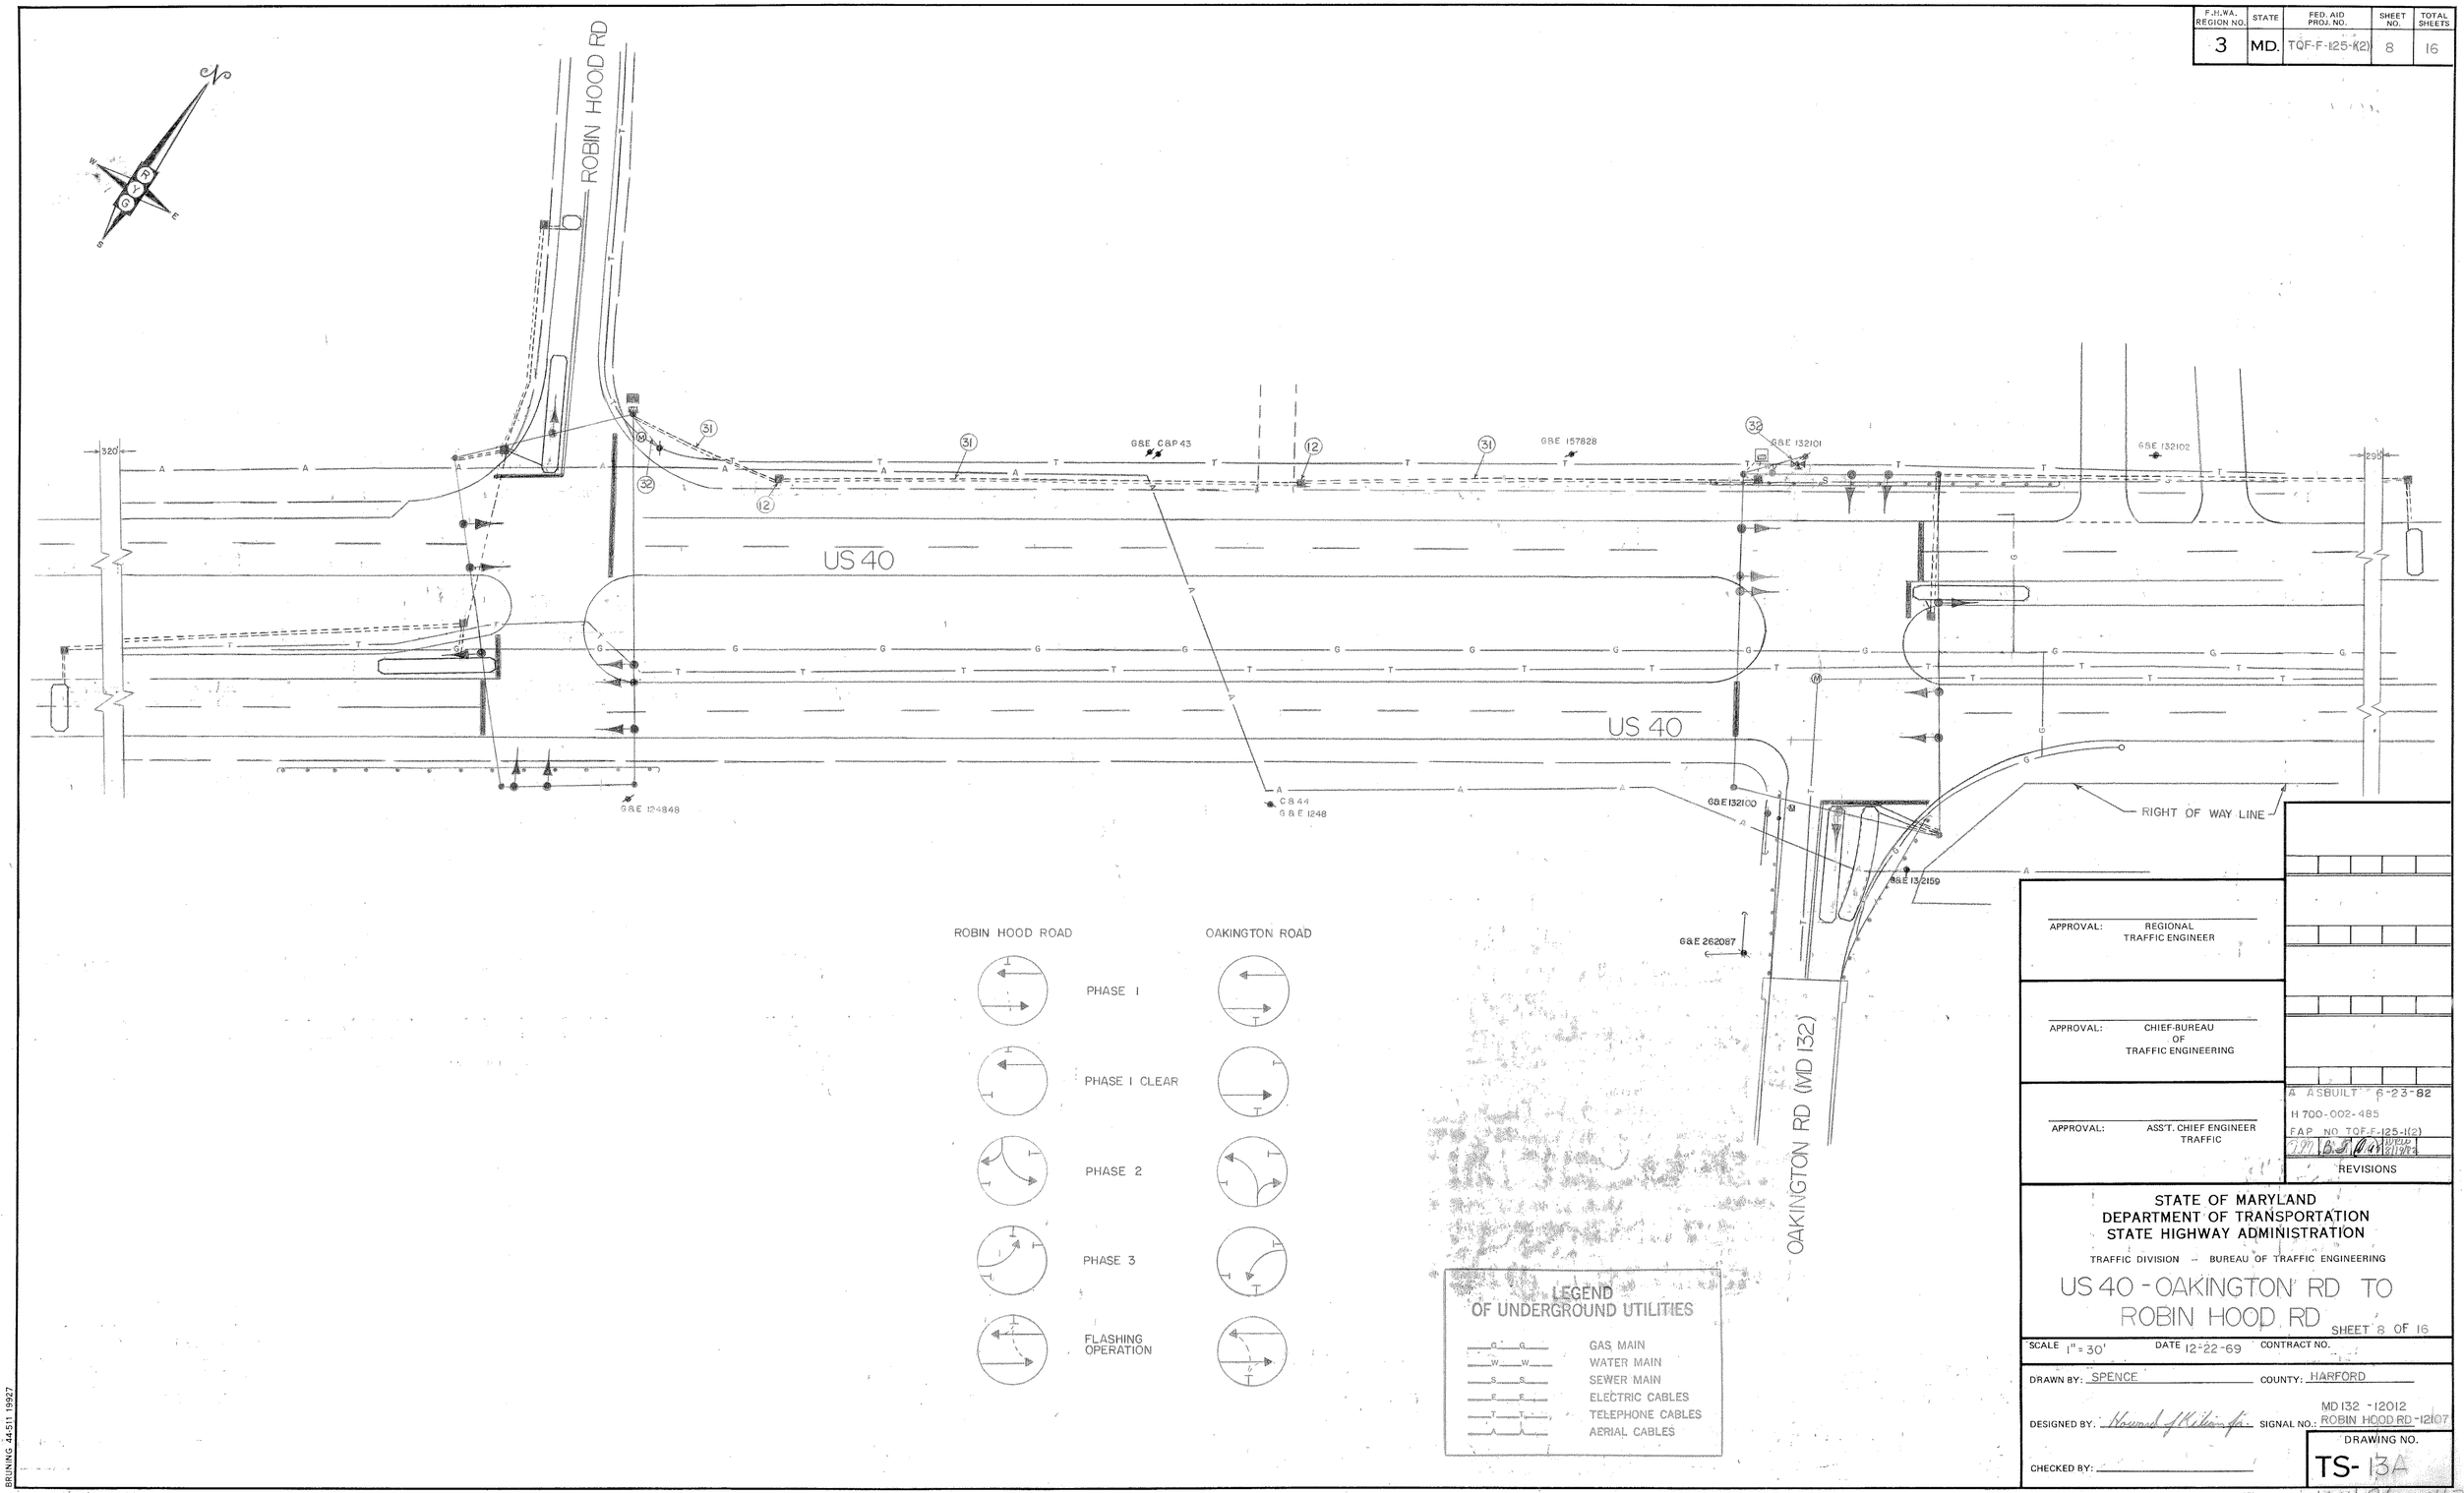

APPROVAL: REGIONAL TRAFFIC ENGINEER

APPROVAL: CHIEF-BUREAU OF TRAFFIC ENGINEERING

APPROVAL: ASS'T. CHIEF ENGINEER TRAFFIC

A ASBUILT 6-23-82
H 700-002-485
FAP NO. TQF-F-125-1(2)
REVISIONS

STATE OF MARYLAND
DEPARTMENT OF TRANSPORTATION
STATE HIGHWAY ADMINISTRATION

TRAFFIC DIVISION – BUREAU OF TRAFFIC ENGINEERING

US 40 - OAKINGTON RD TO ROBIN HOOD RD

SHEET 8 OF 16

SCALE 1" = 30' DATE 12-22-69 CONTRACT NO.

DRAWN BY: SPENCE COUNTY: HARFORD

DESIGNED BY: Howard J. Kilian Jr. SIGNAL NO.: MD 132 - 12012 ROBIN HOOD RD - 12107

CHECKED BY:

DRAWING NO. TS- 13A

BRUNING 44-511 19927