FHWA REGION NO	STATE	FED. AID PROJ. NO	SHEET NO.	TOTAL SHEETS
3	MD.			

SIGNALS

3 — R, Y, G — 12"

2,4–6 — R, Y, G — 12"

SIGNS

9 — LEFT TURN YIELD ON GREEN — R 10–12, 36" x 42"

10a,10b — ~~Belcamp Rd~~ Bata Blvd. — D3–2 Dual Faced Sign, 16" x Var.

NEMA PHASING

Flashing Operation

1.) Phases associated by a dashed line will operate concurrently.
2.) Phases associated by a solid line will not operate concurrently.

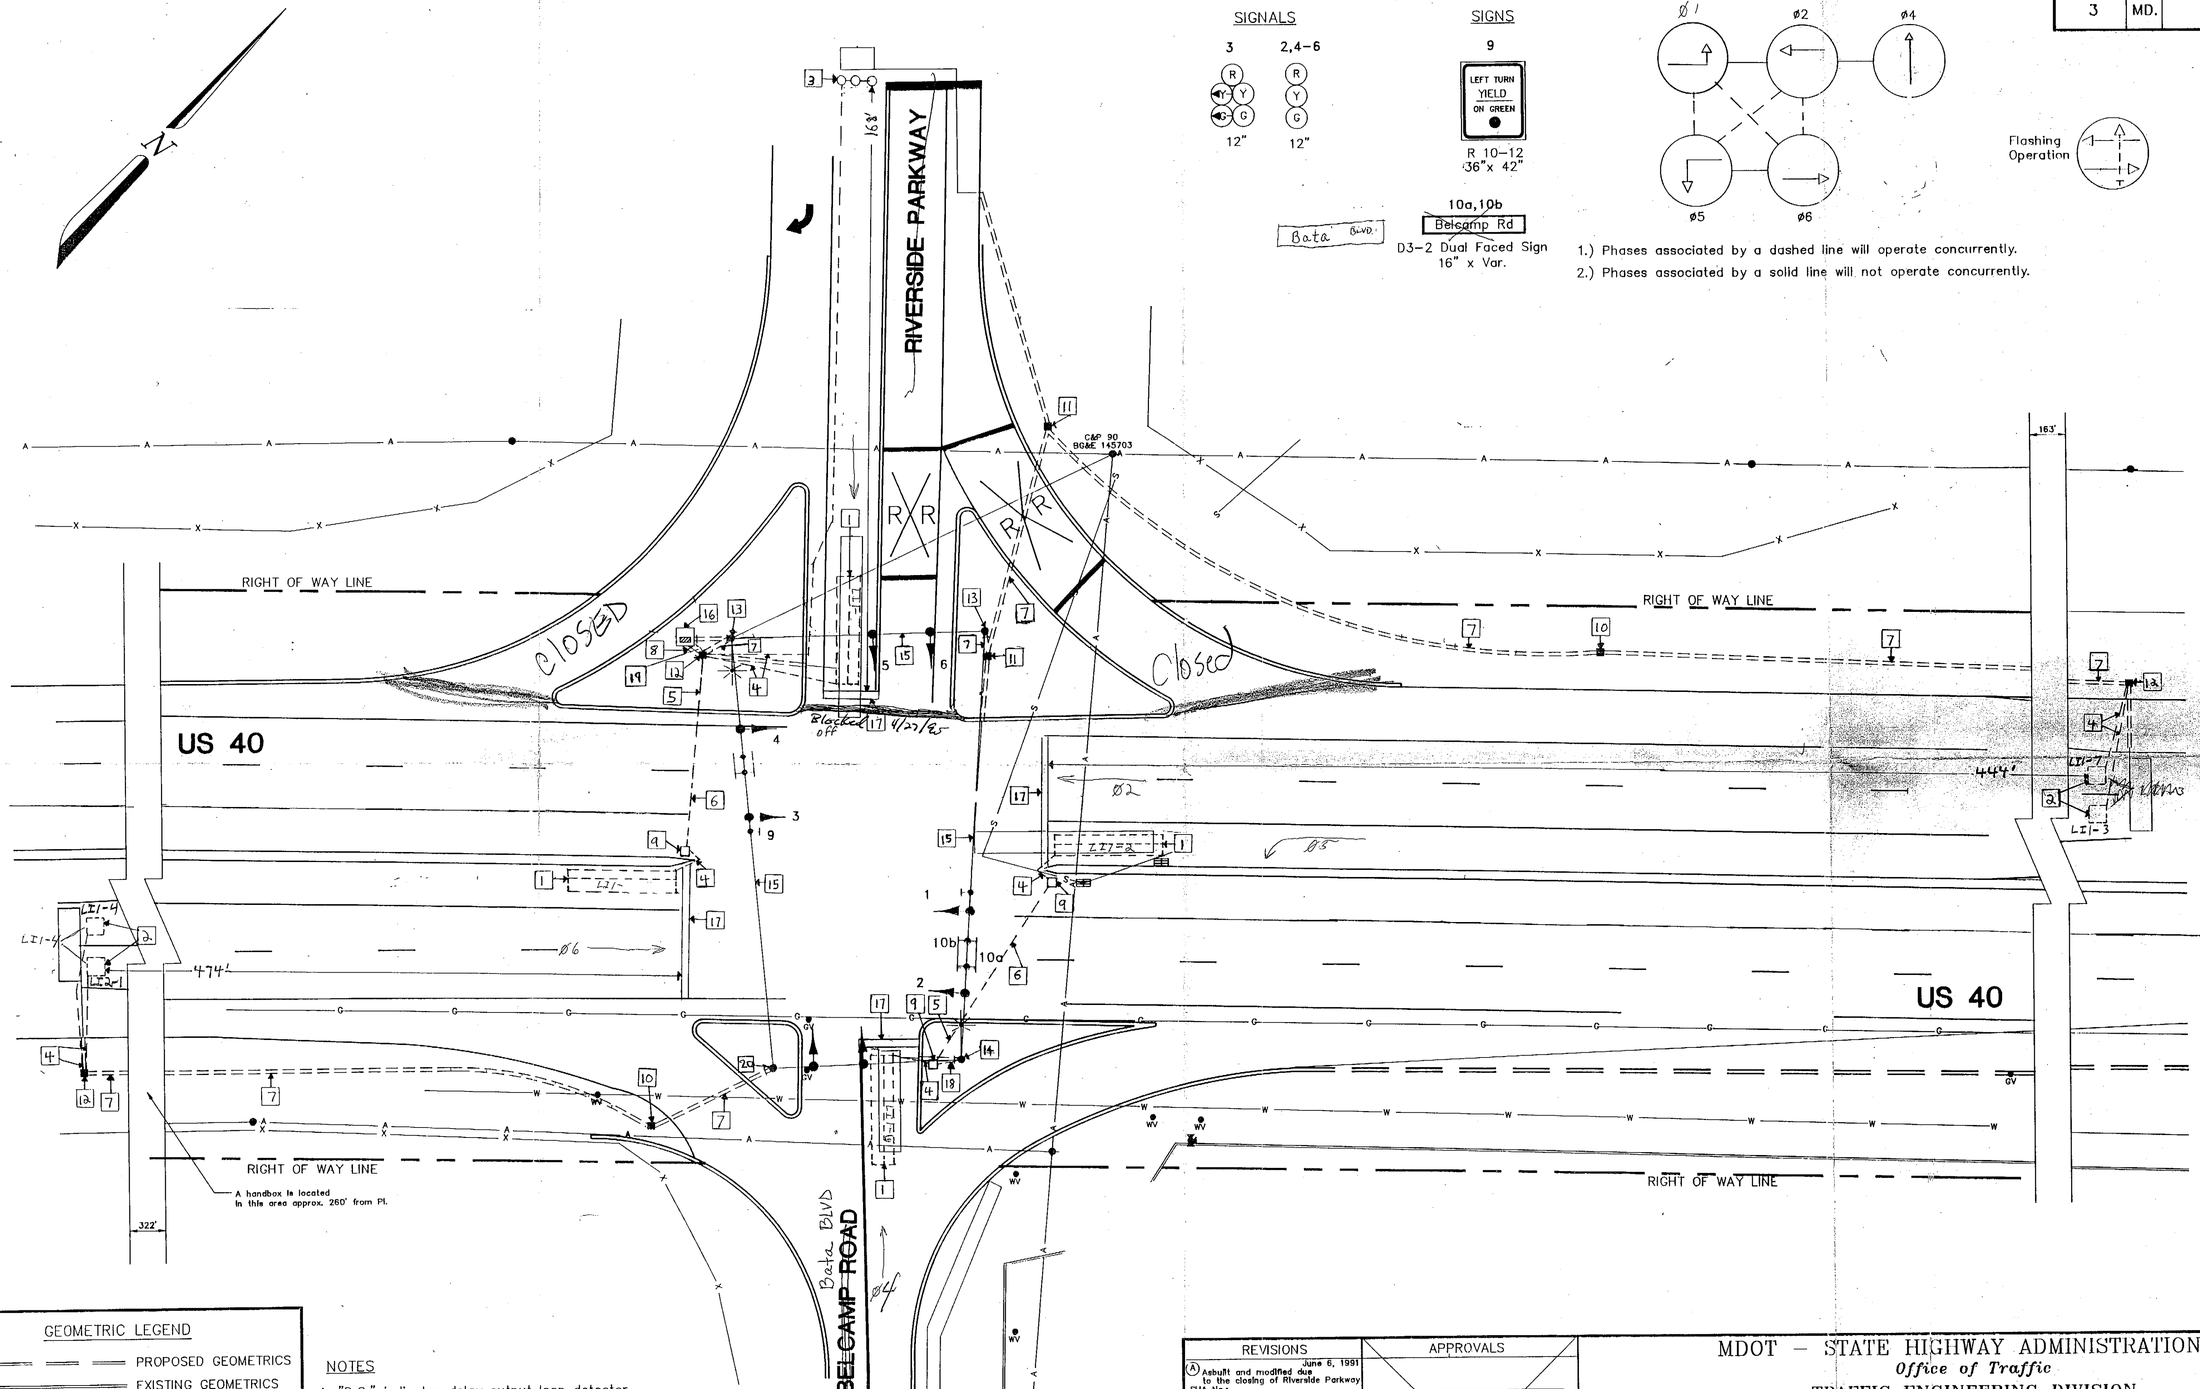

REVISION "A"

The Traffic Group

The Traffic Group, Inc.
Suite 600
40 W. Chesapeake Avenue
Towson, Maryland 21204
301-583-8405
Fax 301-321-8458

GEOMETRIC LEGEND

PROPOSED GEOMETRICS
EXISTING GEOMETRICS

UTILITY LEGEND

G — G	GAS MAIN
W — W	WATER MAIN
S — S	SEWER MAIN
E — E	ELECTRIC CABLES
D — D	STORM DRAIN
A — A	AERIAL CABLES
T — T	TELEPHONE CABLES

NOTES

1. "D.O." indicates delay output loop detector.
2. Geometrics shall be confirmed prior to the installation of signal equipment.
3. Loop detectors and conduit shall be installed prior to the installation of pavement markings.
4. Pavement markings that are detailed will be removed/or installed by the contractor in accordance with S.H.A. standards. All other pavement markings will be installed as part of the highway contract.
5. Revision 'A' is a revision to the traffic signal built in March, 1981 under Contract S.H.A. No.: BW–537–801–412.

REVISIONS

(A) June 6, 1991 — Asbuilt and modified due to the closing of Riverside Parkway
SHA No. 537-801-086
M.A.M. 14/19
(B) Revise Bacon Loop
SHA No. BW-537-801-086
FAP No. AC-CMS-STPG-0005(190)E
LLS

APPROVALS

CHIEF, SIGNAL DESIGN SECTION
ASST. DISTRICT ENGINEER, TRAFFIC
CHIEF, TRAFFIC ENGINEERING DIVISION
DEPUTY CHIEF ENGINEER, OFFICE OF TRAFFIC
ORIGINAL ON FILE

MDOT – STATE HIGHWAY ADMINISTRATION
Office of Traffic
TRAFFIC ENGINEERING DIVISION

LOG MILE # 12004008.26

DRAWN BY: J.W. GUCKERT
DES. BY: N/A
CHK. BY: N/A
DATE: March 5, 1981
SCALE: 1" = 20'

US 40 and ~~RIVERSIDE PARKWAY/~~ ~~BELCAMP ROAD~~ Bata BLVD.

COUNTY: HARFORD

F.A.P. NO. N/A
S.H.A. NO. BW–537–801–412

TS/STD. NO. 1819B

SHEET NO. ____ OF ____