F.H.W.A. REGION NO.	STATE	FED. AID PROJ. NO.	SHEET NO.	TOTAL SHEETS
3	MD.	TQF-F-125-1(2)	8	16

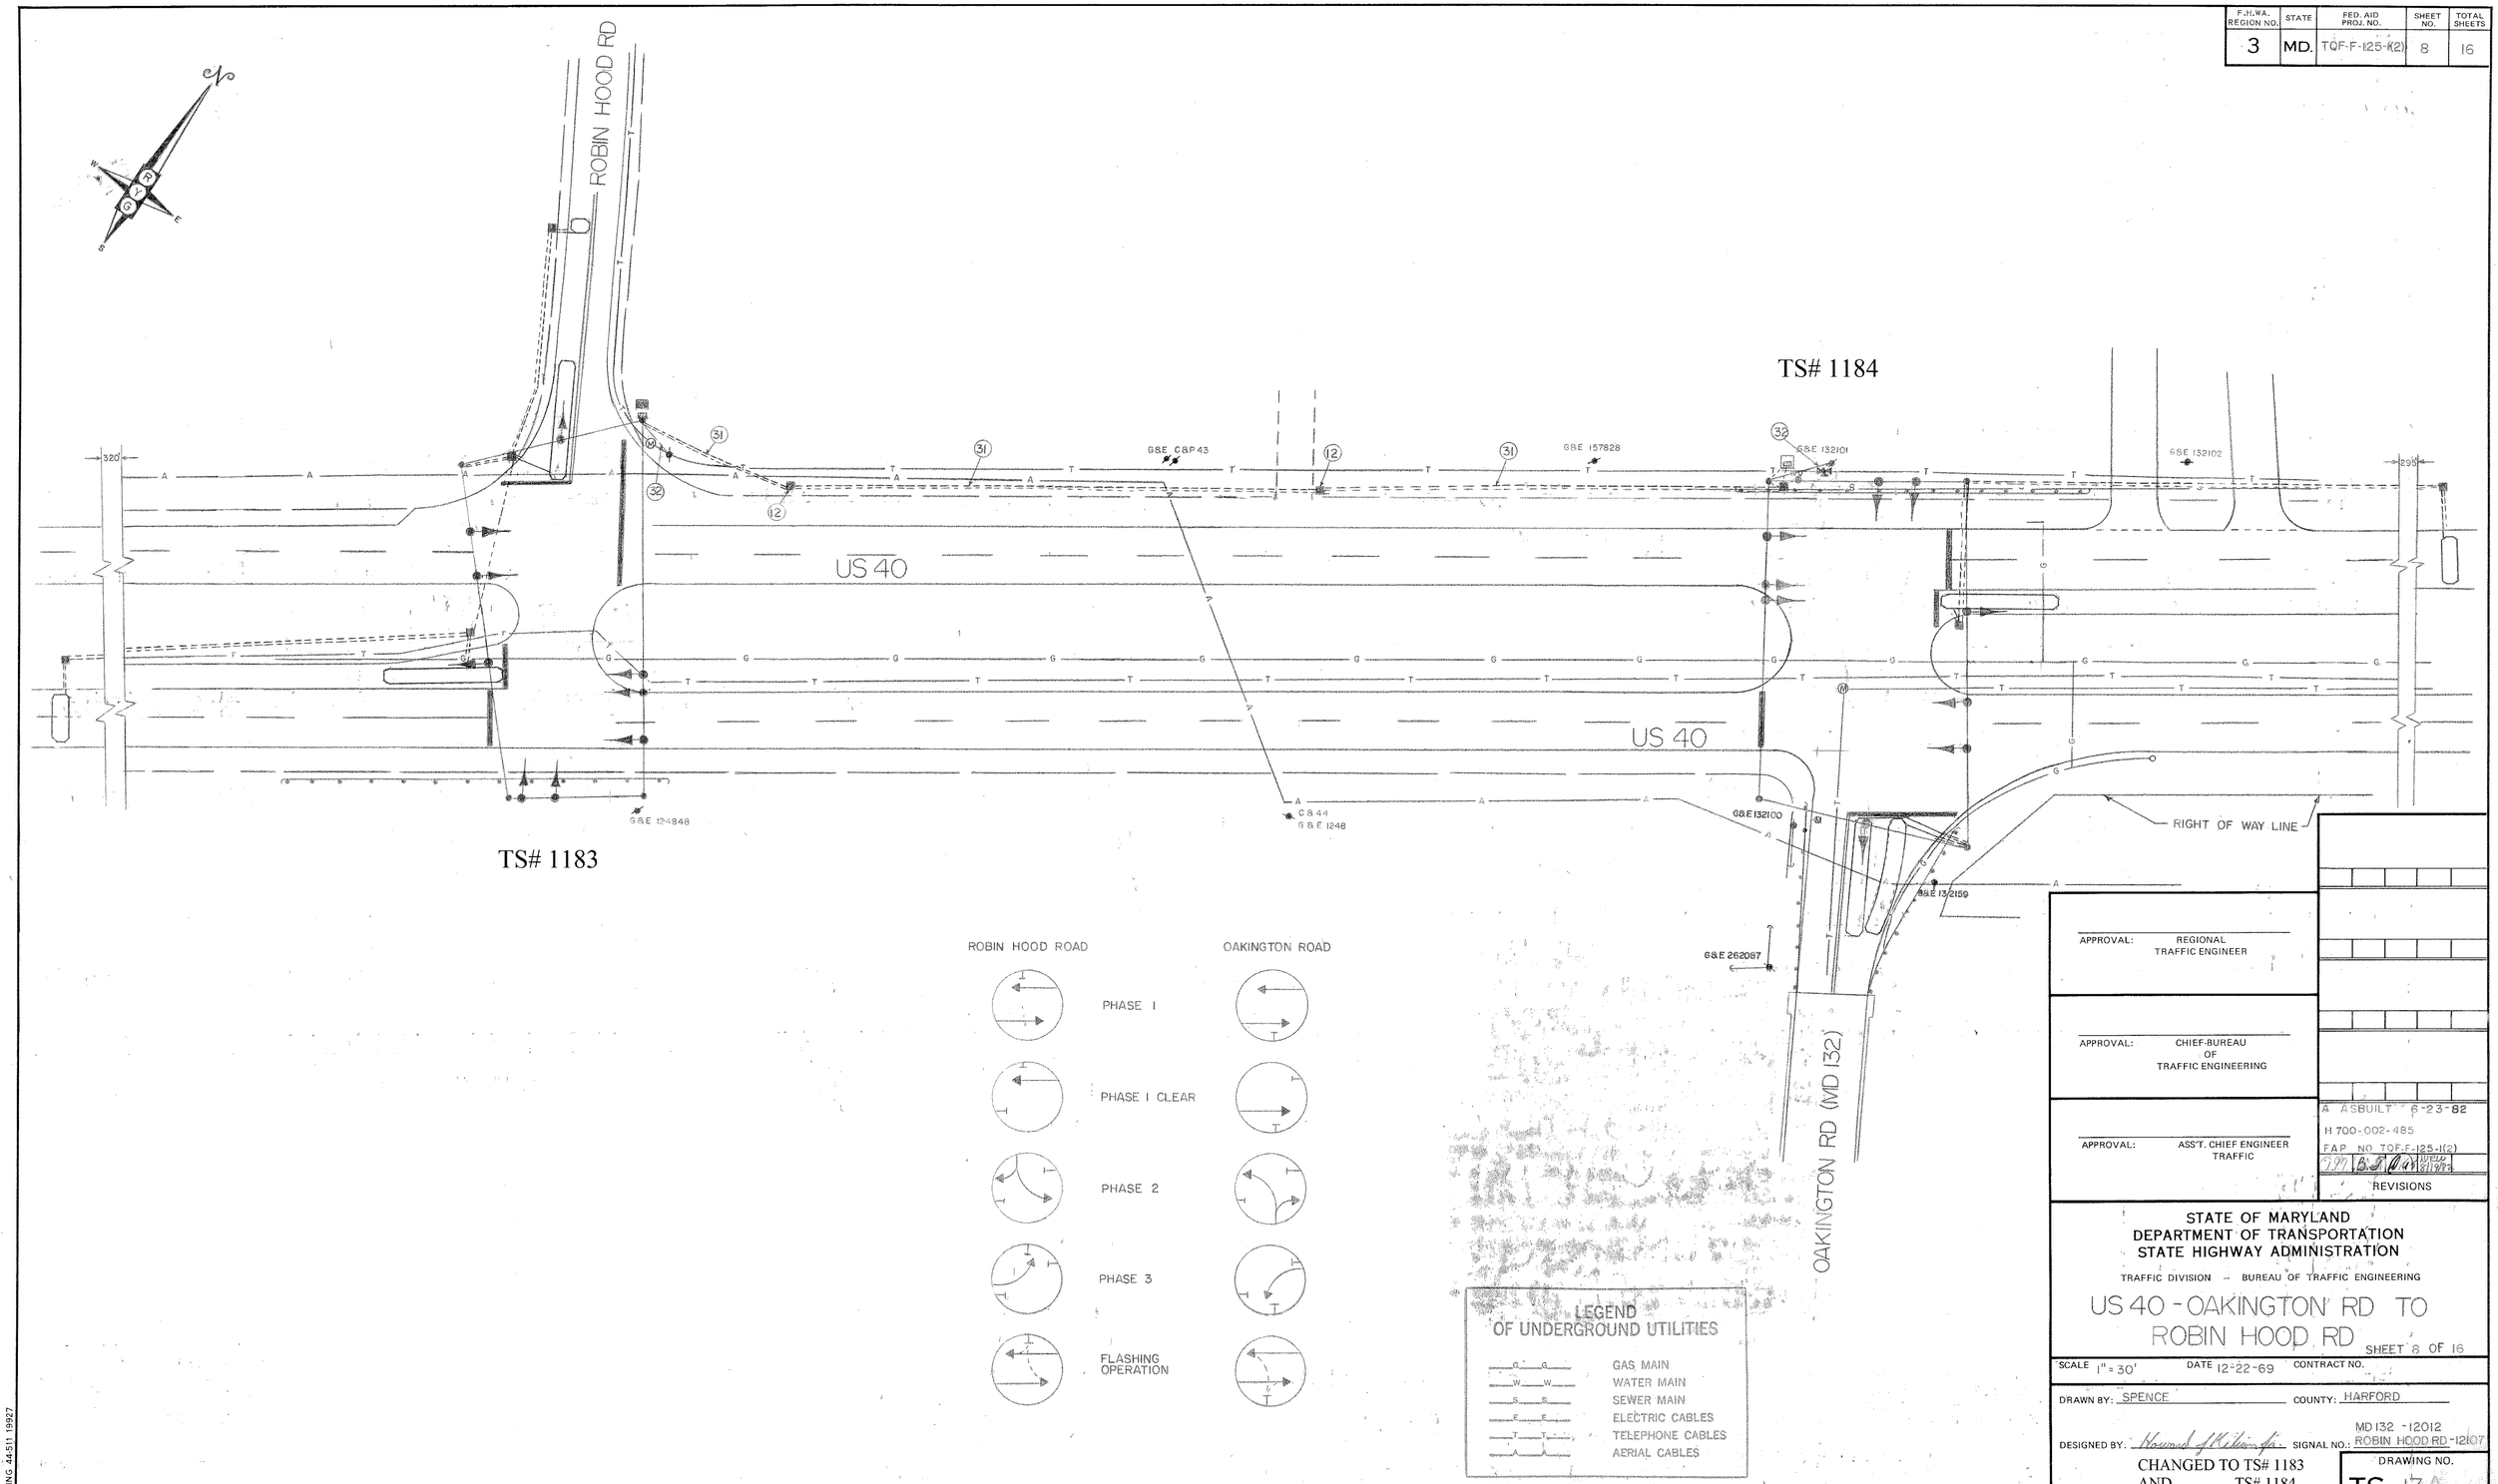

APPROVAL: REGIONAL TRAFFIC ENGINEER

APPROVAL: CHIEF-BUREAU OF TRAFFIC ENGINEERING

APPROVAL: ASS'T. CHIEF ENGINEER TRAFFIC

A ASBUILT 6-23-82

H 700-002-485

FAP NO TQF-F-125-1(2)

REVISIONS

STATE OF MARYLAND
DEPARTMENT OF TRANSPORTATION
STATE HIGHWAY ADMINISTRATION

TRAFFIC DIVISION – BUREAU OF TRAFFIC ENGINEERING

US 40 - OAKINGTON RD TO ROBIN HOOD RD

SHEET 8 OF 16

SCALE 1" = 30' DATE 12-22-69 CONTRACT NO.

DRAWN BY: SPENCE COUNTY: HARFORD

DESIGNED BY: Howard J. Klein Jr. SIGNAL NO.: MD 132 - 12012 ROBIN HOOD RD - 12107

CHANGED TO TS# 1183 AND TS# 1184

CHECKED BY:

DRAWING NO. TS- ~~13A~~

BRUNING 44-511 19927