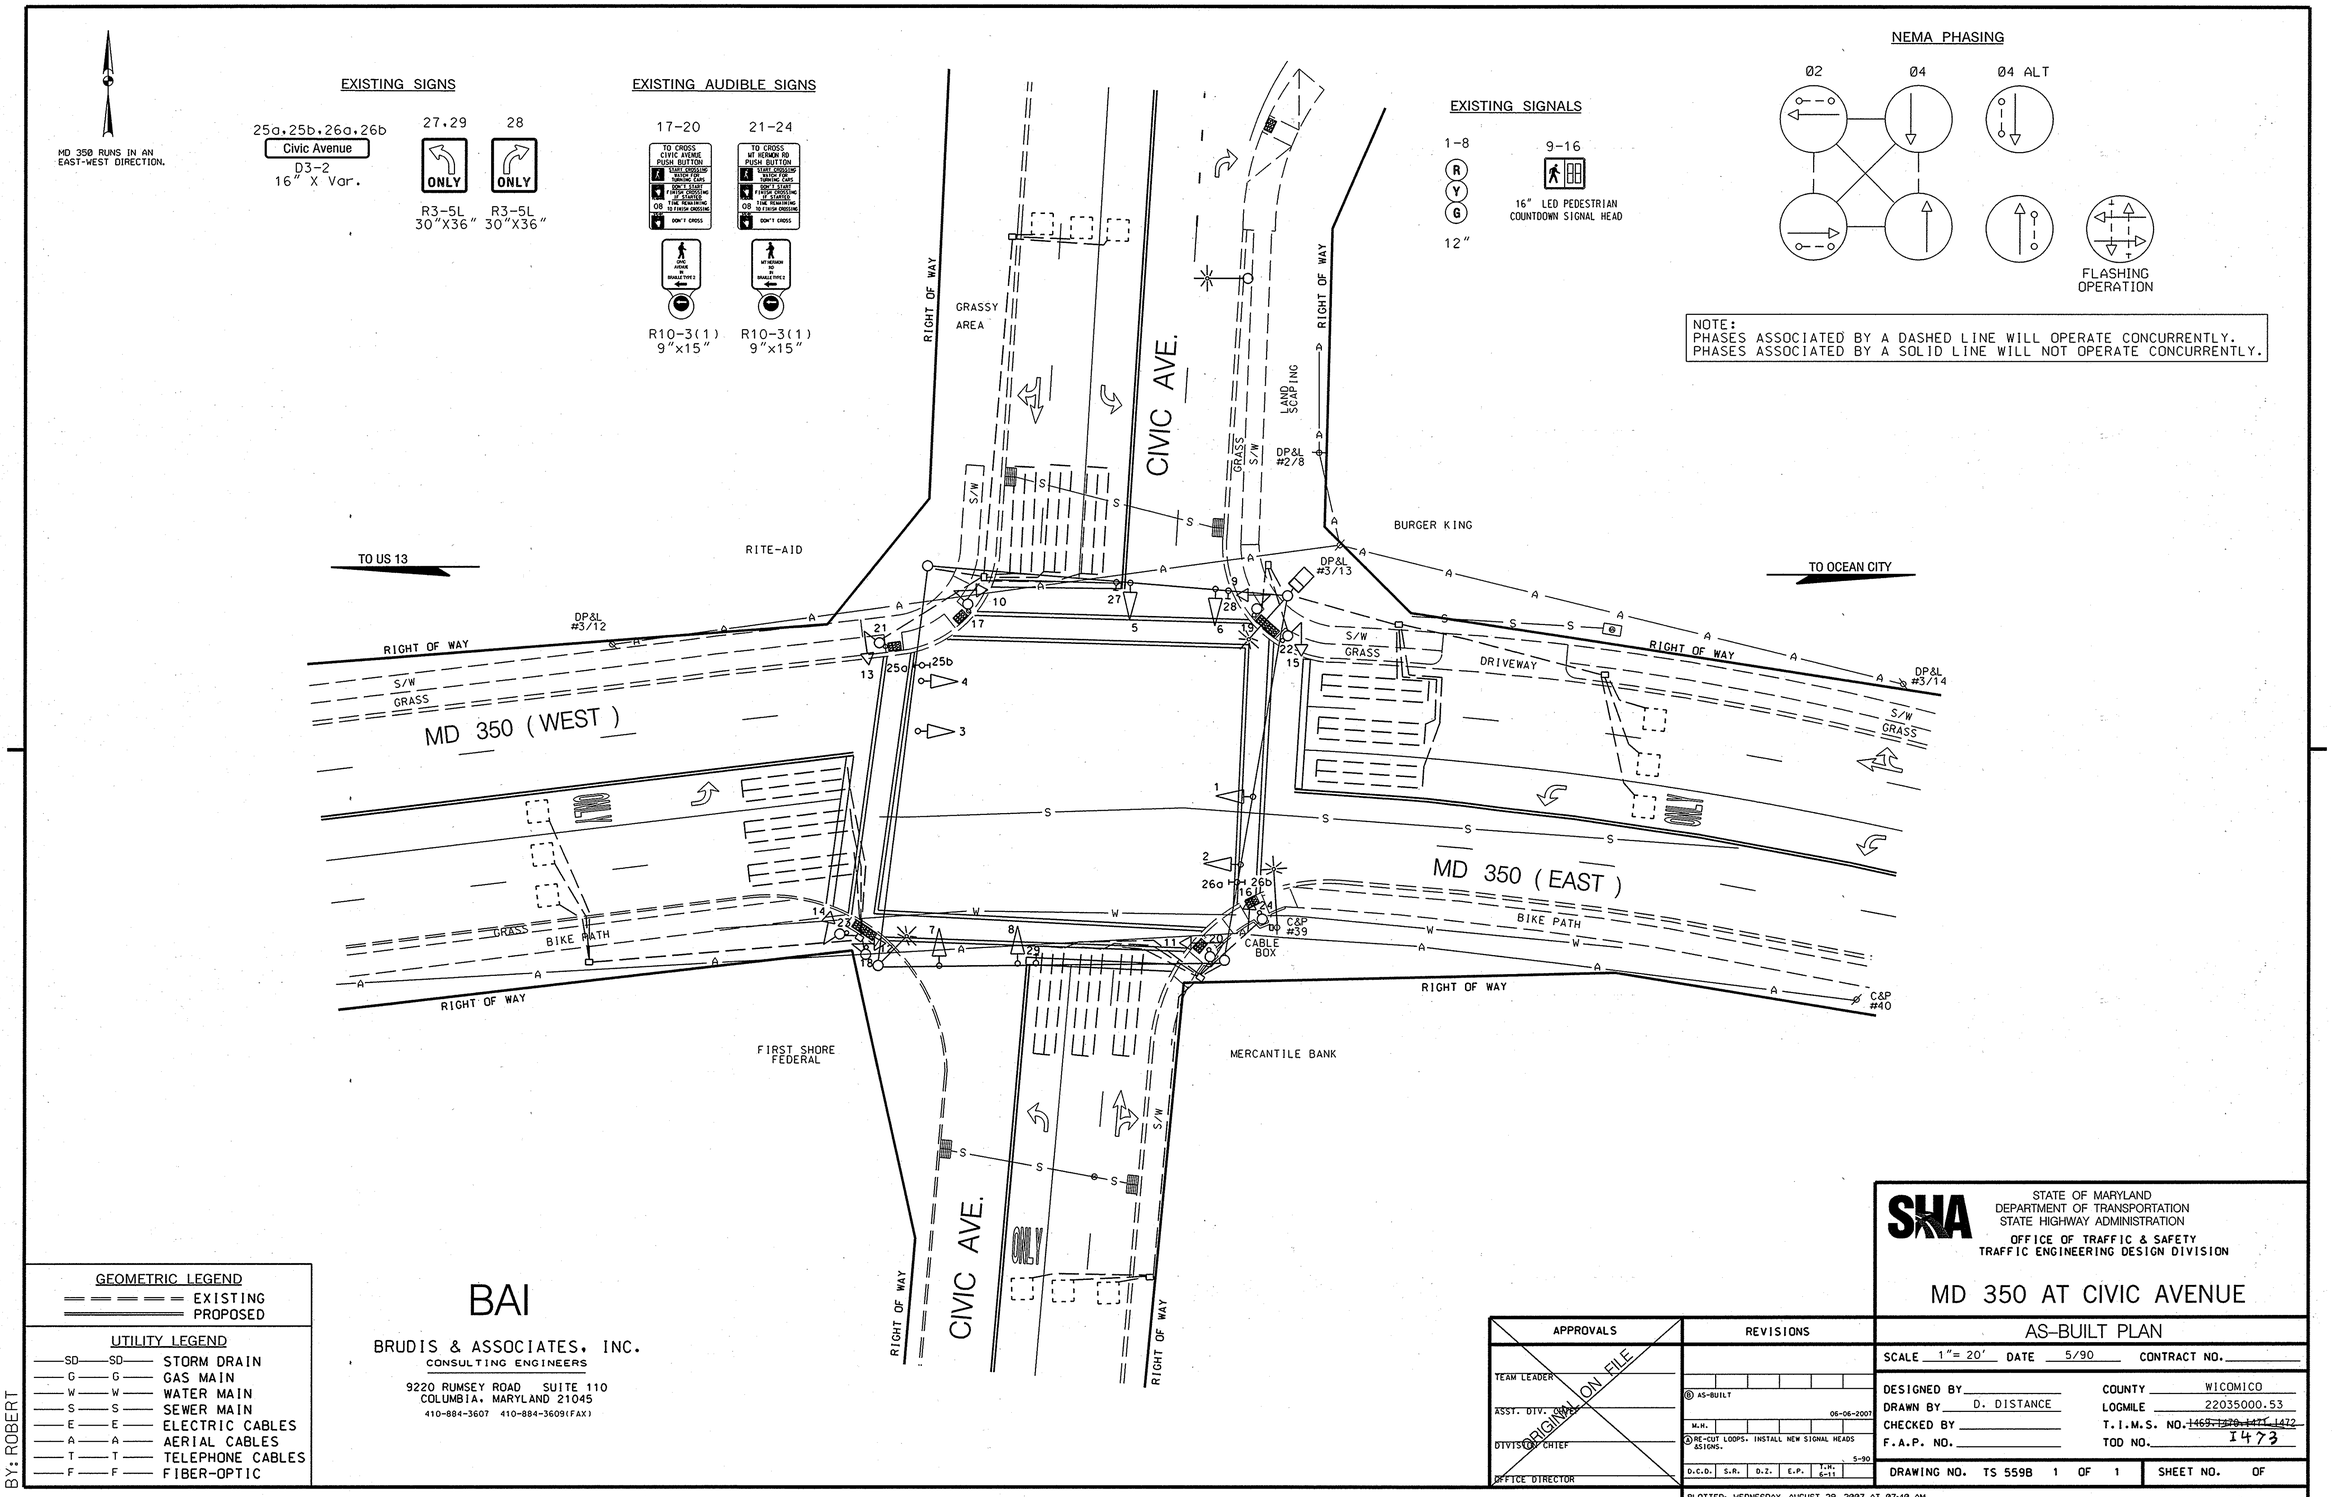

STATE OF MARYLAND
DEPARTMENT OF TRANSPORTATION
STATE HIGHWAY ADMINISTRATION
OFFICE OF TRAFFIC & SAFETY
TRAFFIC ENGINEERING DESIGN DIVISION

MD 350 AT CIVIC AVENUE

AS-BUILT PLAN

SCALE 1"= 20' DATE 5/90 CONTRACT NO.

DESIGNED BY
DRAWN BY D. DISTANCE
CHECKED BY
F.A.P. NO.
COUNTY WICOMICO
LOGMILE 22035000.53
T.I.M.S. NO. ~~1469, 1470, 1471, 1472~~ 1473
TOD NO.

DRAWING NO. TS 559B 1 OF 1 SHEET NO. OF

PLOTTED: WEDNESDAY, AUGUST 29, 2007 AT 07:40 AM
FILE: P:\04-005 SIGNALS\US 50 APS\DRAWINGS\US 50 APS ASBUILTS\MD 350 & CIVIC\MSG-P007_MD350@CIVIC.DGN