F H WA REGION NO	STATE	FED. AID PROJ. NO	SHEET NO.	TOTAL SHEETS
3	MD.			

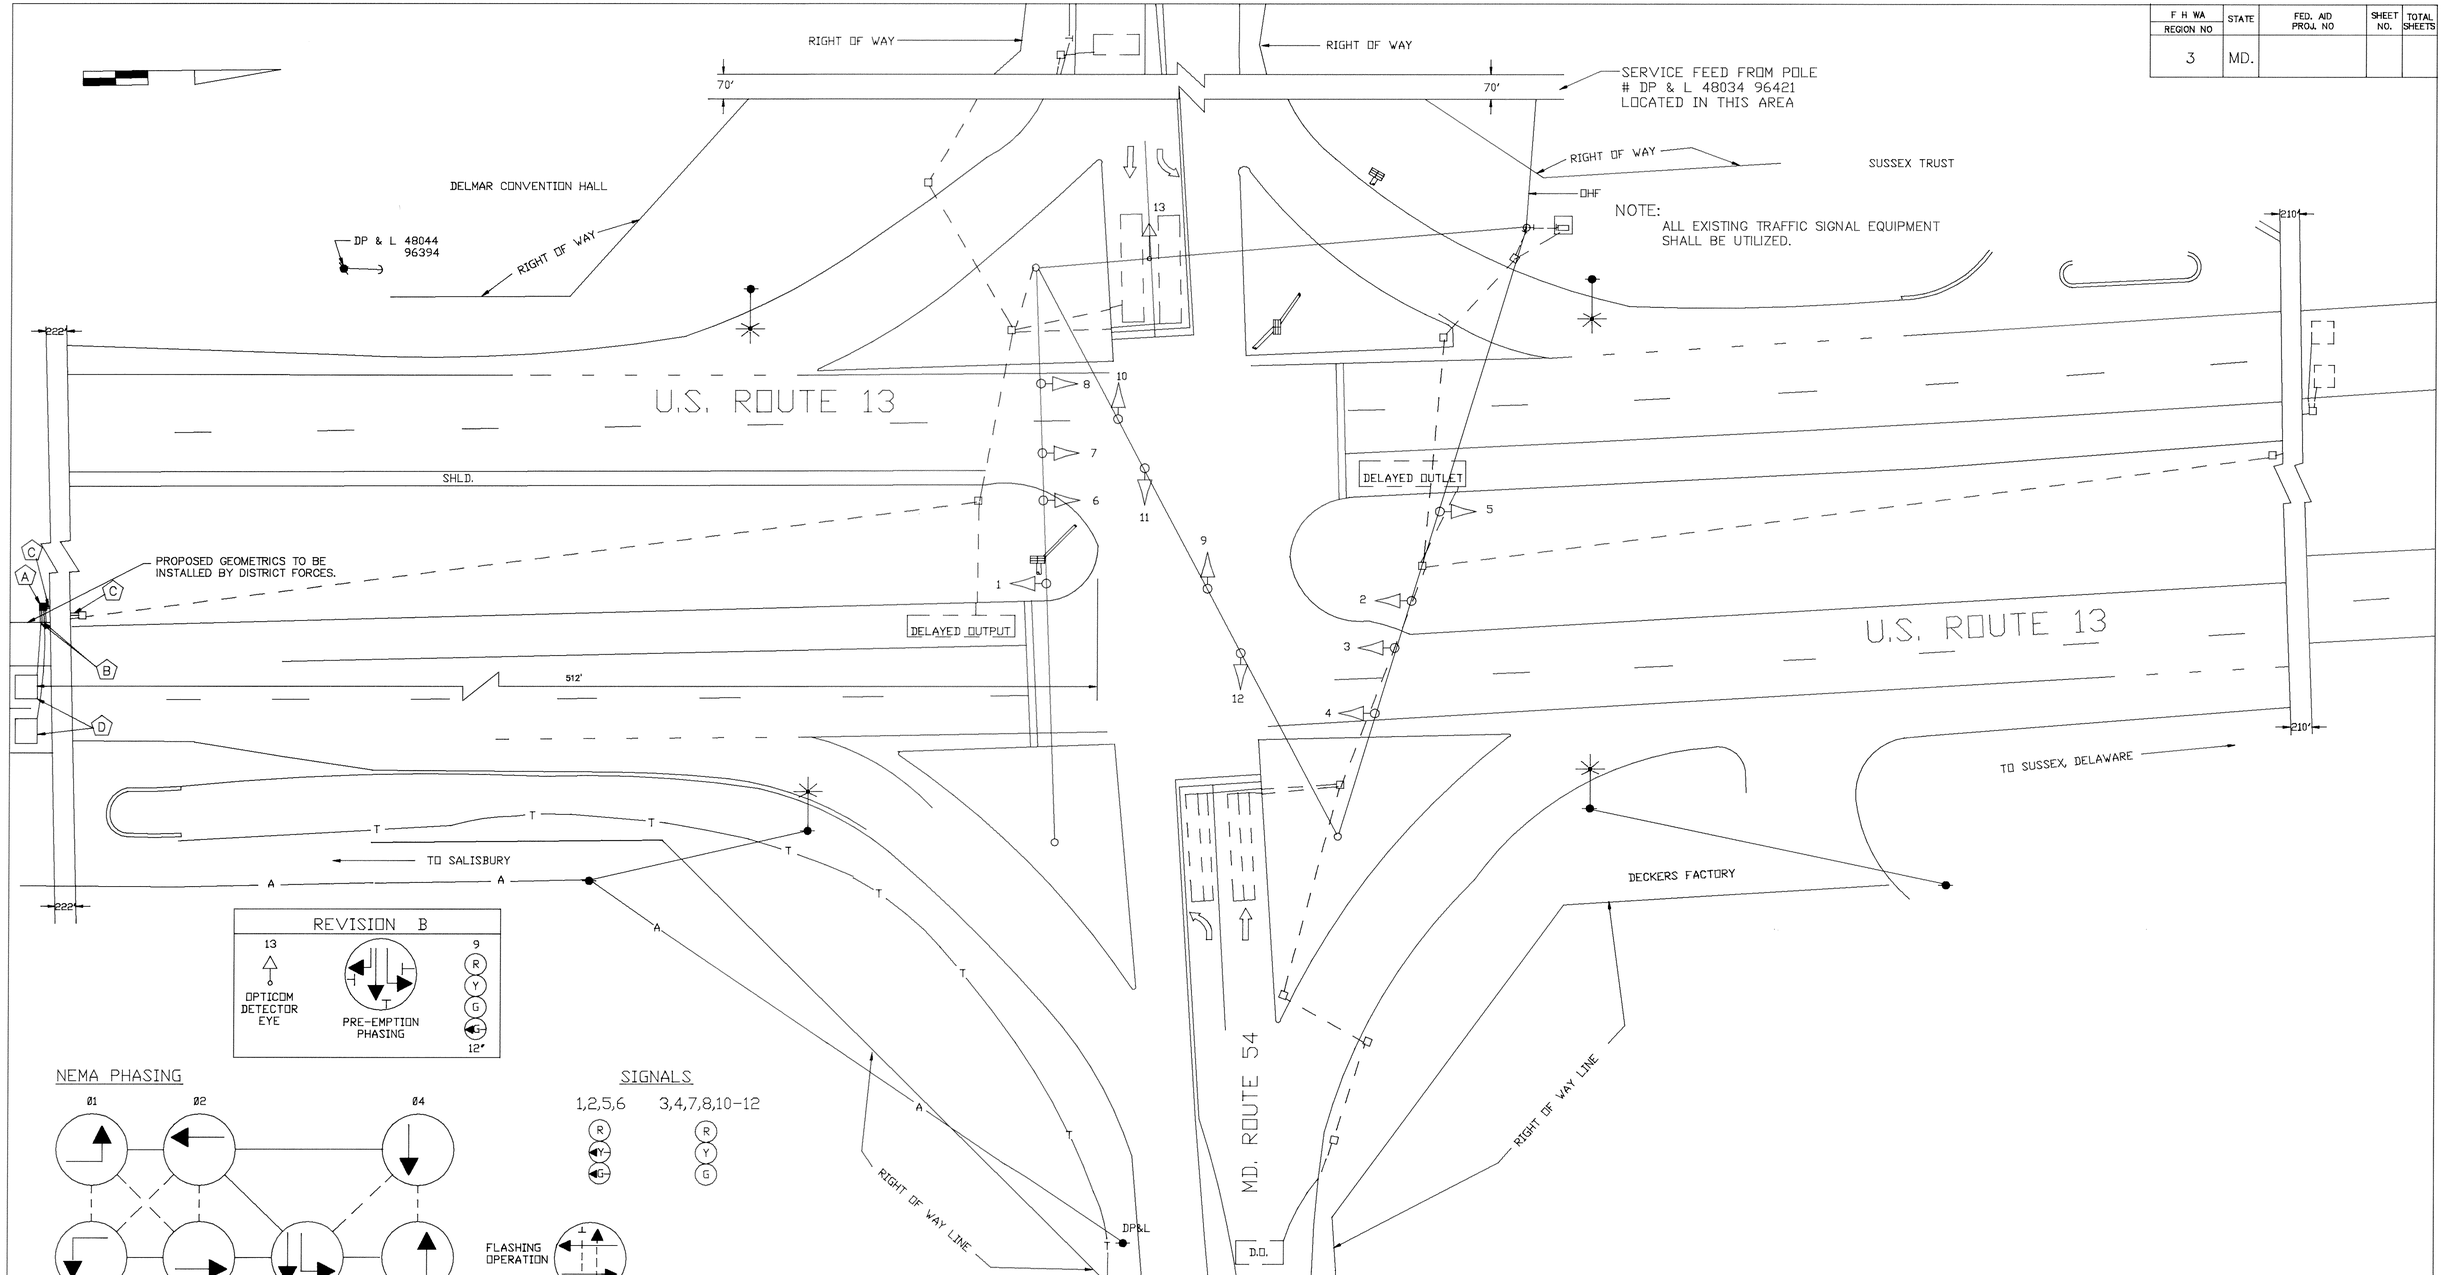

UTILITY LEGEND

—G—G—	GAS MAIN
—W—W—	WATER MAIN
—S—S—	SEWER MAIN
—E—E—	ELECTRIC CABLES
—A—A—	AERIAL CABLES
—T—T—	TELEPHONE CABLES

REVISIONS	APPROVALS
D 2/95 INSTALL N/B LOOP DETECTORS DUE GEOMETRIC IMPROVEMENTS.	CHIEF, DESIGN SECTION
C 7-24-92 RE-CUT Ø 8 FRONT LOOPS, W/B MD54, SHA NO. 855-25046	ASST. DISTRICT ENGINEER, TRAFFIC
DR RCS	CHIEF, BUREAU OF TRAFFIC ENGINEERING
B 02/89 - ADD OPTICOM PRE-EMPTION PHASING	DEPUTY CHIEF ENGINEER, OFFICE OF TRAFFIC
WM	
A. AS BUILT 7/21/82 WI-607-501-185	
KM	

THIS IS A REVISION TO THE ORIGINAL CONTRACT COMPLETED UNDER SHA NO. WI-607-501-185. THE ORIGINAL PLAN IS ON FILE.

MARYLAND DEPARTMENT OF TRANSPORTATION
STATE HIGHWAY ADMINISTRATION – OFFICE OF TRAFFIC
BUREAU OF TRAFFIC ENGINEERING

REDRAWN BY: ~~DRAWN BY~~ W. MALCOLM
REDES. BY: ~~DES. BY:~~ W. MALCOLM
CHK. BY:

U.S. 13 & MD. 54
(MARYLAND DELAWARE LINE ROAD)

ACAD
COUNTY: WICOMICO

DATE: 03/89
SCALE: 1" = 20'
F.A.P. NO.
S.H.A. NO. WI-607-501-185
TS/FILE NO. 1742 D
SHEET NO. ___ OF ___

Log mile - 22001315.89