F.H.WA. REGION NO	STATE	FED. AID PROJ. NO	SHEET NO.	TOTAL SHEETS
3	MD.		22	26

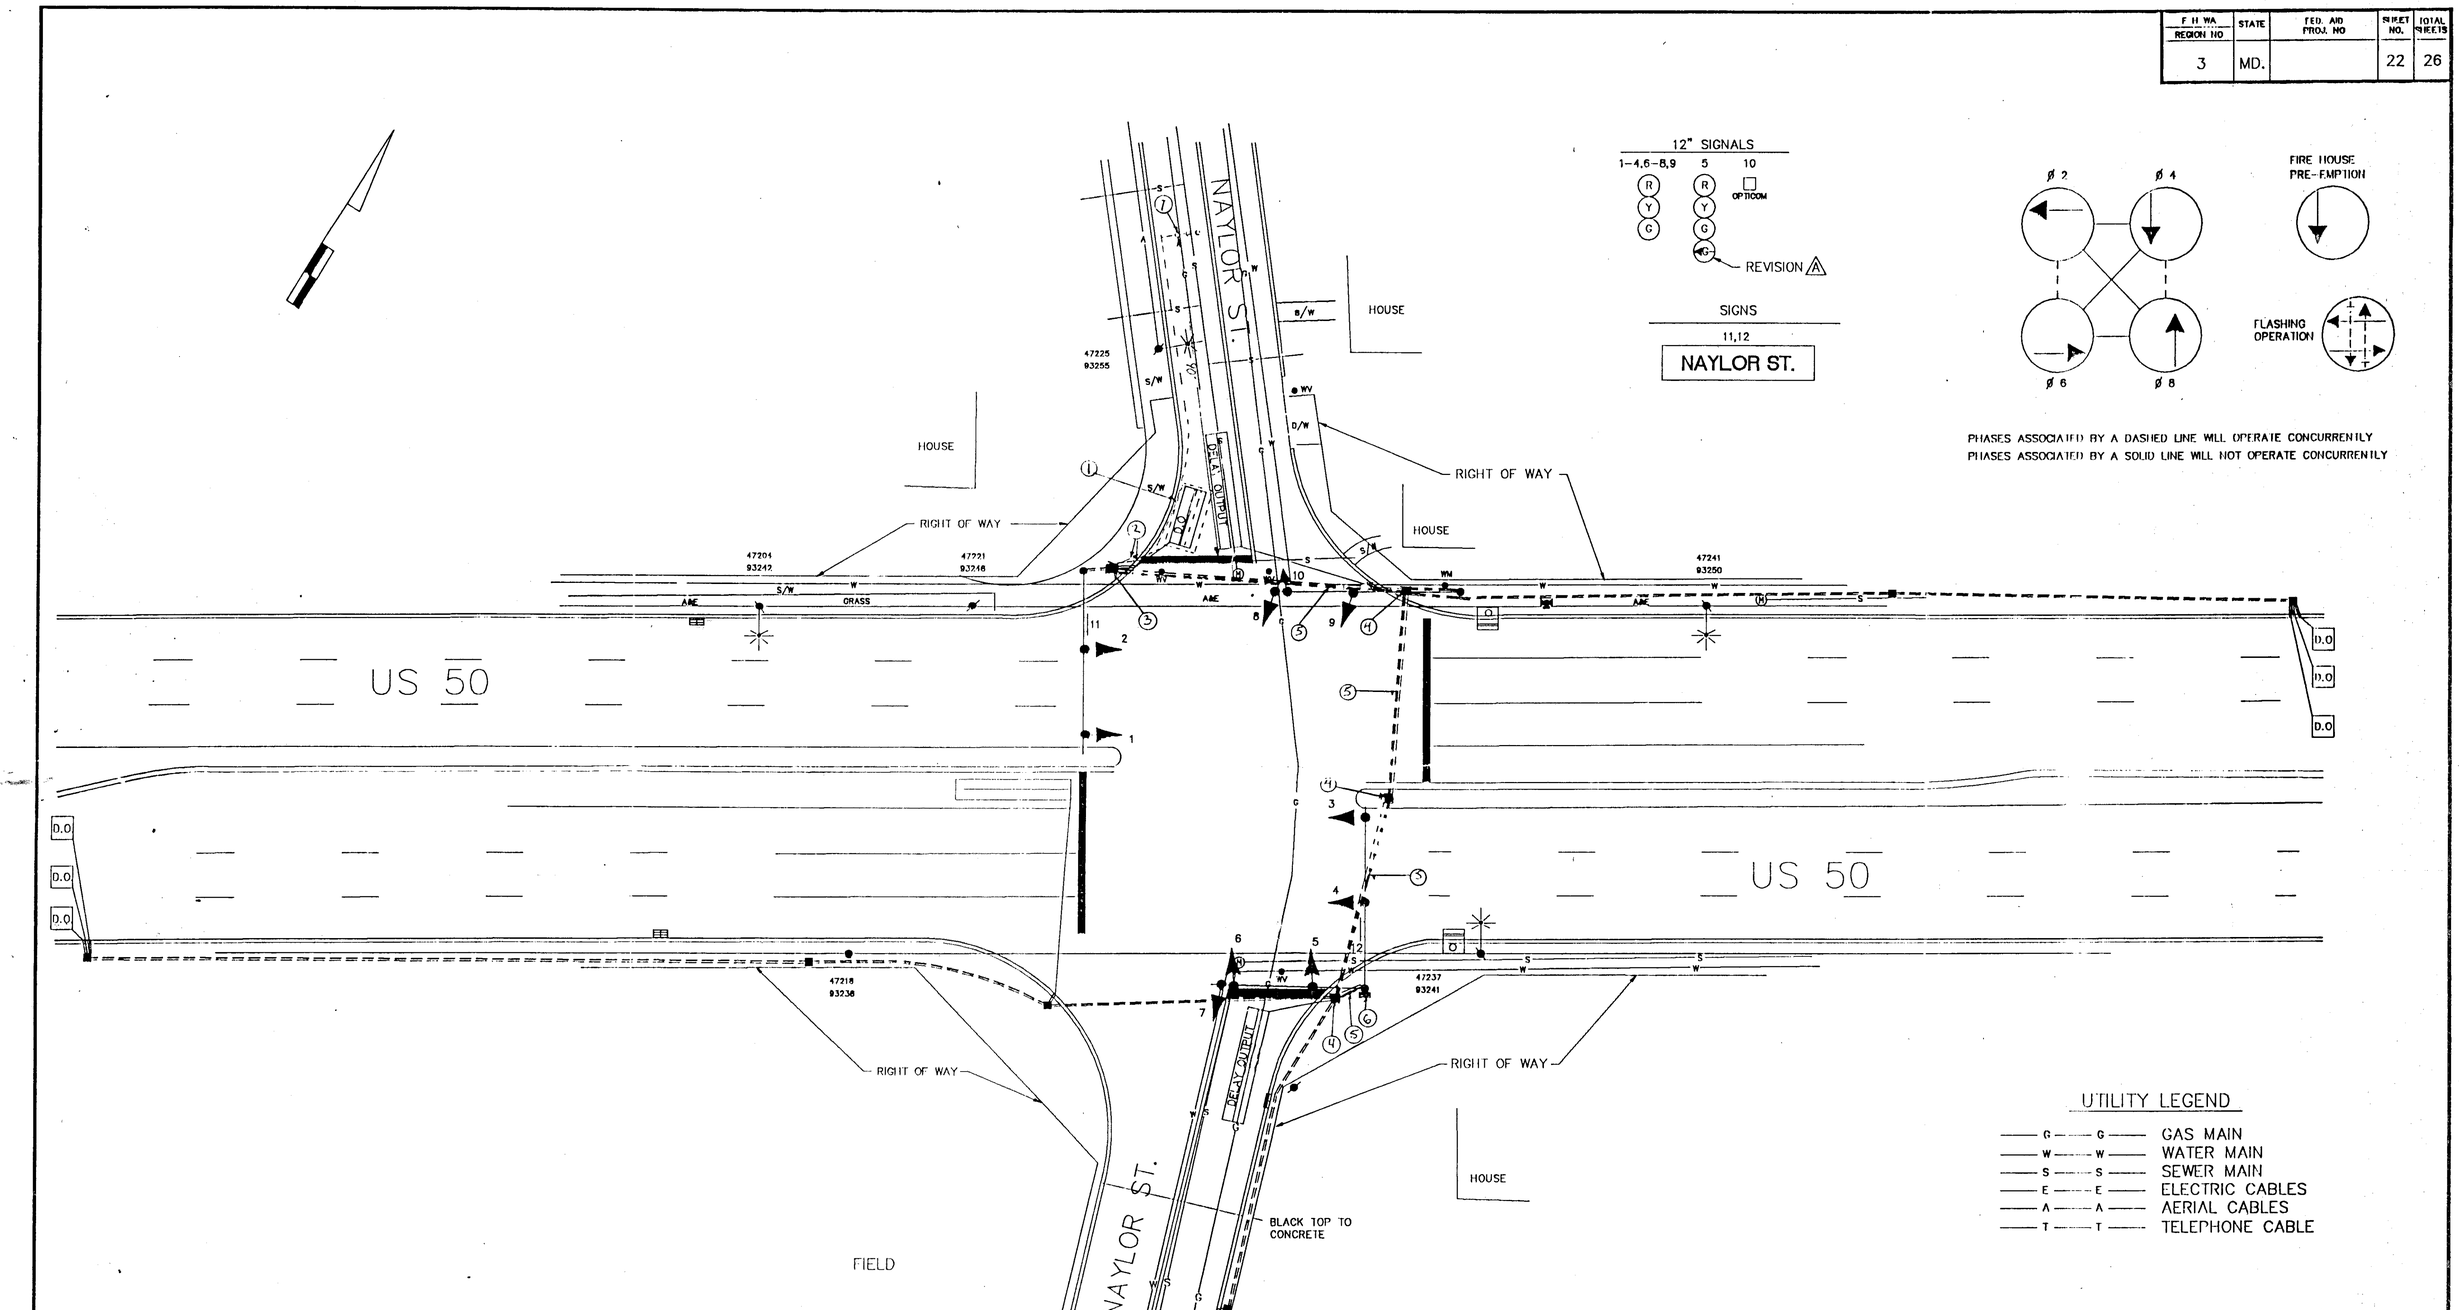

REVISIONS	APPROVALS
REPAIR FAILED LOOP DETECTOR. 3HA NO: AW 576-501-085 S.P.3 F.A.P. NO: AC-STPG-0005(010) DCS	CHIEF, SIGNAL DESIGN SECTION
A ASBUILT 9/91 INSTALL 4-SECTION SIGNAL HEAD FOR S/B NAYLOR RD.	ASST. DISTRICT ENGINEER, TRAFFIC
	CHIEF, TRAFFIC ENGINEERING DIVISION
	DEPUTY CHIEF ENGINEER, OFFICE OF TRAFFIC

THIS IS A REVISION TO SHA CONTRACT NO. WM-502-502-91 THE ORIGINAL IS ON FILE

MARYLAND DEPARTMENT OF TRANSPORTATION
STATE HIGHWAY ADMINISTRATION – OFFICE OF TRAFFIC
TRAFFIC ENGINEERING DIVISION

DRAWN BY: STEWART P. REYNA
DES. BY:
CHK. BY:

US 50 & NAYLOR ST.

22005016.51

COUNTY: WICOMICO

DATE: 7-8-91
SCALE: 1"=20'
F.A.P. NO.
S.H.A. NO.

TS/FILE NO. 2085 AB

SHEET NO. 1 OF 1

22005016.51