F H WA REGION NO	STATE	FED. AID PROJ. NO	SHEET NO.	TOTAL SHEETS
3	MD.		11	12

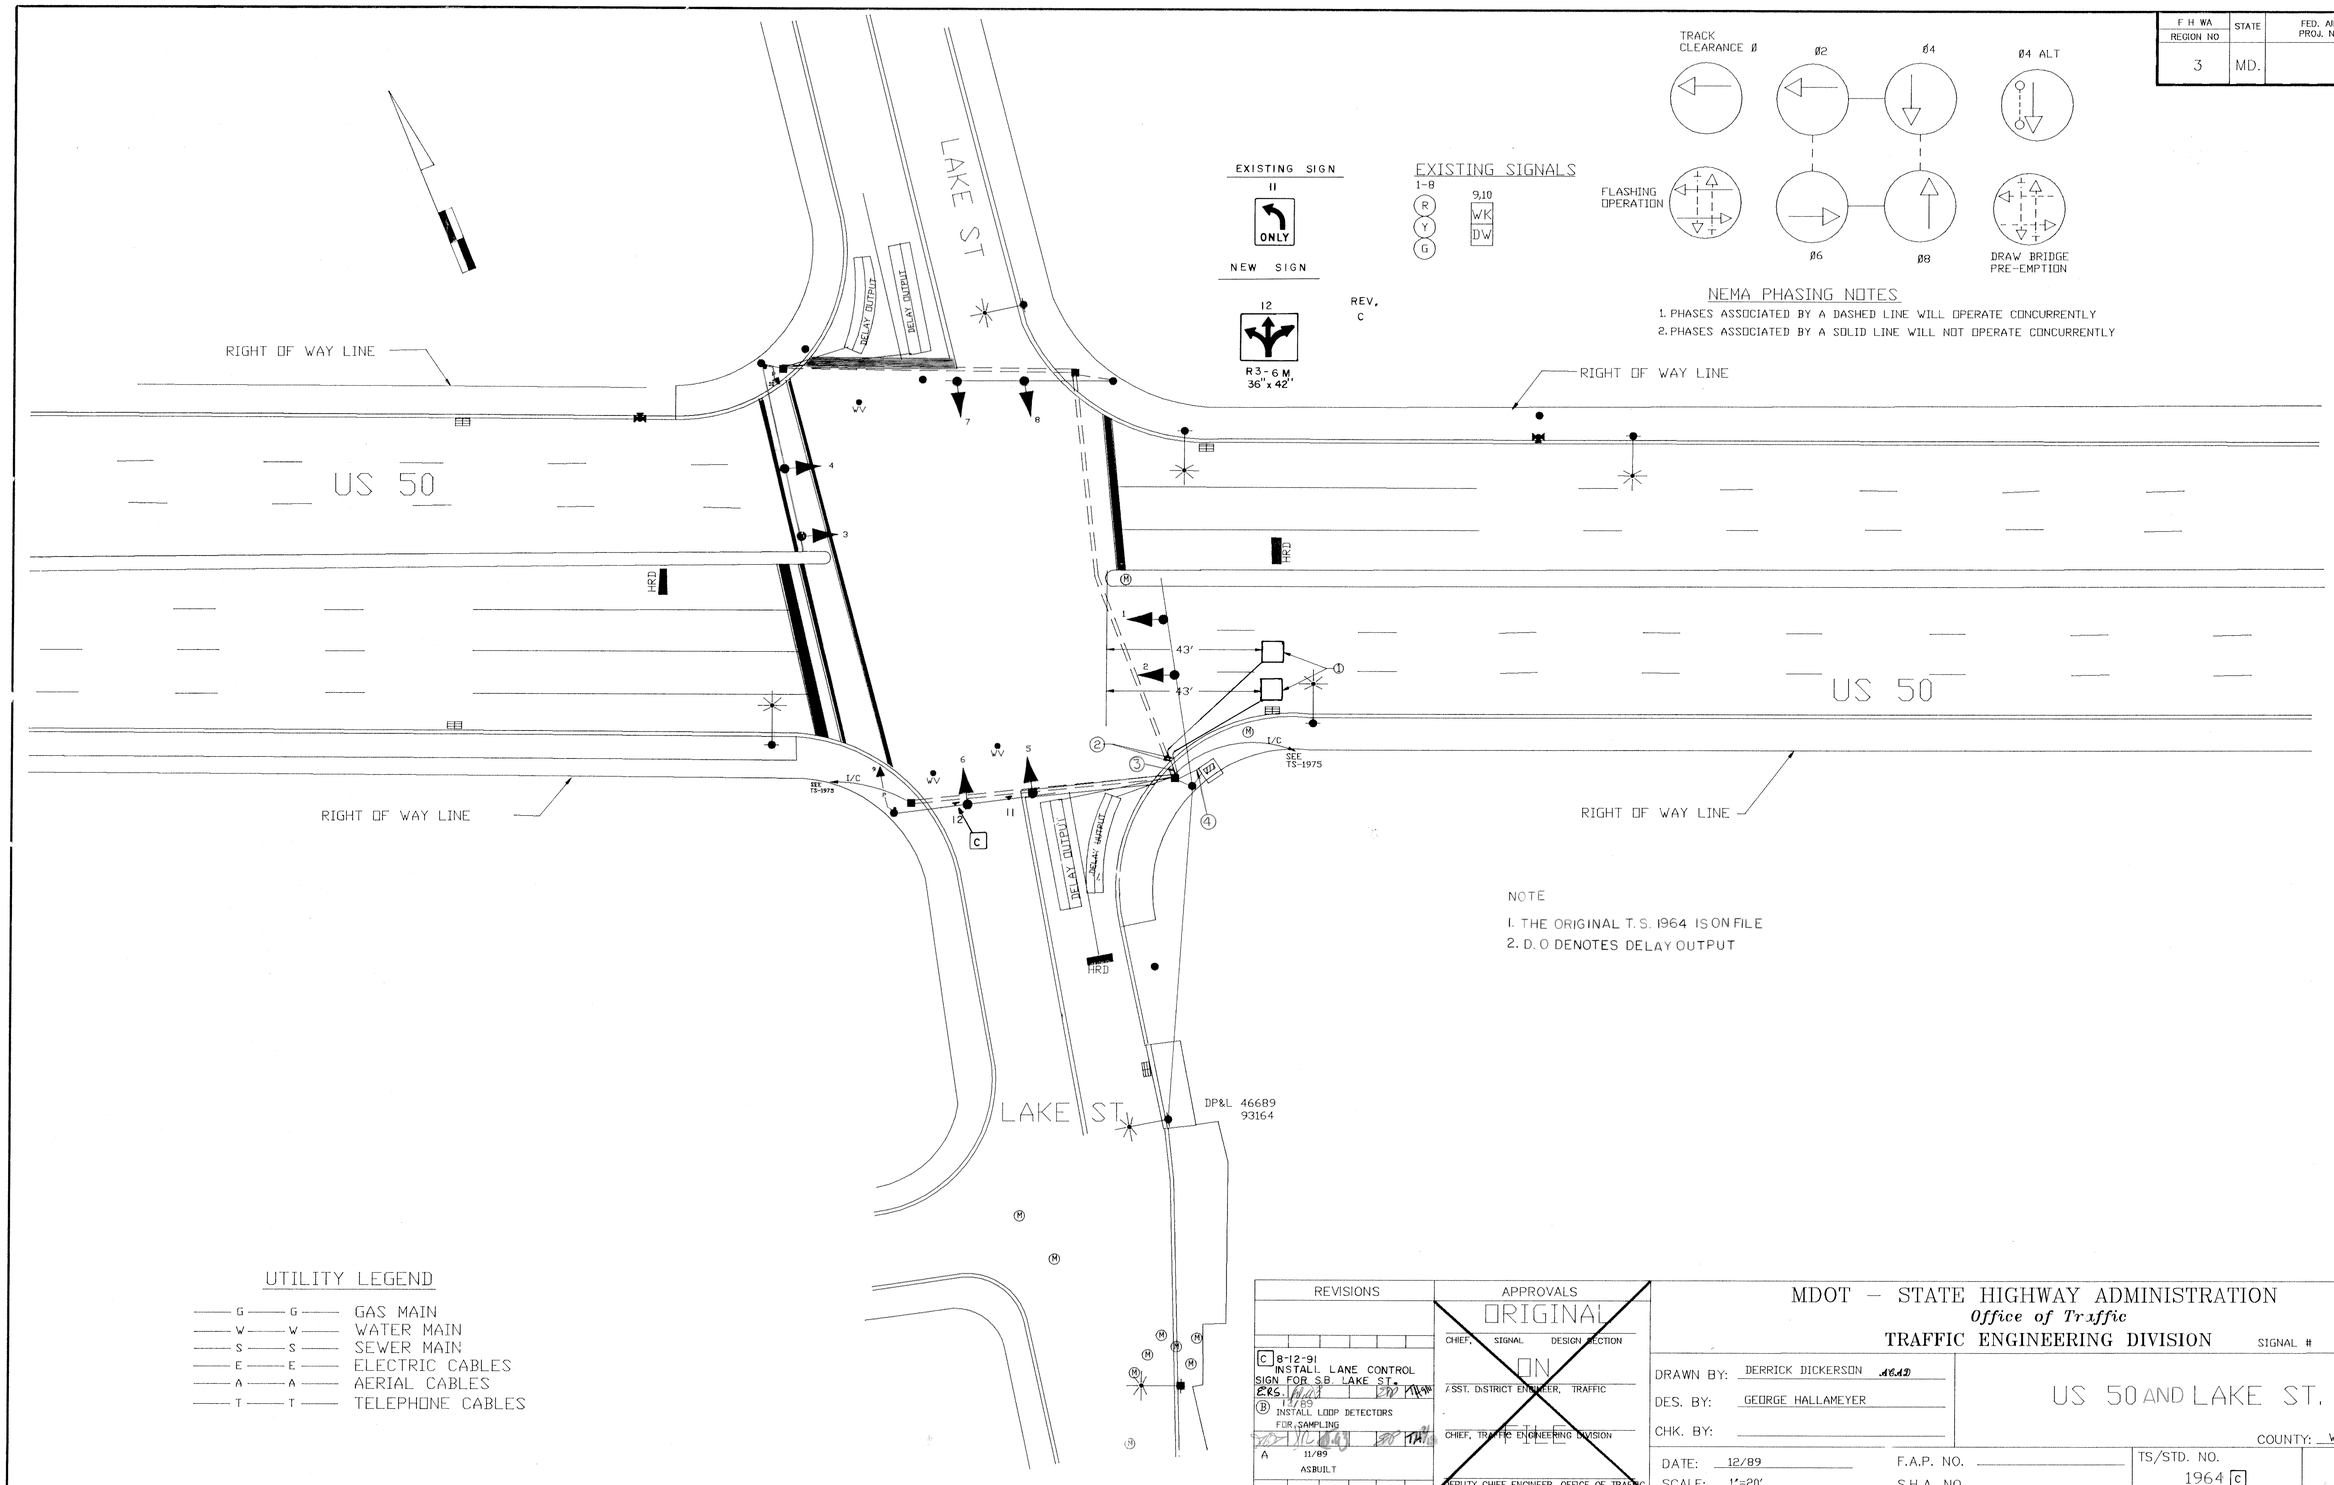

REVISIONS	APPROVALS
C 8-12-91 INSTALL LANE CONTROL SIGN FOR S.B. LAKE ST.	ORIGINAL
B 11/89 INSTALL LOOP DETECTORS FOR SAMPLING	CHIEF, SIGNAL DESIGN SECTION
A 11/89 ASBUILT	ON FILE
	ASST. DISTRICT ENGINEER, TRAFFIC
	CHIEF, TRAFFIC ENGINEERING DIVISION
	DEPUTY CHIEF ENGINEER, OFFICE OF TRAFFIC

MDOT – STATE HIGHWAY ADMINISTRATION
Office of Traffic
TRAFFIC ENGINEERING DIVISION

SIGNAL #

DRAWN BY: DERRICK DICKERSON
DES. BY: GEORGE HALLAMEYER
CHK. BY:

US 50 AND LAKE ST.

COUNTY: WICOMICO

DATE: 12/89
SCALE: 1"=20'
F.A.P. NO.
S.H.A. NO.

TS/STD. NO. 1964 C

SHEET NO. ___ OF ___

22005015.44