F.H.W.A. REGION NO.	STATE	FED. AID PROJ. NO.	SHEET NO.	TOTAL SHEETS
3	MD.		12	16

12" SIGNALS 1, X: R, Y, G

12" SIGNALS 4,5,7,8: R, Y, G

12" SIGNALS 9+10: R, Y, G — REV. (C)

8" SIGNALS 3,6: R, Y, G

PHASE 1

PHASE 2

FLASHING OPERATION

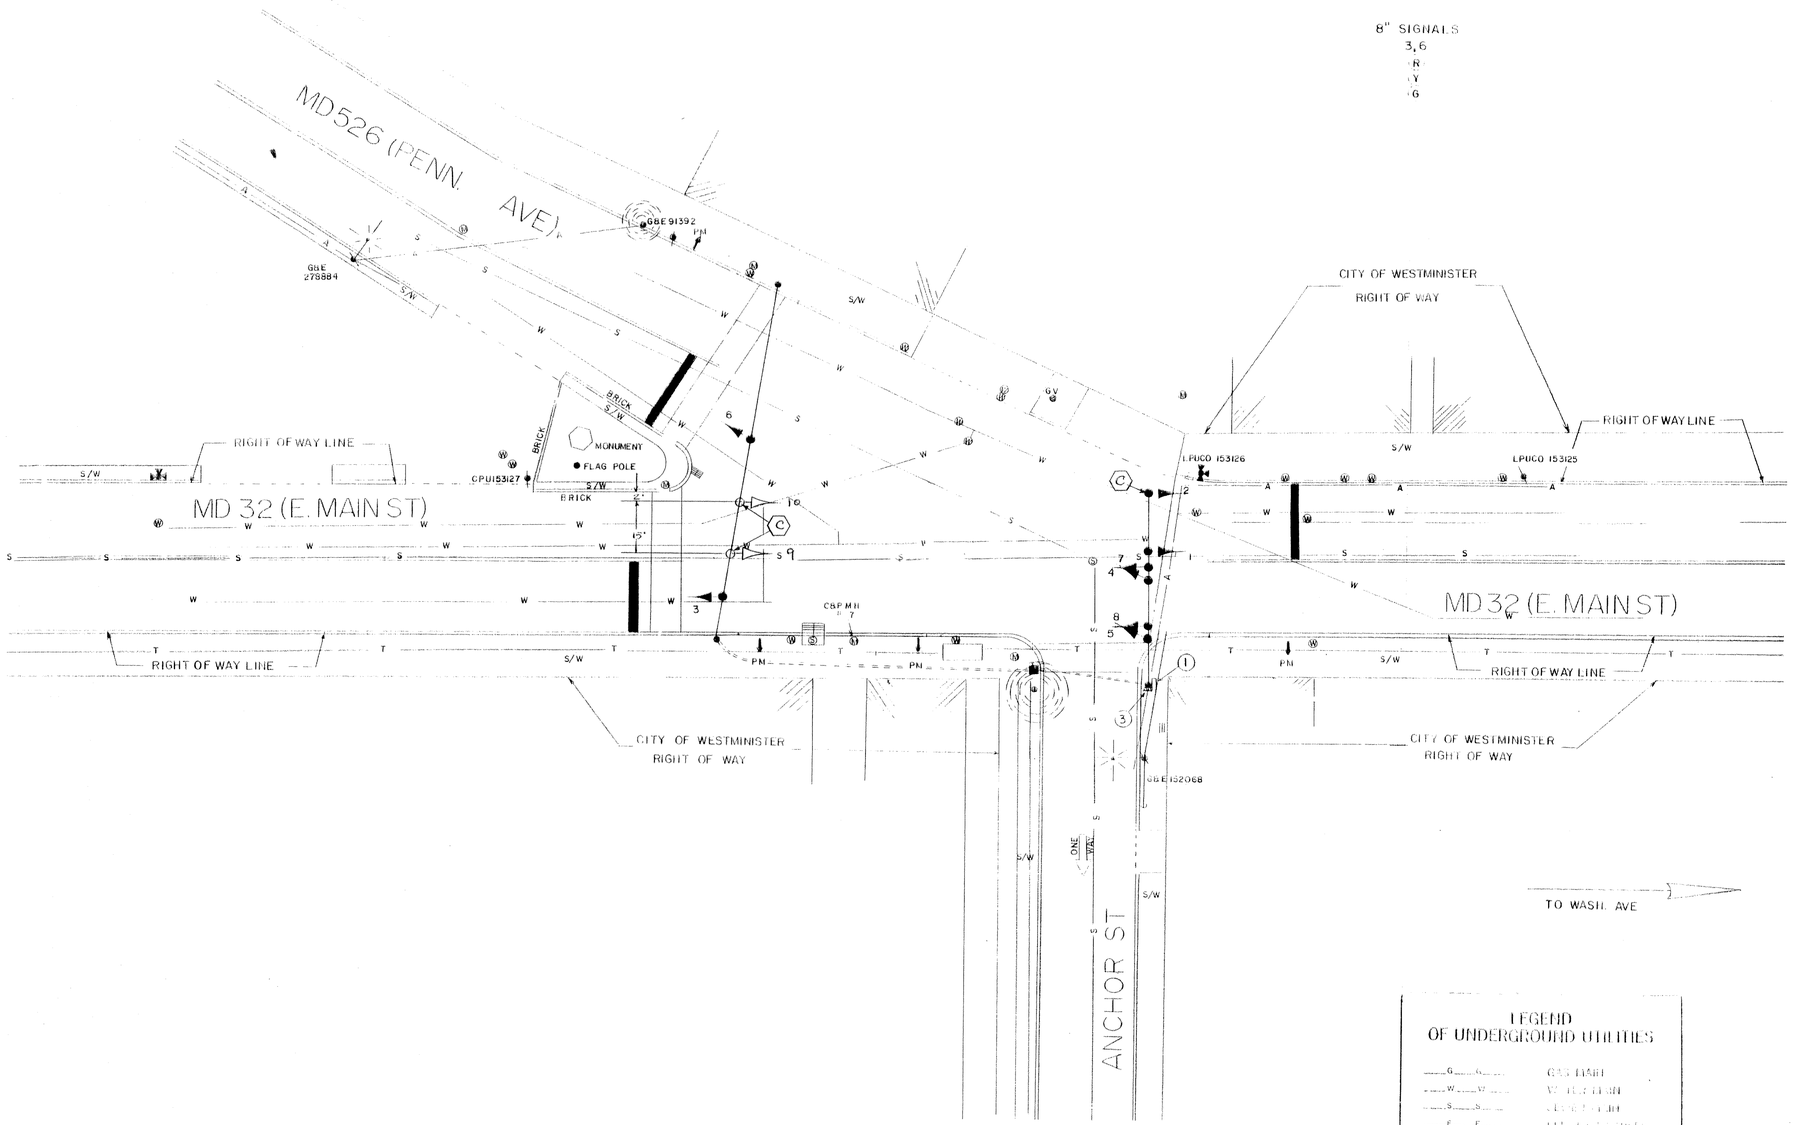

LEGEND OF UNDERGROUND UTILITIES

G G	GAS MAIN
W W	WATER MAIN
S S	SEWER MAIN
E E	ELECTRIC CABLES
T T	TELEPHONE CABLES
A A	AERIAL CABLES

APPROVAL: REGIONAL TRAFFIC ENGINEER

APPROVAL: CHIEF BUREAU OF TRAFFIC ENGINEERING

APPROVAL: ASS'T. CHIEF ENGINEER TRAFFIC

C	10-23-91 Install fan-side sig. hds. for WB Md 32, remove hd. no. 2
B	11-6-81 REPLACE EX. I/C WITH TIME BASE COORDINATION
A	AUG. 18, 1981 ASBUILT

REVISIONS

STATE OF MARYLAND
DEPARTMENT OF TRANSPORTATION
STATE HIGHWAY ADMINISTRATION

TRAFFIC DIVISION – BUREAU OF TRAFFIC ENGINEERING

MD32 (E. MAIN ST.) & MD526 (PENN. AVE)

SCALE 1" = 20' DATE 7 - 6 - 72 CONTRACT NO. AW-629-503-785

DRAWN BY: MATTHAI COUNTY: CARROLL

DESIGNED BY: [illegible] SIGNAL NO.: 06012

CHECKED BY:

DRAWING NO. TS- 611 ~~B~~ C

BRUNING 44.511 19927