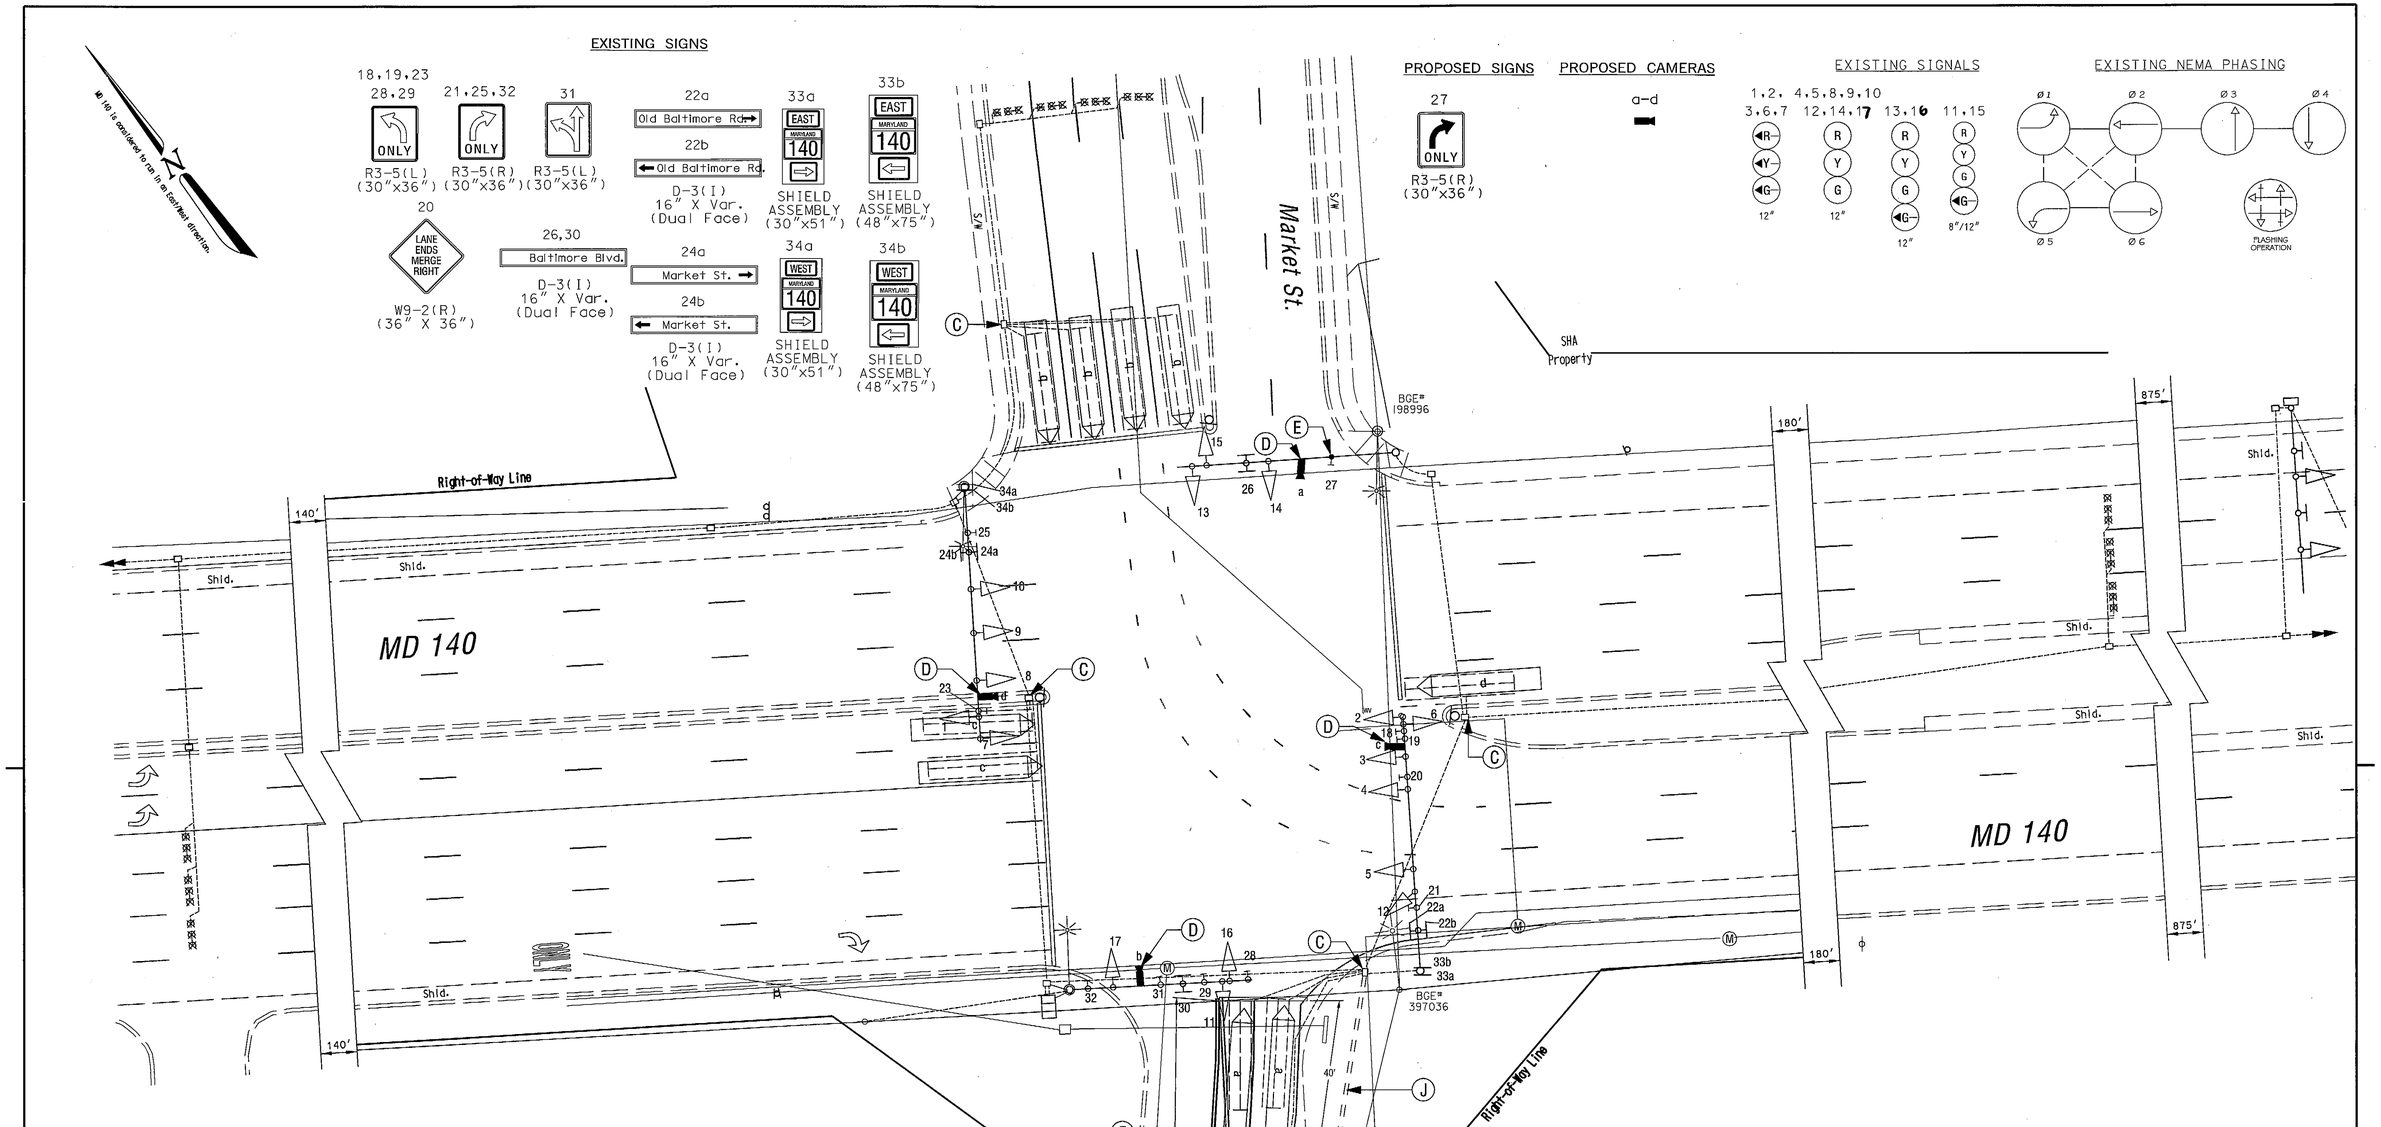

SPECIAL NOTE
PAVEMENT MARKING MODIFICATIONS TO BE INSTALLED AND REMOVED BY CARROLL COUNTY DEPARTMENT OF PUBLIC WORKS.

CONSTRUCTION NOTES.
A EXISTING PAVEMENT MARKINGS TO BE REMOVED BY OTHERS.
B. THERMOPLASTIC PAVEMENT MARKING ARROW TO BE INSTALLED BY OTHERS.
C. CUT AND ABANDON EXISTING LOOP DETECTORS.
D. INSTALL VIDEO DETECTION CAMERA.
E. INSTALL R3-5(R) SIGN.
F. 5" DOUBLE YELLOW PAVEMENT MARKING INSTALLED TO BE BY OTHERS.
G. 5" WHITE SOLID PAVEMENT MARKING INSTALLED TO BE BY OTHERS.
H. 5" WHITE PUPPY TRACK PAVEMENT MARKING TO BE INSTALLED BY OTHERS.
I. INSTALL 3" PVC CONDUIT - BORED.
J. INSTALL 3" PVC CONDUIT - TRENCH.
K. INSTALL HANDHOLE.
L. INSTALL NON-INVASIVE MICROPROBE (SET OF 3).

GEOMETRIC LEGEND
EXISTING GEOMETRICS
PROPOSED GEOMETRICS

UTILITY LEGEND
G — GAS MAIN
W — WATER MAIN
S — SEWER MAIN
E — ELECTRIC CABLES
D — STORM DRAIN
A — AERIAL CABLES
T — TELEPHONE CABLES

TOD NO:AX141-07
SHA NO:CL448A51/C51
MD 140@OLD BALTIMORE/MARKET ST

STATE OF MARYLAND
DEPARTMENT OF TRANSPORTATION
STATE HIGHWAY ADMINISTRATION
OFFICE OF TRAFFIC & SAFETY
TRAFFIC, ENGINEERING DESIGN DIVISION

MD 140 AT OLD BALTIMORE ROAD/MARKET STREET

SIGNAL MODIFICATION

APPROVALS	REVISIONS
ORIGINAL	
TEAM LEADER	
ASST. DIV. CHIEF	A. SHA #: AX14151185 INSTALL VIDEO DETECTION AND MODIFY OLD BALTIMORE INTO TWO LANES
DIVISION CHIEF	JS CW
ON FILE	10/13/01 "AS BUILT"
OFFICE DIRECTOR	SHA NO: BW996M82
	RMD

PLOTTED: Thursday, November 20, 2008 at 7:03:21 PM
FILE: J328GP10.dgn

SIGNALIZATION PLAN SHEET

SCALE 1" = 20' ADVERTISED DATE 11/08/00 CONTRACT NO. BW996M82

DESIGNED BY
DRAWN BY J.STORCK
CHECKED BY
F.A.P. NO.

COUNTY CARROLL
LOGMILE 06014007.59
TIMS NO. J328
TOD NO.

TS NO. 4050A | DRAWING SG-1 OF 1 | SHEET NO. 1 OF 2

BY: jsmith21