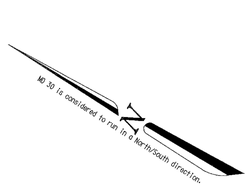

EXISTING SIGN

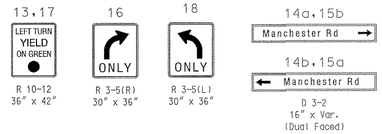

EXISTING SIGNALS

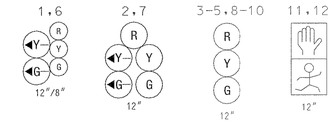

EXISTING NEMA PHASING

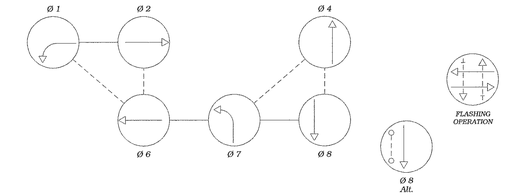

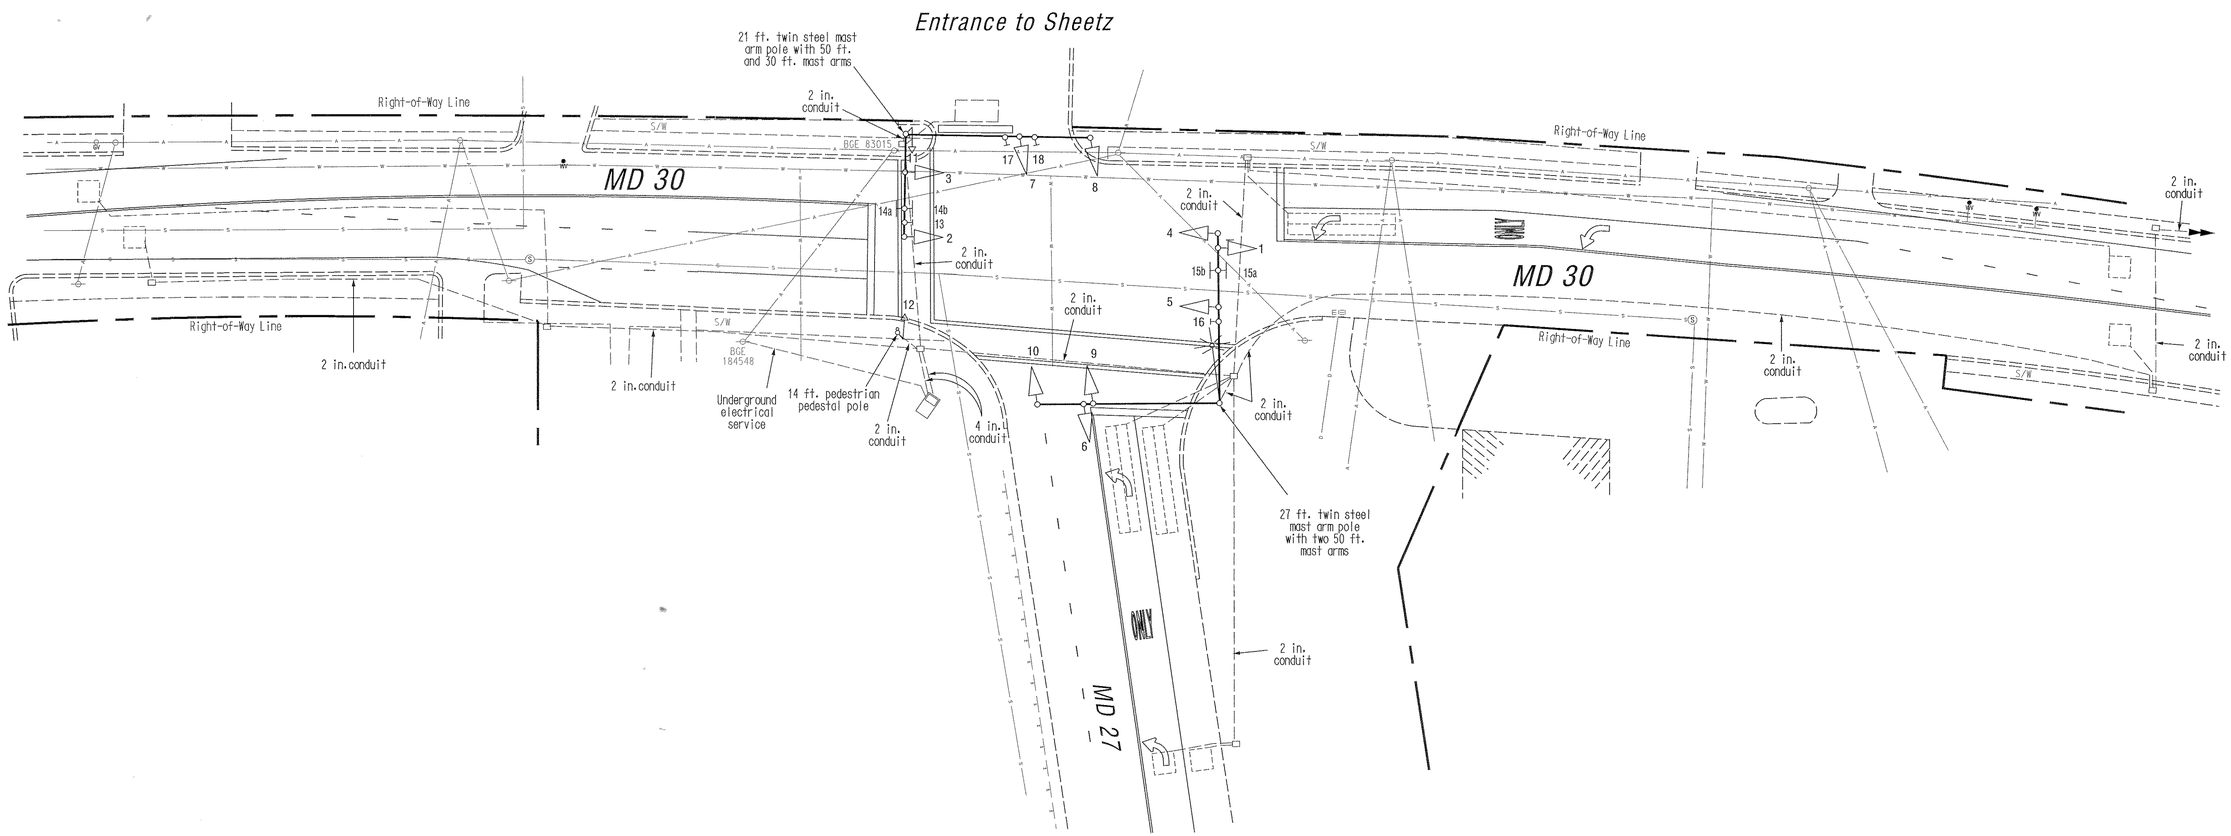

GEOMETRIC LEGEND

EXISTING GEOMETRICS
PROPOSED GEOMETRICS

UTILITY LEGEND

G	GAS MAIN
W	WATER MAIN
S	SEWER MAIN
E	ELECTRIC CABLES
D	STORM DRAIN
A	AERIAL CABLES
T	TELEPHONE CABLES

"ASBUILT"

The Traffic Group

The Traffic Group, Inc.
410-931-6600
Fax 410-931-6601

REVISIONS

September 25, 2000
AS-BUILT
S.H.A. No.:BW996M82
FJH

APPROVALS

TEAM LEADER, TRAFFIC ENGINEERING DESIGN DIVISION
ASST. CHIEF TRAFFIC ENGINEERING DESIGN DIVISION
CHIEF, TRAFFIC ENGINEERING DESIGN DIVISION
DIRECTOR, TRAFFIC & SAFETY

ORIGINAL ON FILE

MARYLAND DOT - STATE HIGHWAY ADMINISTRATION
Office of Traffic & Safety
TRAFFIC ENGINEERING DESIGN DIVISION
(Traffic Signal Plan)

MD 30 at MD 27/Entrance to Sheetz

DRAWN BY:	JHG	F.A.P. NO.	N/A	TS NO. 2393C	SHEET NO.
CHECKED BY:	DAD	S.H.A. NO.	OT-7-88		
SCALE:	1" = 20'	COUNTY:	Carroll	T.I.M.S. NO. D720	1 OF 1
DATE:	October 27, 1987	LOG MILE:	06003006.68		

f:\1998\980710\des\asbuilt.dgn 02 OCT 2000