NOTE: MD 189 IS ASSUMED TO RUN IN A NORTH-SOUTH DIRECTION.

EXISTING SIGNALS

1,2
Y
12"

EXISTING SIGNS

3
W1-1R
48"x48"
25 M.P.H.
W13-1
24"x24"

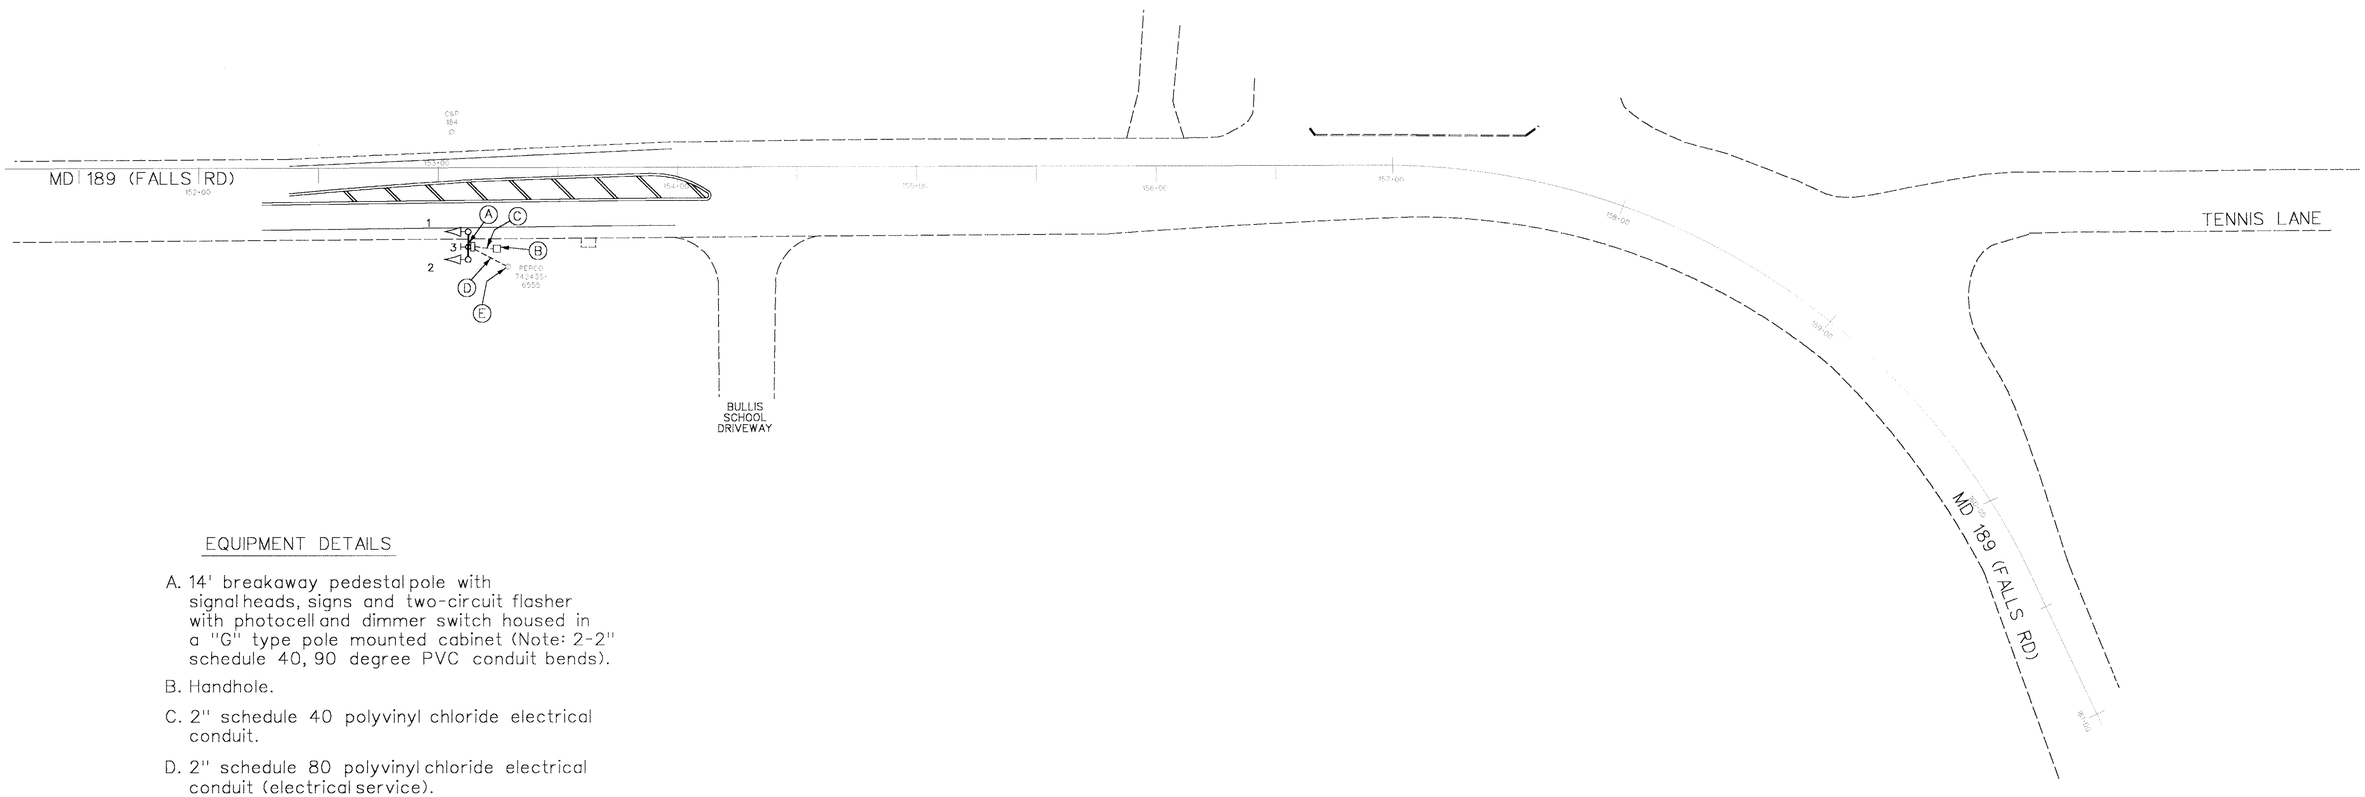

EQUIPMENT DETAILS

A. 14' breakaway pedestal pole with signal heads, signs and two-circuit flasher with photocell and dimmer switch housed in a "G" type pole mounted cabinet (Note: 2-2" schedule 40, 90 degree PVC conduit bends).

B. Handhole.

C. 2" schedule 40 polyvinyl chloride electrical conduit.

D. 2" schedule 80 polyvinyl chloride electrical conduit (electrical service).

E. Meter socket and disconect switch on utility pole.

REVISION "A" ASBUILT

STREET TRAFFIC STUDIES, LTD.

Gateway International
1302 Concourse Drive, Suite 104
Linthicum, Maryland 21090
Ph (410) 859-3553
Fax (410) 859-3579

3484H.DGN

REVISIONS

A 2-99 ASBUILT
SHA NO. M05711176
RRZ

APPROVALS

ASST. CHIEF TEDD SECTION

ASST. DISTRICT ENGINEER, TRAFFIC

CHIEF, TRAFFIC ENGINEERING DESIGN DIVISION

DIRECTOR, TRAFFIC & SAFETY

MARYLAND DOT - STATE HIGHWAY ADMINISTRATION
Office of Traffic & Safety
TRAFFIC ENGINEERING DESIGN DIVISION
HAZARD IDENTIFICATION BEACON
MD 189 SOUTH OF TENNIS LANE

DRAWN BY: S. BLOSS
CHECK BY: T. HANNAN
DATE: 2-8-97
SCALE: 1"= 30'

COUNTY: MONTGOMERY
LOG MILE: 15018902.90
F.A.P. NO.
S.H.A. NO.

TS NO. 3677A
T.I.M.S. NO.

SHEET NO. ___ OF ___

F# 36