F. H. WA. REGION NO.	STATE	FED. AID PROJ. NO.	SHEET NO.	TOTAL SHEETS
3	MD.	SEE TITLE SHEET	132	169

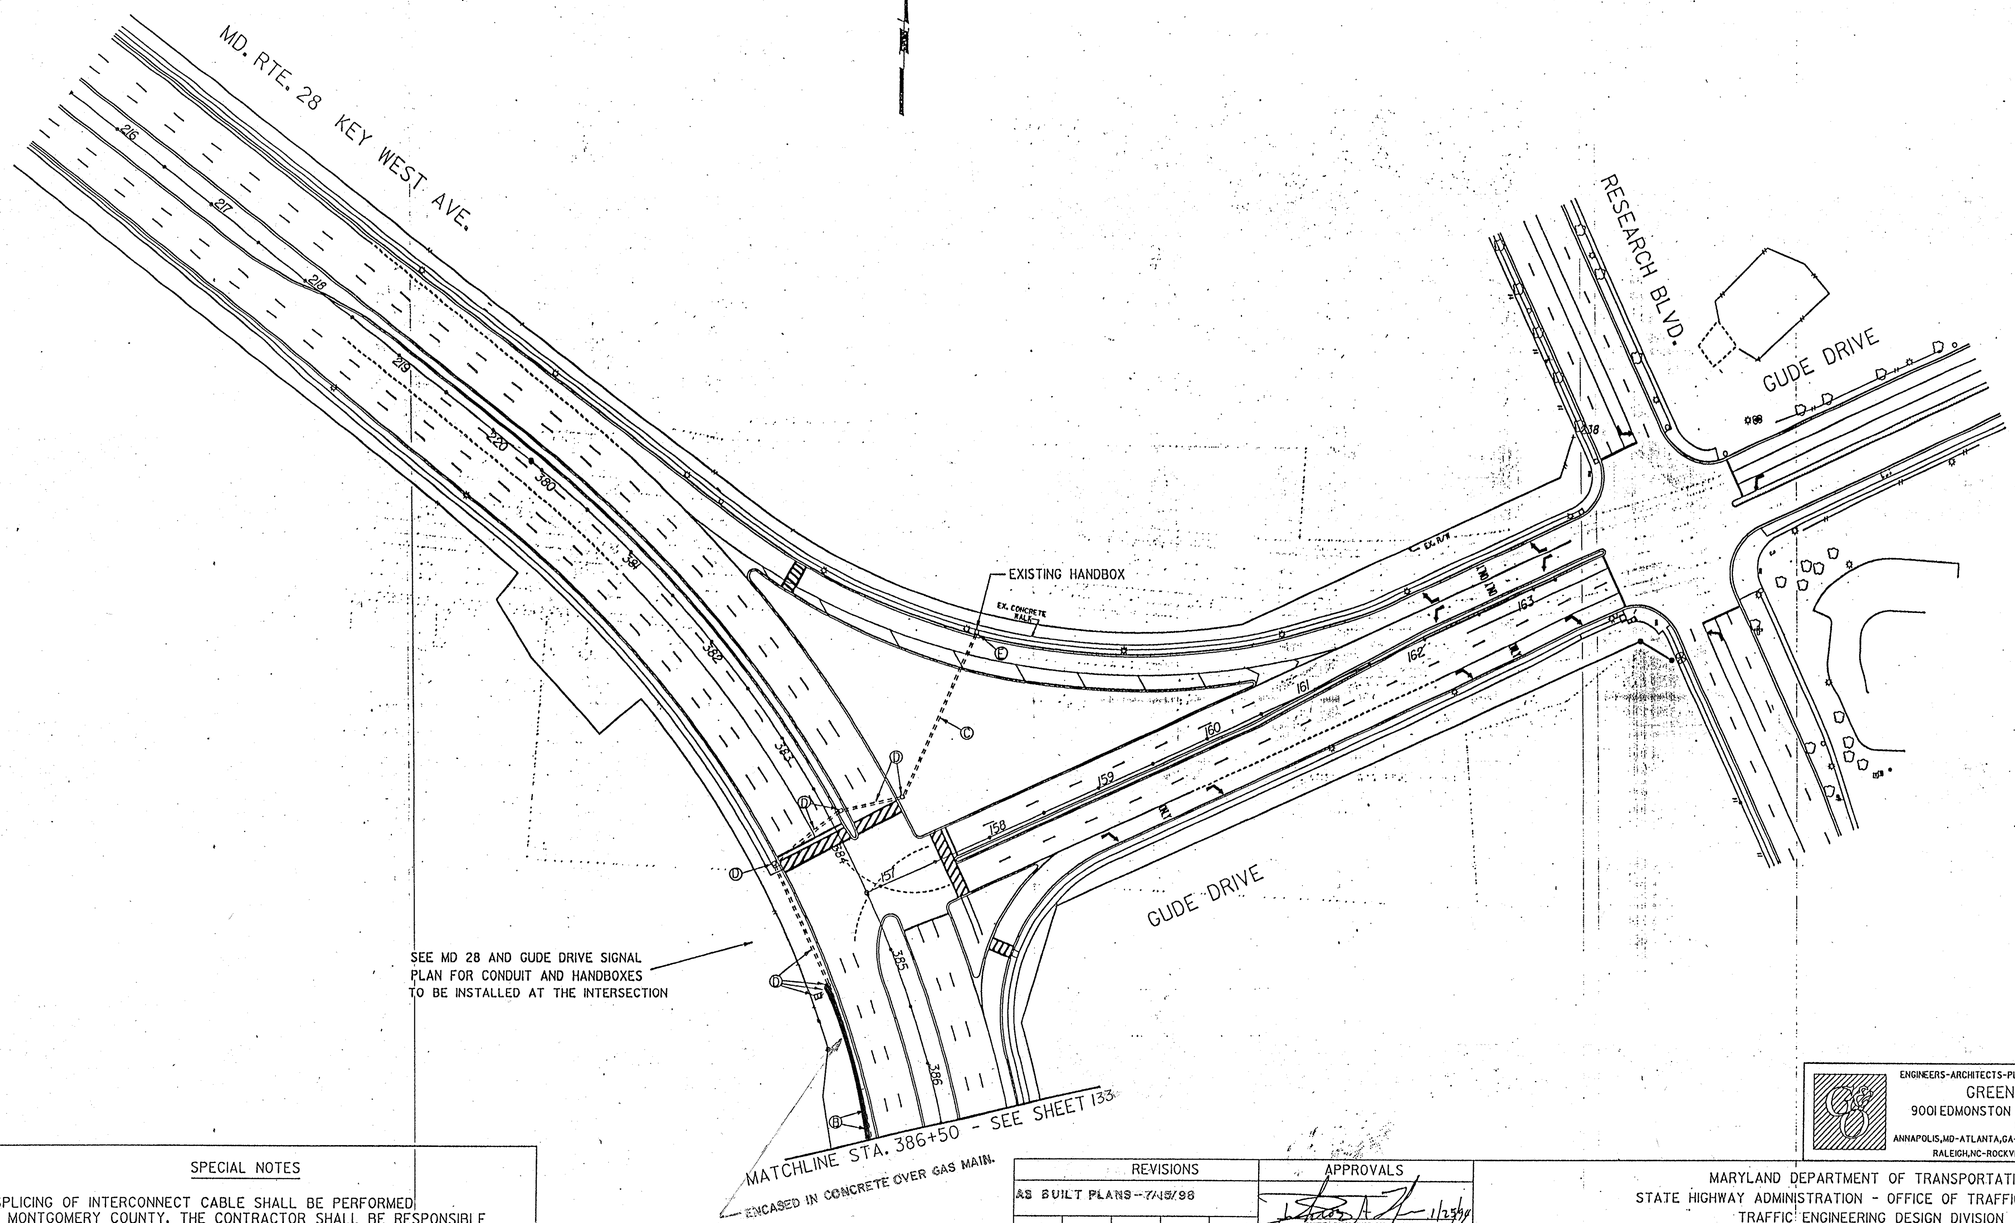

STATE OF MARYLAND
JOHN CHARLES KLIMOVICH
No. 14228
REGISTERED PROFESSIONAL ENGINEER

ENGINEERS-ARCHITECTS-PLANNERS-SCIENTISTS-SURVEYORS-PHOTOGRAMMETRISTS
GREENHORNE & O'MARA, INC.
9001 EDMONSTON ROAD, GREENBELT, MARYLAND 20770
(301) 982-2800
ANNAPOLIS,MD-ATLANTA,GA-CULPEPER,VA-DENVER,CO-FAIRFAX,VA-HARRISBURG,PA
RALEIGH,NC-ROCKVILLE,MD-TAMPA,FLA-WEST PALM BEACH,FLA

LEGEND

PROPOSED GEOMETRY — OR —
EXISTING GEOMETRY — OR —

LEGEND OF UNDERGROUND AND OVERHEAD UTILITIES

AERIAL CABLE	—A——A—
ELECTRIC	—E——E—
TELEPHONE	—T——T—
GAS	—G——G—
SEWER	—S——S—
WATER	—W——W—
CABLE TV	—TV——TV—
STORM SEWER	

SPECIAL NOTES

1. SPLICING OF INTERCONNECT CABLE SHALL BE PERFORMED BY MONTGOMERY COUNTY. THE CONTRACTOR SHALL BE RESPONSIBLE FOR ROUTING OF INTERCONNECT CABLE AND SHALL PROPERLY LABEL EACH CABLE IN THE BASE OF EACH CABINET. CONTACT MR. BRUCE MANGUM OF MCDOT AT 301-217-2190 SEVENTY-TWO HOURS IN ADVANCE OF THE INTENDED WORK.

2. INTERCONNECT TO EXISTING SIGNALS SHALL BE MAINTAINED AT ALL TIMES. THE CONTRACTOR MAY BE REQUIRED TO REROUTE EXISTING CABLE OR INSTALL NEW TEMPORARY CABLE TO MAINTAIN INTERCONNECT DURING CONSTRUCTION.

REVISIONS

AS BUILT PLANS - 7/15/98

APPROVALS

1/25/94
CHIEF, SIGN DESIGN SECTION

ASST. DISTRICT ENGINEER, TRAFFIC

1/25/94
CHIEF, TRAFFIC ENGINEERING DESIGN DIVISION

DIRECTOR, OFFICE OF TRAFFIC AND SAFETY

MARYLAND DEPARTMENT OF TRANSPORTATION
STATE HIGHWAY ADMINISTRATION - OFFICE OF TRAFFIC & SAFETY
TRAFFIC ENGINEERING DESIGN DIVISION

LOG #

DRAWN BY S. CHERNACK OF G&O
DES. BY M. MILLER OF G&O
CHK. BY

MD 28 FROM GUDE DRIVE TO HURLEY AVENUE
TRAFFIC SIGNAL INTERCONNECT PLAN

COUNTY: MONTGOMERY

DATE: 10-25-93
SCALE: 1" = 60'
F.A.P. NO. SEE TITLE SHEET
S.H.A. NO. M 528-503-371
TS/FILE NO.
SHEET NO. 1 OF 4