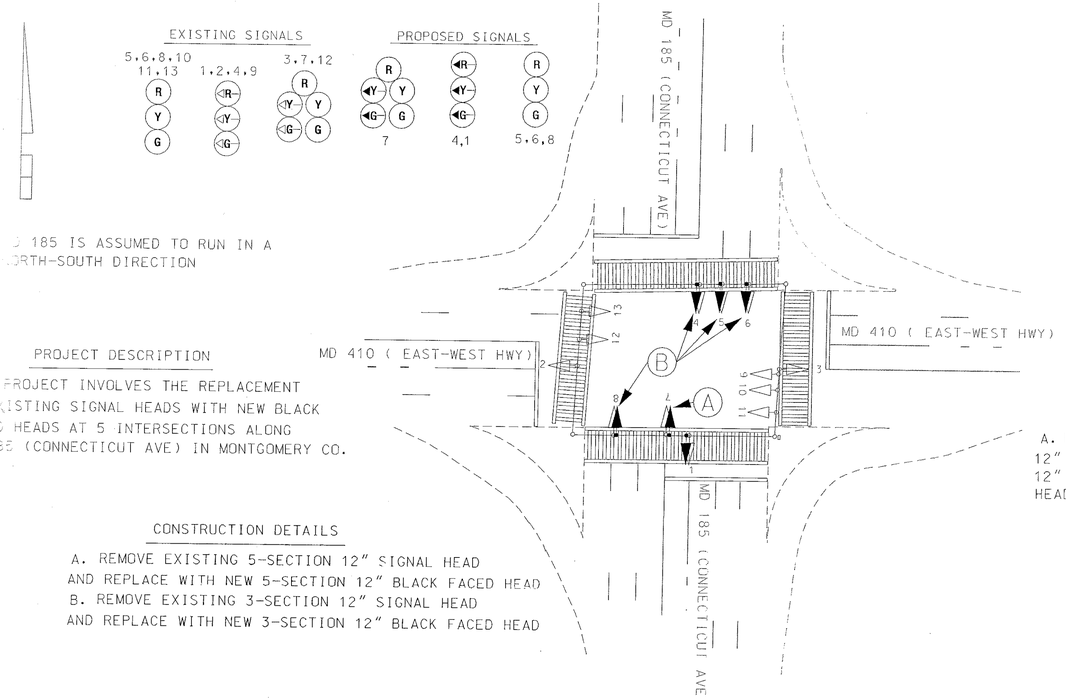

MD 185 IS ASSUMED TO RUN IN A NORTH-SOUTH DIRECTION

PROJECT DESCRIPTION

THIS PROJECT INVOLVES THE REPLACEMENT OF EXISTING SIGNAL HEADS WITH NEW BLACK FACED HEADS AT 5 INTERSECTIONS ALONG MD 185 (CONNECTICUT AVE) IN MONTGOMERY CO.

CONSTRUCTION DETAILS

A. REMOVE EXISTING 5-SECTION 12" SIGNAL HEAD AND REPLACE WITH NEW 5-SECTION 12" BLACK FACED HEAD
B. REMOVE EXISTING 3-SECTION 12" SIGNAL HEAD AND REPLACE WITH NEW 3-SECTION 12" BLACK FACED HEAD

MD 185 @ MD 410 (EAST-WEST HWY)

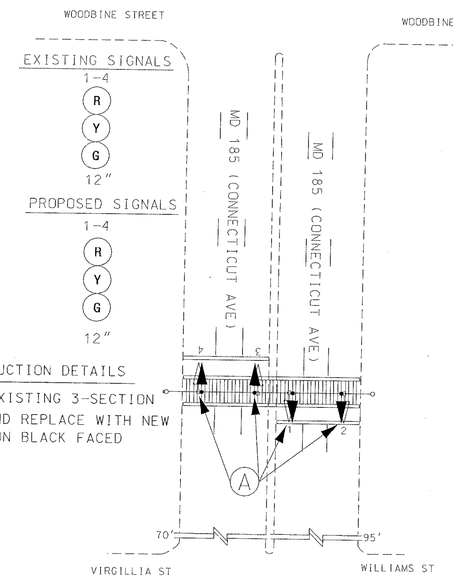

CONSTRUCTION DETAILS

A. REMOVE EXISTING 3-SECTION 12" HEADS AND REPLACE WITH NEW 12" 3-SECTION BLACK FACED HEADS

MD 185 @ 150' S OF WOODBINE

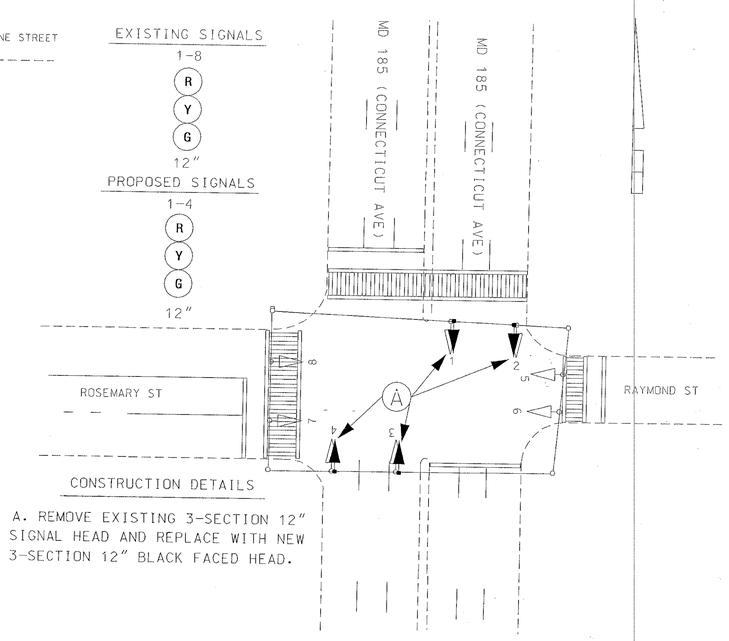

CONSTRUCTION DETAILS

A. REMOVE EXISTING 3-SECTION 12" SIGNAL HEAD AND REPLACE WITH NEW 3-SECTION 12" BLACK FACED HEAD.

MD 185 @ ROSEMARY/RAYMOND STS

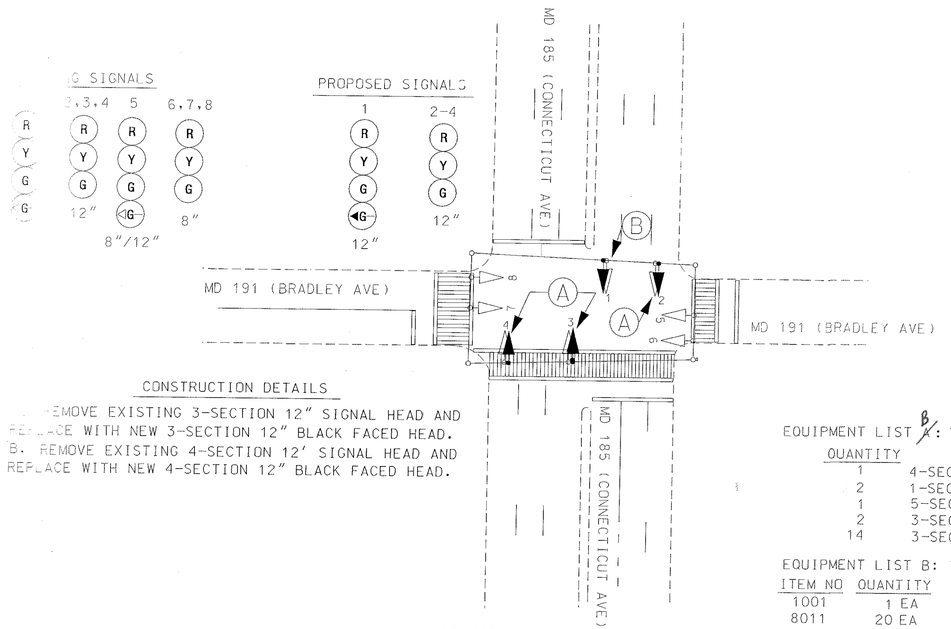

CONSTRUCTION DETAILS

A. REMOVE EXISTING 3-SECTION 12" SIGNAL HEAD AND REPLACE WITH NEW 3-SECTION 12" BLACK FACED HEAD.
B. REMOVE EXISTING 4-SECTION 12' SIGNAL HEAD AND REPLACE WITH NEW 4-SECTION 12" BLACK FACED HEAD.

MD 185 @ MD 191 (BRADLEY LANE)

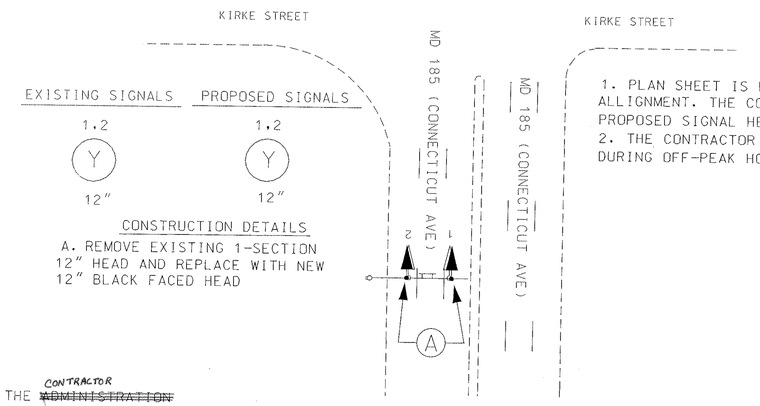

CONSTRUCTION DETAILS

A. REMOVE EXISTING 1-SECTION 12" HEAD AND REPLACE WITH NEW 12" BLACK FACED HEAD

MD 185 @ S OF KIRKE STREET (CIRCLE HIB)

GENERAL NOTES

1. PLAN SHEET IS NOT DRAWN TO SCALE AND MAY NOT REPRESENT ACTUAL ROADWAY ALLIGNMENT. THE CONTRACTOR SHALL BE RESPSONSIBLE FOR THE ALLIGNMENT OF ALL PROPOSED SIGNAL HEADS TO MAXIMIZE THEIR VISIBILITY.
2. THE CONTRACTOR SHALL SCHEDULE THEIR WORK SO THAT SIGNAL OUTAGES OCCUR DURING OFF-PEAK HOURS AS DIRECTED BY THE ENGINEER.

EQUIPMENT LIST ~~A~~ B: TO BE SUPPLIED BY THE ~~ADMINISTRATION~~ CONTRACTOR

QUANTITY	DESCRIPTION
1	4-SECTION 12" SIGNAL HEAD (SPAN WIRE)
2	1-SECTION (YELLOW) 12" SIGNAL HEAD (MAST ARM)
1	5-SECTION 12" SIGNAL HEAD (SPAN WIRE)
2	3-SECTION 12" R,Y,G ARROW SIGNAL HEAD (SPAN WIRE)
14	3-SECTION 12" R,Y,G BALL SIGNAL (SPAN WIRE)

EQUIPMENT LIST B: TO BE FURNISHED AND/OR INSTALLED BY CONTRACTOR

ITEM NO	QUANTITY	ITEM DESCRIPTION
1001	1 EA	MAINTENANCE OF TRAFFIC
8011	20 EA	INSTALL SIGNAL HEAD (ANY TYPE)
8060	1 EA	REMOVE AND DISPOSE OF EXISTING EQUIPMENT
8084	59 EA	F+I 12" VEHICULAR TRAFFIC SIGNAL HEAD SECTION. (SEE ABOVE BREAKDOWN)

REVISIONS	APPROVALS
	TEAM LEADER, TRAFFIC ENGINEERING DESIGN DIVISION 7-12-00
	ASST. CHIEF TRAFFIC ENGINEERING DESIGN DIVISION 7/12/00
	CHIEF, TRAFFIC ENGINEERING DESIGN DIVISION 7/12/00
	DIRECTOR, TRAFFIC & SAFETY 7/12/00

MARYLAND DOT - STATE HIGHWAY ADMINISTRATION
Office of Traffic & Safety
TRAFFIC ENGINEERING DESIGN DIVISION

MD 185 @ VARIOUS LOCATIONS
[FROM DC LINE TO MD410].

DRAWN BY: C. STRAIN	F.A.P. NO.	TS NO.	SHEET NO.
CHECKED BY: M. RUCKER	S.H.A. NO. MD 857-157/065	VARIOUS	1 OF 1
SCALE: NOT TO SCALE	COUNTY: MONTGOMERY	T.I.M.S. NO.	
DATE: 6/27/00	LOG MILE: XXX	D997	