

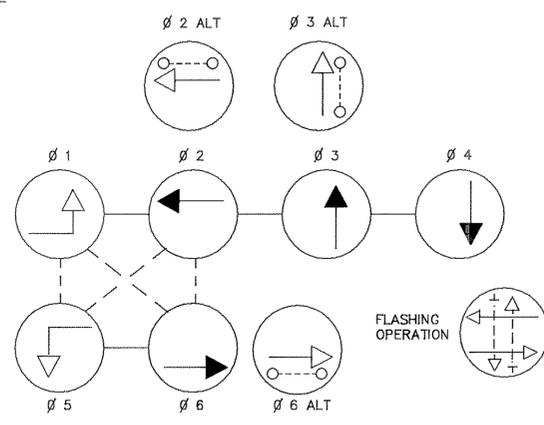


| | | | | |
|---------------------|-------|----------------------|--------------|-----------------|
| F H WA REGION NO | STATE | FED. AID PROJ. NO | SHEET NO. | TOTAL SHEETS |
| 3 | MD. | | | |

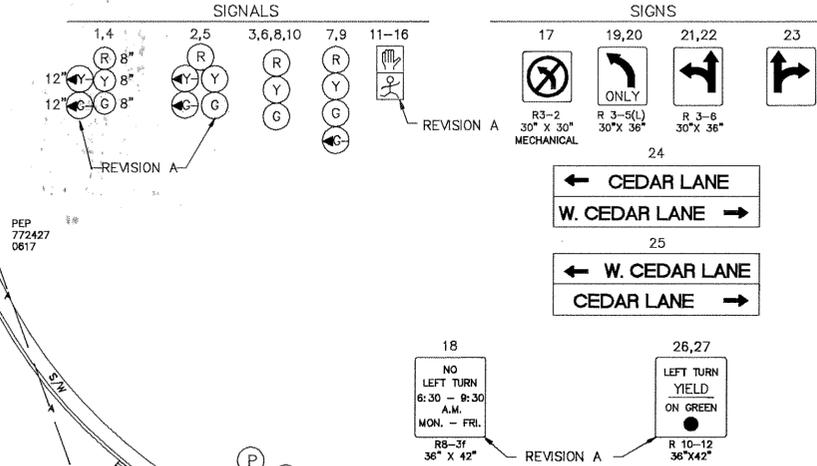

PHASES ASSOCIATED BY A DASHED LINE WILL OPERATE CONCURRENTLY
PHASES ASSOCIATED BY A SOLID LINE WILL NOT OPERATE CONCURRENTLY

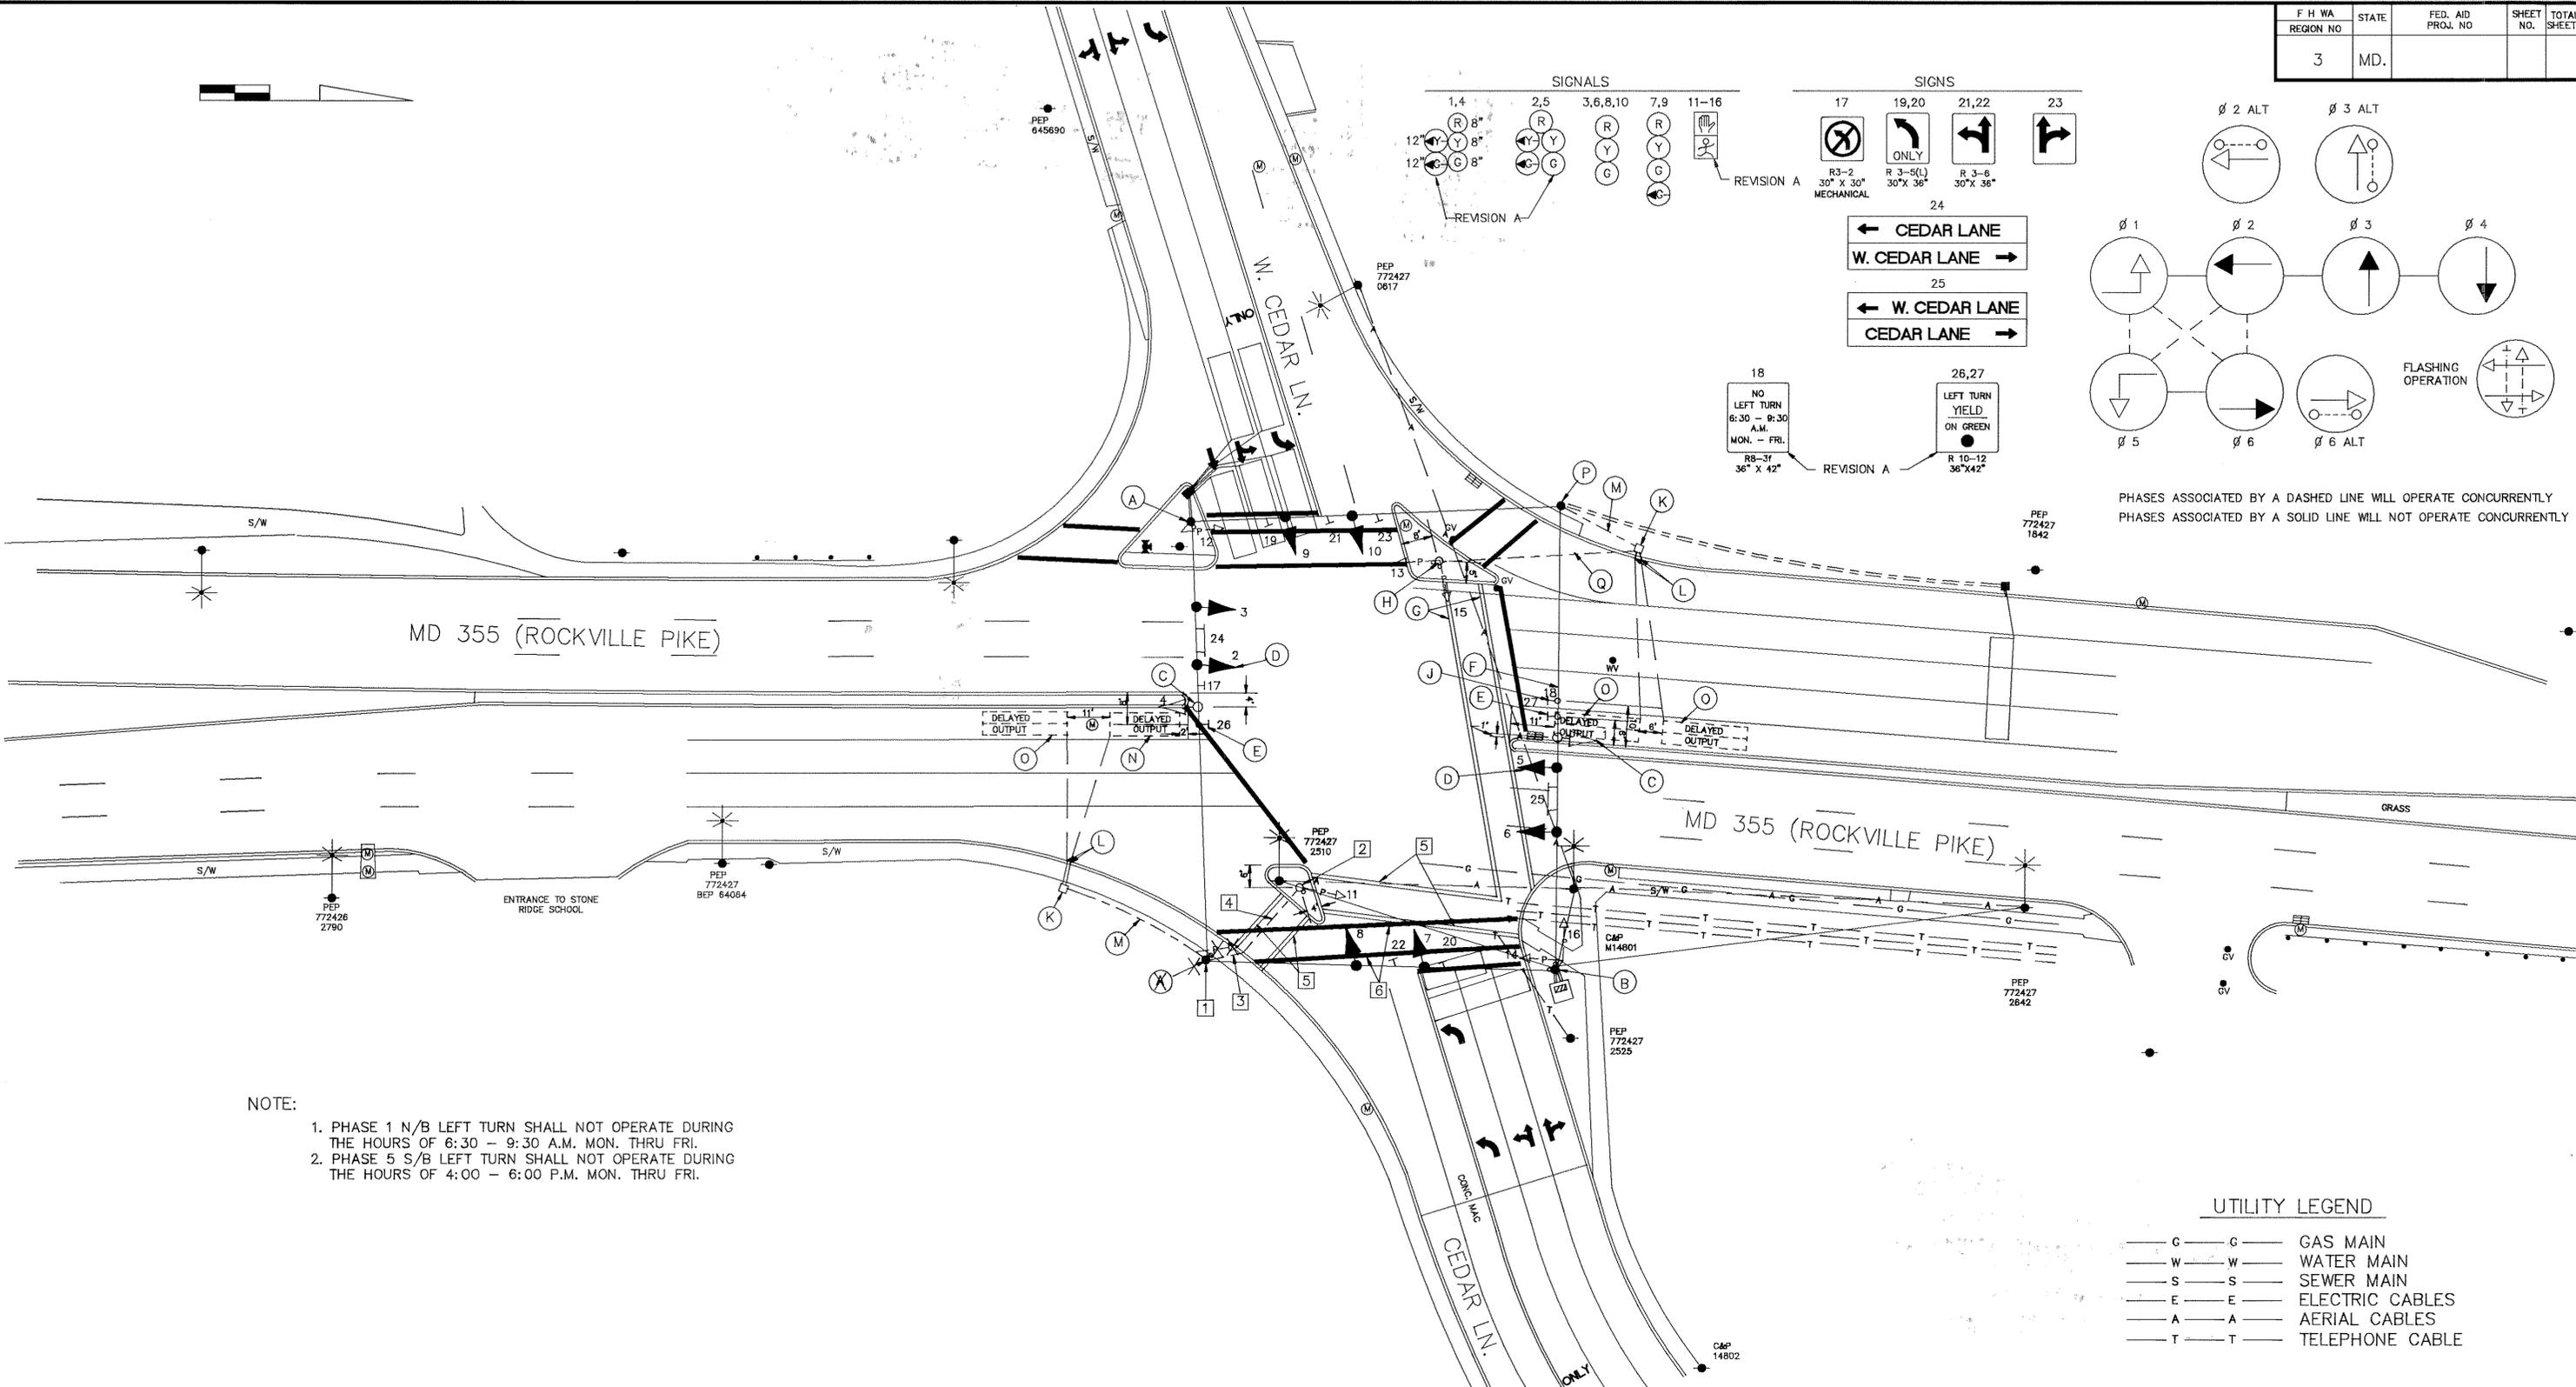

- NOTE:
1. PHASE 1 N/B LEFT TURN SHALL NOT OPERATE DURING THE HOURS OF 6:30 - 9:30 A.M. MON. THRU FRI.
 2. PHASE 5 S/B LEFT TURN SHALL NOT OPERATE DURING THE HOURS OF 4:00 - 6:00 P.M. MON. THRU FRI.

UTILITY LEGEND

| | |
|-------|-----------------|
| — G — | GAS MAIN |
| — W — | WATER MAIN |
| — S — | SEWER MAIN |
| — E — | ELECTRIC CABLES |
| — A — | AERIAL CABLES |
| — T — | TELEPHONE CABLE |

| | | | | | |
|---|--|---|--|---|--|
| REVISIONS 2/92 REVISION 2 REVISE PEDESTRIAN SIGNAL AND CROSS-WALK LOCATION W/B CEDAR LN. S.H.A. NO. 885-25031189 11/81 INSTALL E/P LEFT TURNS AND PED. BUTTONS AND SIGNALS. D.D. D.Z. E.T. T.H. | | APPROVALS CHIEF, SIGNAL DESIGN SECTION ASST. DISTRICT ENGINEER, TRAFFIC CHIEF, TRAFFIC ENGINEERING DIVISION DEPUTY CHIEF ENGINEER, OFFICE OF TRAFFIC | | MARYLAND DEPARTMENT OF TRANSPORTATION STATE HIGHWAY ADMINISTRATION - OFFICE OF TRAFFIC TRAFFIC ENGINEERING DIVISION | |
| DRAWN BY: BRUCE THOMPSON DES. BY: CHK. BY: | | 15035514.32 COUNTY: MONTGOMERY | | DATE: 10-28-91 SCALE: 1"=20' F.A.P. NO.: S.H.A. NO.: | |
| | | MD 355 and CEDAR LANE | | SHEET NO. 3189 B OF | |

Log 15035514.32