F.H.W.A. REGION NO.	STATE	FED. AID PROJ. NO.	SHEET NO.	TOTAL SHEETS
3	MD			

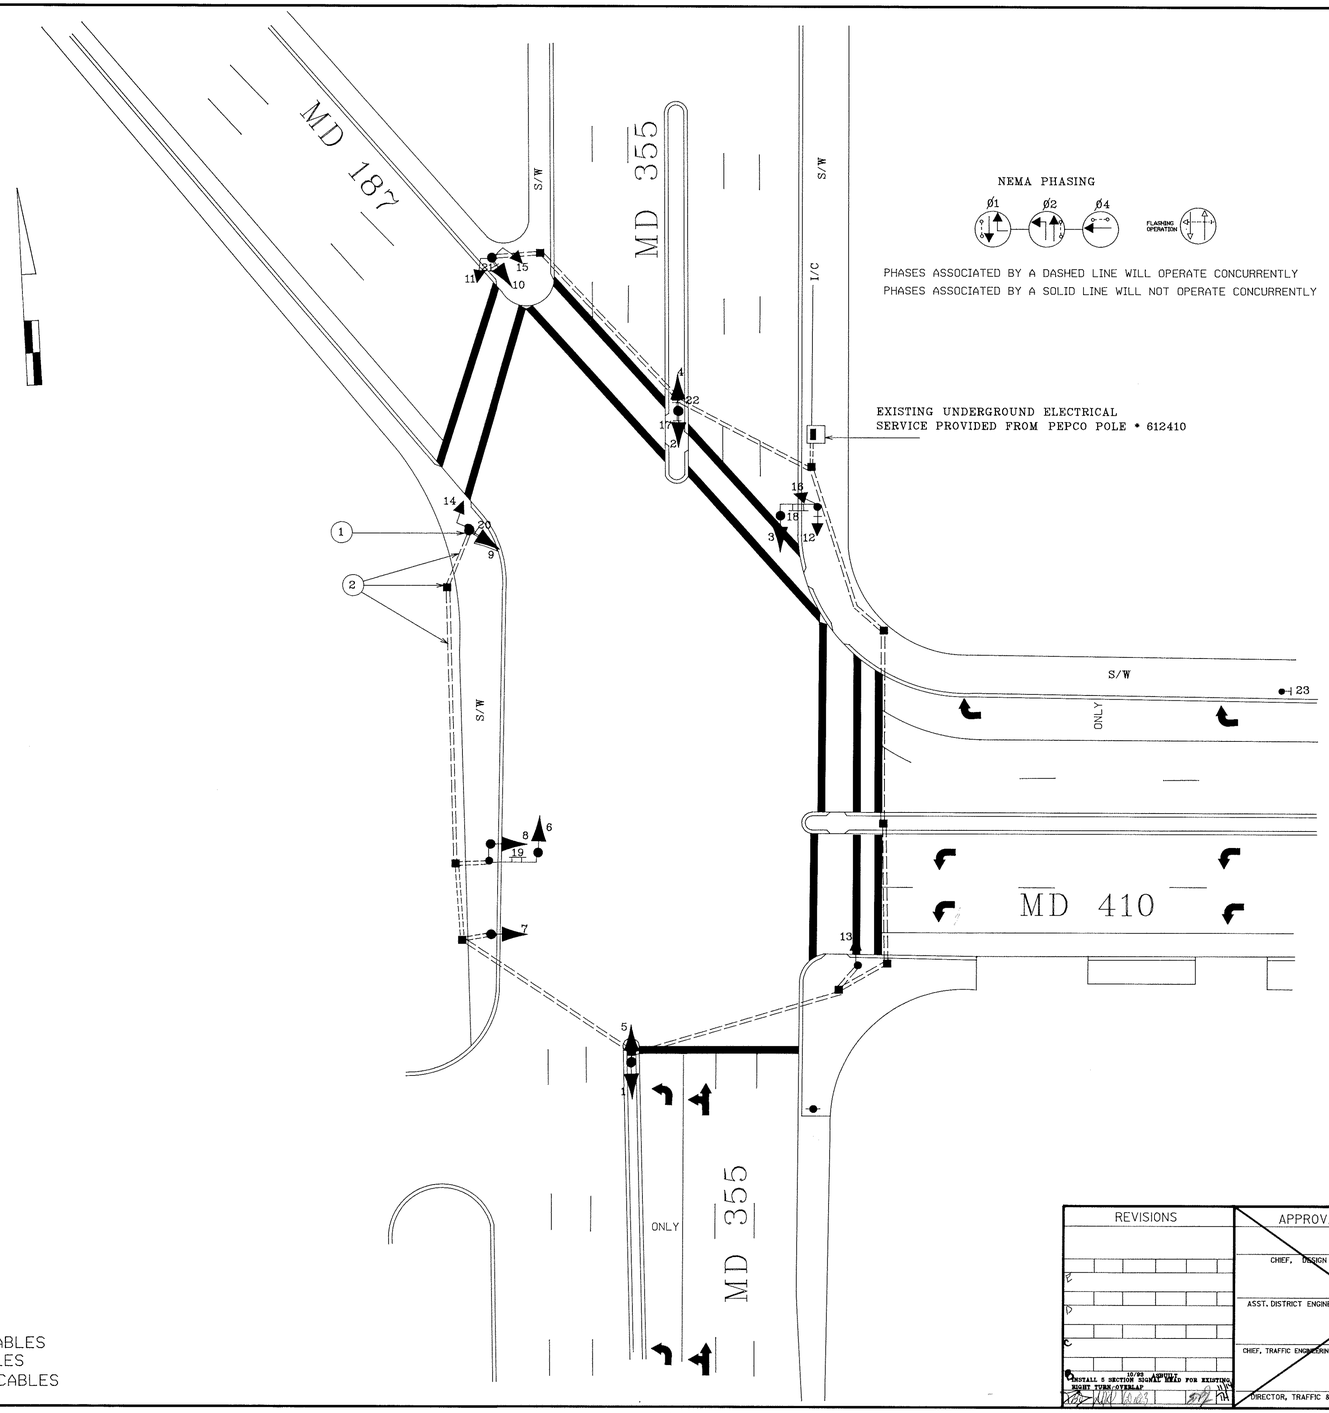

NEMA PHASING

PHASES ASSOCIATED BY A DASHED LINE WILL OPERATE CONCURRENTLY
PHASES ASSOCIATED BY A SOLID LINE WILL NOT OPERATE CONCURRENTLY

PROPOSED SIGN

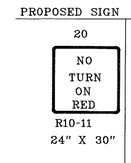

PROPOSED SIGNALS

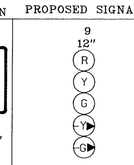

EXISTING SIGNALS

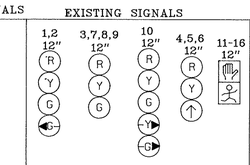

EXISTING SIGNS

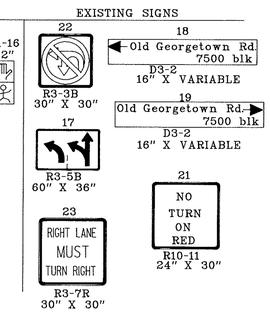

UTILITY LEGEND

—— G —— G ——	GAS MAIN
—— W —— W ——	WATER MAIN
—— S —— S ——	SEWER MAIN
—— E —— E ——	ELECTRIC CABLES
—— A —— A ——	AERIAL CABLES
—— T —— T ——	TELEPHONE CABLES

REVISIONS	APPROVALS	REVISIONS
	CHIEF, DESIGN SECTION	
	ASST. DISTRICT ENGINEER, TRAFFIC	
	CHIEF, TRAFFIC ENGINEERING DESIGN DIVISION	
	DIRECTOR, TRAFFIC & SAFETY	

MARYLAND DOT - STATE HIGHWAY ADMINISTRATION
Office of Traffic & Safety
TRAFFIC ENGINEERING DESIGN DIVISION

MD 355 AND MD 410/MD 187

DRAWN BY: D. DICKERSON	F.A.P. NO.		PLAN SHEET NO.: TS-2694 B	SHEET NO. ___ OF ___
CHECK BY:	S.H.A. NO.			
SCALE: 1" - 20'	COUNTY	MONTGOMERY		

F# 38

15035501.72 ? B?