F.H.W.A. REGION NO.	STATE	FED. AID PROJ. NO.	SHEET NO.	TOTAL SHEETS
3	MD.	MG-5007(2)	6	18

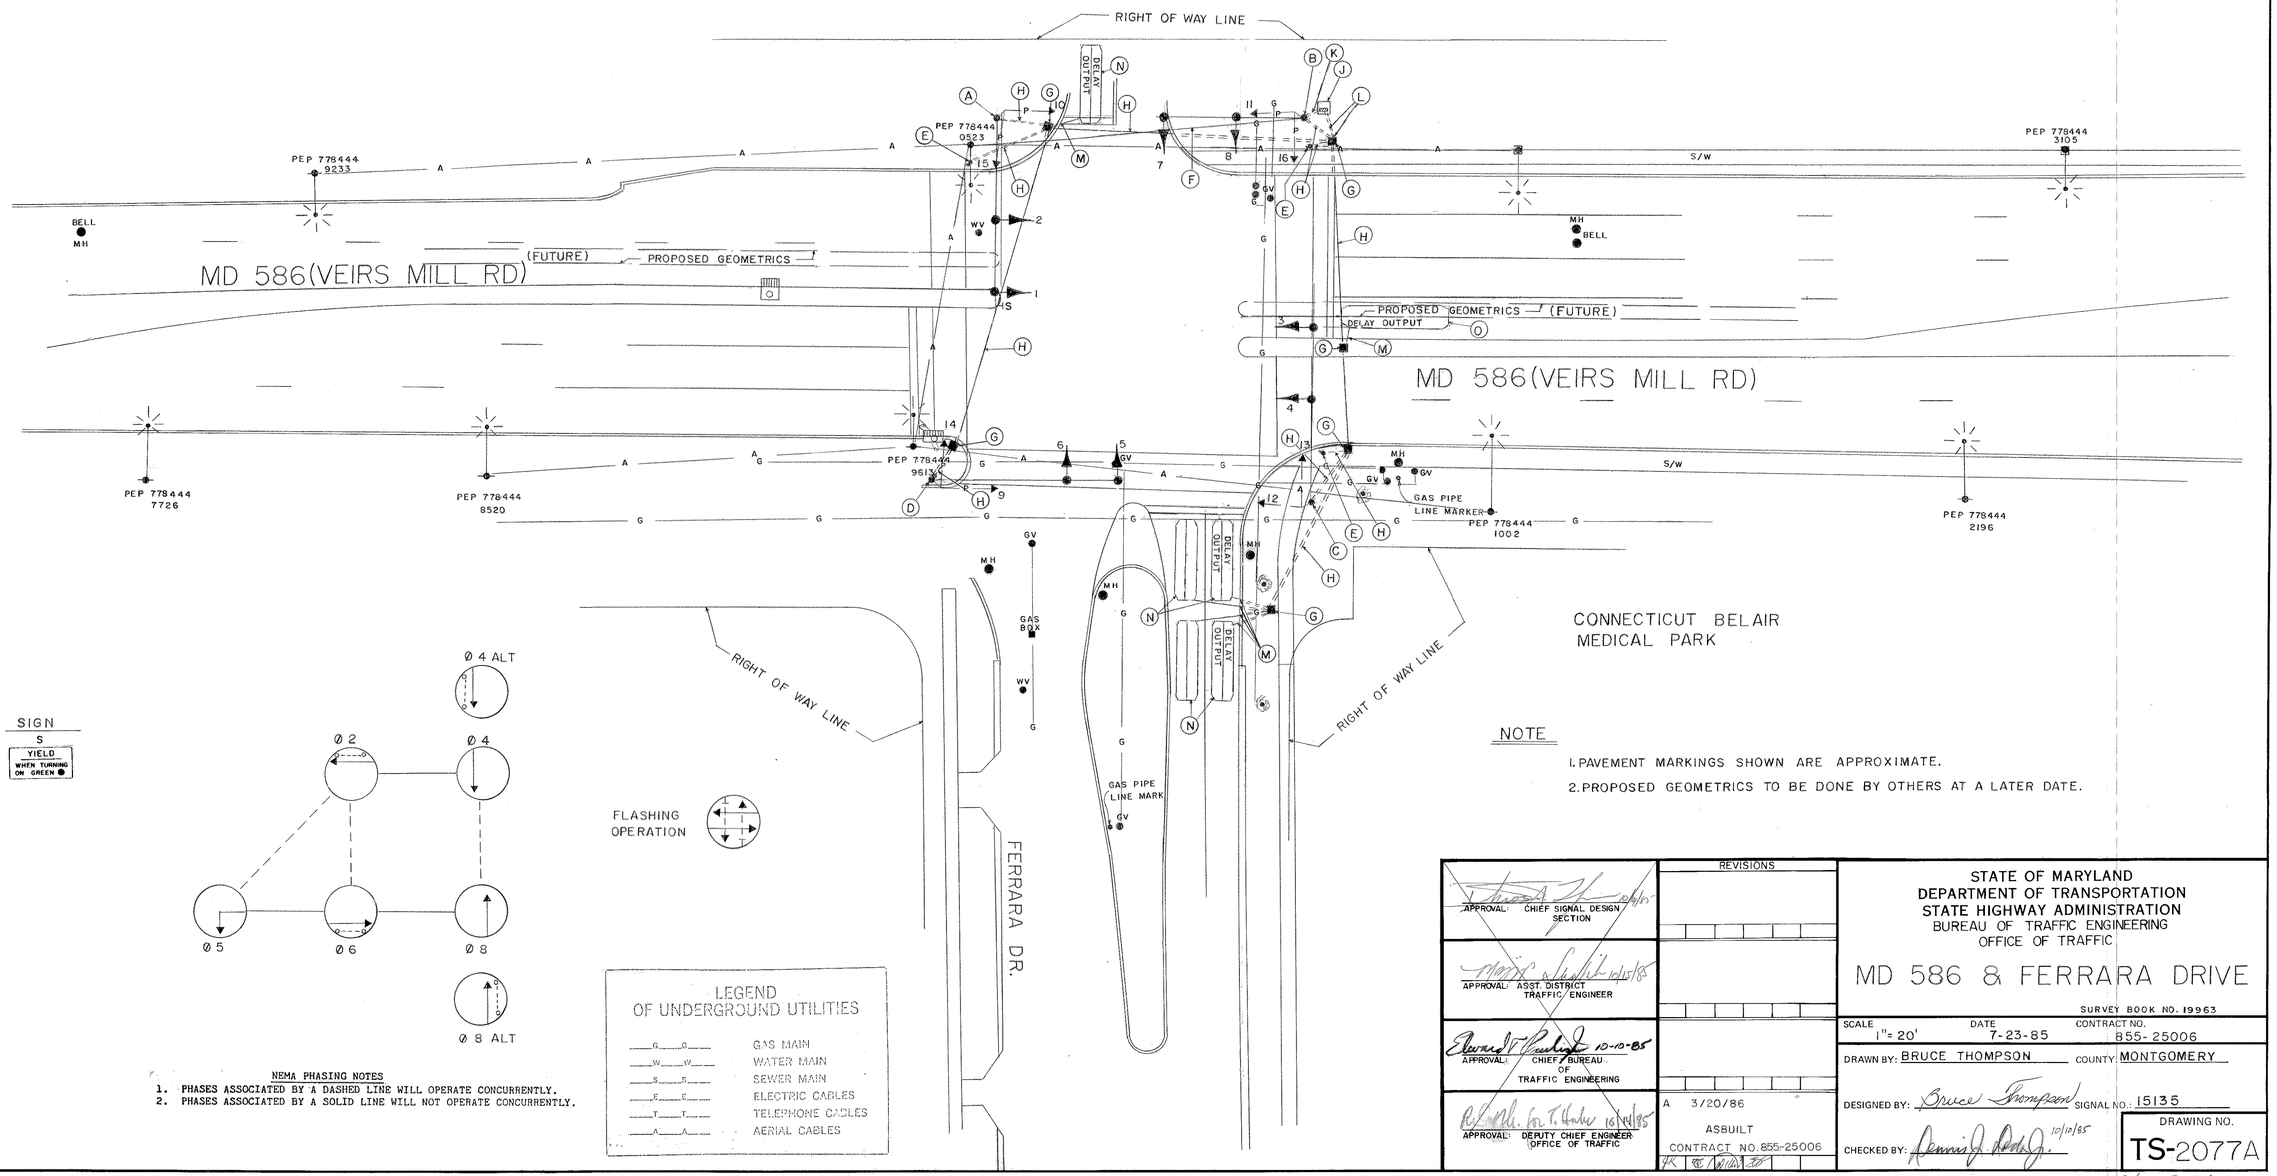

APPROVAL: CHIEF SIGNAL DESIGN SECTION 10/15/85

APPROVAL: ASST. DISTRICT TRAFFIC ENGINEER 10/15/85

APPROVAL: CHIEF BUREAU OF TRAFFIC ENGINEERING 10-10-85

APPROVAL: DEPUTY CHIEF ENGINEER OFFICE OF TRAFFIC for T. Hooker 10/10/85

REVISIONS

A 3/20/86 ASBUILT CONTRACT NO. 855-25006

STATE OF MARYLAND
DEPARTMENT OF TRANSPORTATION
STATE HIGHWAY ADMINISTRATION
BUREAU OF TRAFFIC ENGINEERING
OFFICE OF TRAFFIC

MD 586 & FERRARA DRIVE

SURVEY BOOK NO. 19963

SCALE 1" = 20' | DATE 7-23-85 | CONTRACT NO. 855-25006

DRAWN BY: BRUCE THOMPSON | COUNTY: MONTGOMERY

DESIGNED BY: Bruce Thompson | SIGNAL NO.: 15135

CHECKED BY: 10/10/85

DRAWING NO. TS-2077A