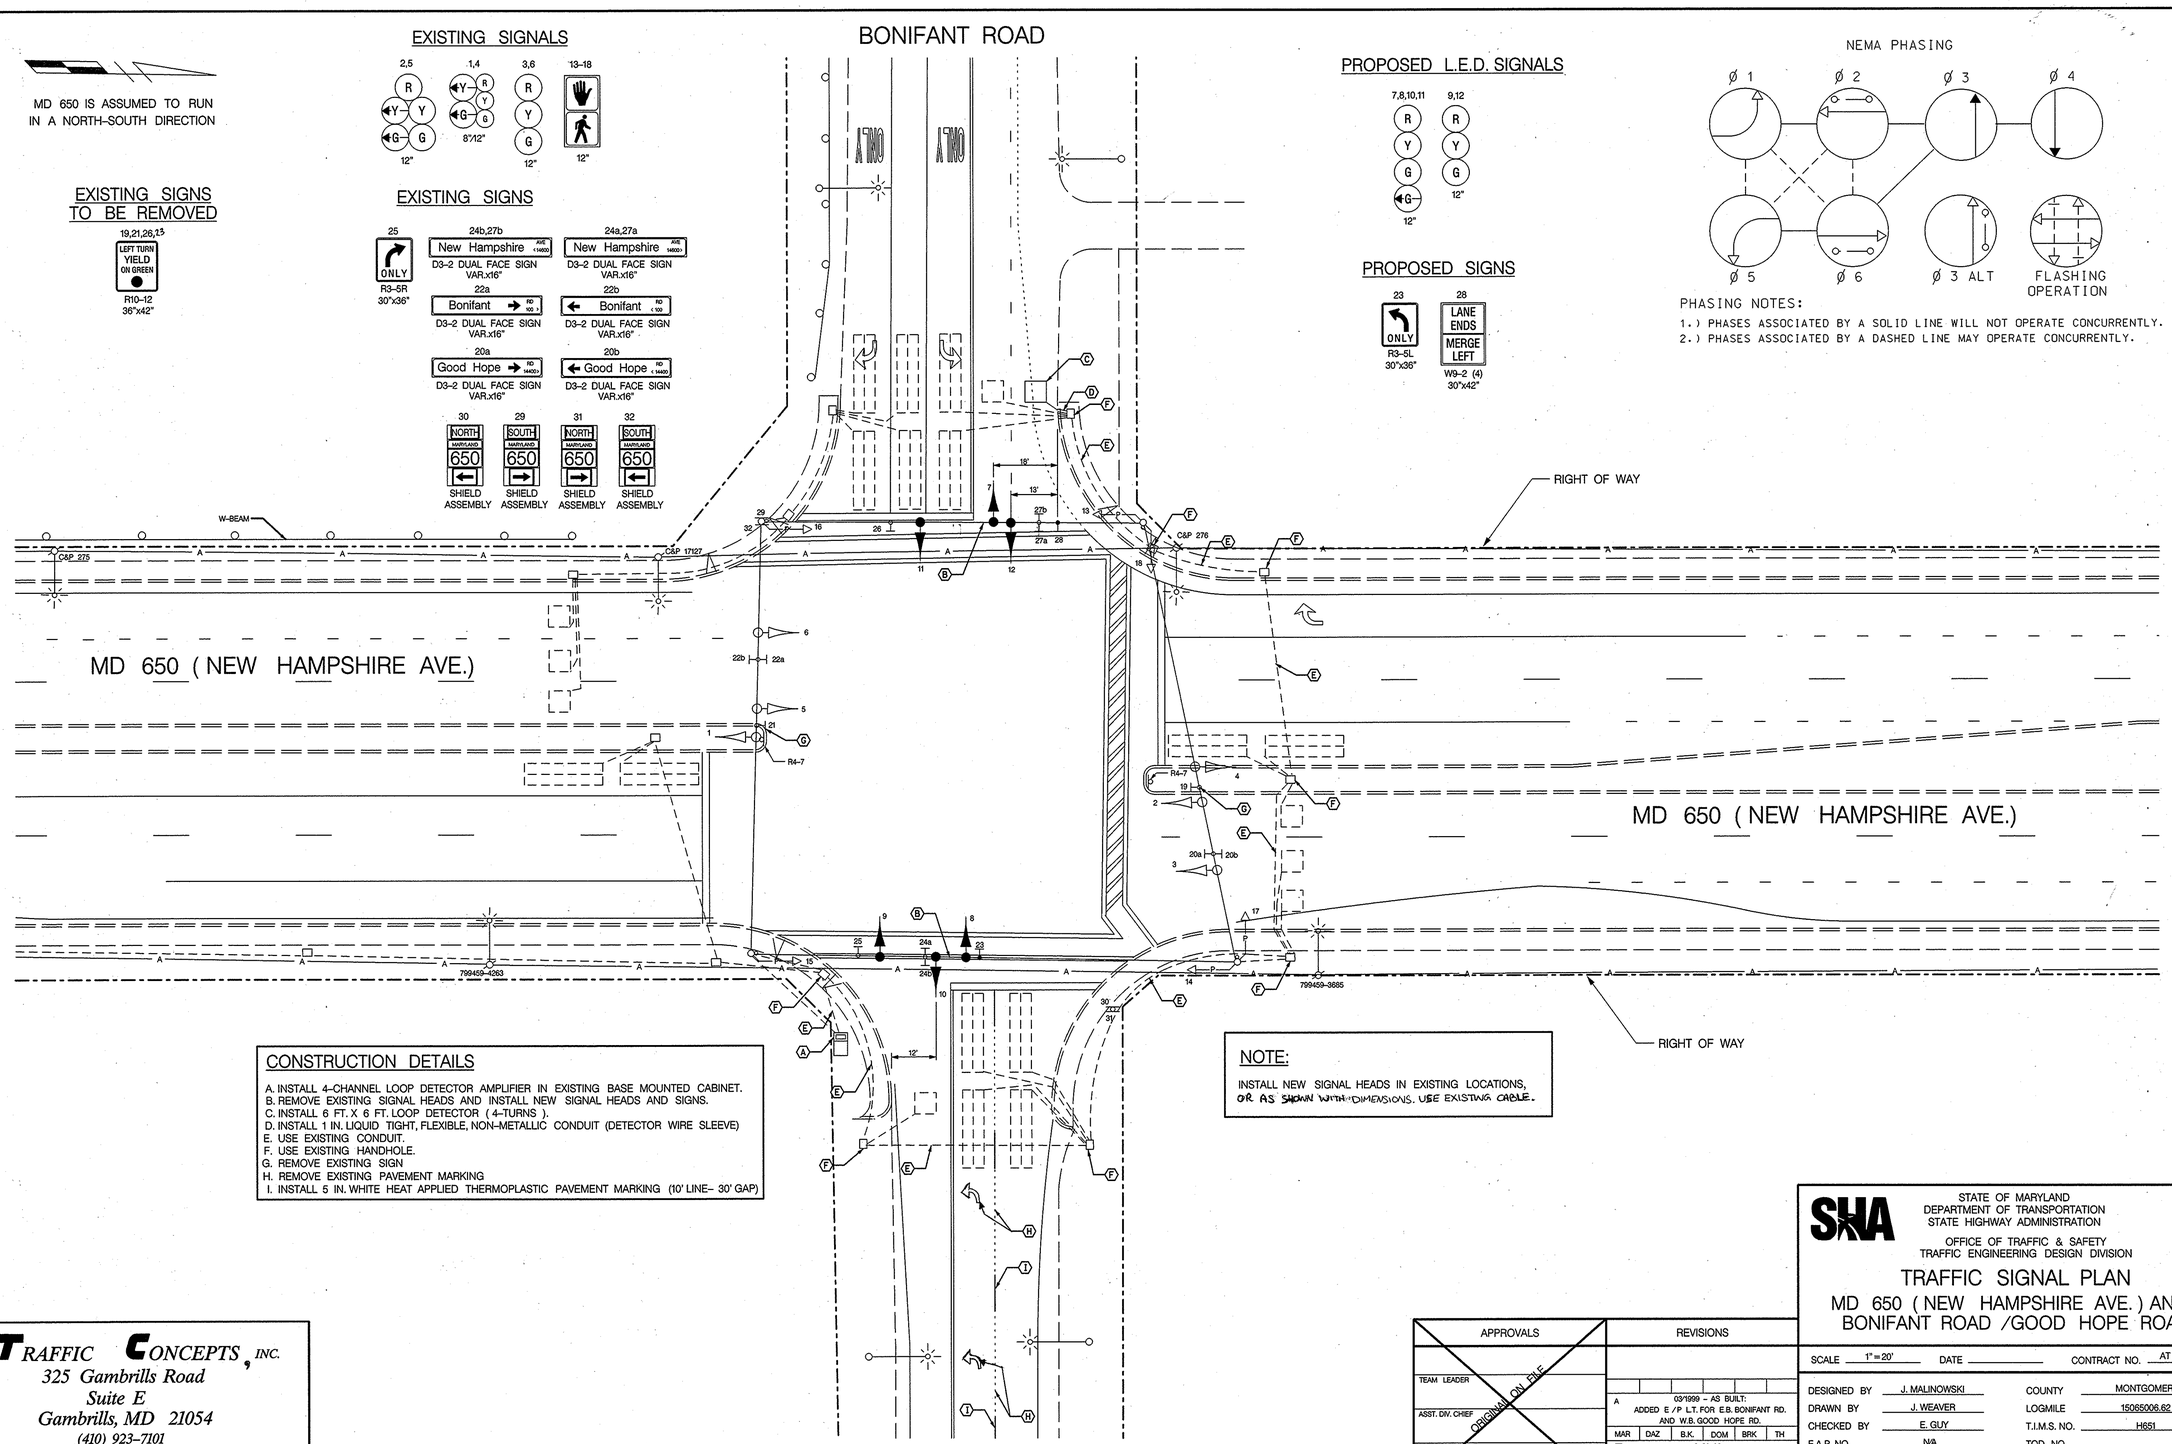

CONSTRUCTION DETAILS

A. INSTALL 4-CHANNEL LOOP DETECTOR AMPLIFIER IN EXISTING BASE MOUNTED CABINET.
B. REMOVE EXISTING SIGNAL HEADS AND INSTALL NEW SIGNAL HEADS AND SIGNS.
C. INSTALL 6 FT. X 6 FT. LOOP DETECTOR (4-TURNS).
D. INSTALL 1 IN. LIQUID TIGHT, FLEXIBLE, NON-METALLIC CONDUIT (DETECTOR WIRE SLEEVE)
E. USE EXISTING CONDUIT.
F. USE EXISTING HANDHOLE.
G. REMOVE EXISTING SIGN
H. REMOVE EXISTING PAVEMENT MARKING
I. INSTALL 5 IN. WHITE HEAT APPLIED THERMOPLASTIC PAVEMENT MARKING (10' LINE- 30' GAP)

NOTE:

INSTALL NEW SIGNAL HEADS IN EXISTING LOCATIONS, OR AS SHOWN WITH DIMENSIONS. USE EXISTING CABLE.

TRAFFIC CONCEPTS, INC.
325 Gambrills Road
Suite E
Gambrills, MD 21054
(410) 923-7101
FAX (410) 923-6473
EMAIL TRAFFIC.CONCEPTS@COMCAST.NET

APPROVALS	REVISIONS
TEAM LEADER	A 03/1999 - AS BUILT: ADDED E / P L.T. FOR E.B. BONIFANT RD. AND W.B. GOOD HOPE RD.
ASST. DIV. CHIEF	MAR / DAZ / B.K. / DOM / BRK / TH
DIVISION CHIEF	B 6-20-06 SPLIT SIDE STREET PHASING SHA NO. BW-996M82
OFFICE DIRECTOR	TZ

ORIGINAL ON FILE

SHA
STATE OF MARYLAND
DEPARTMENT OF TRANSPORTATION
STATE HIGHWAY ADMINISTRATION
OFFICE OF TRAFFIC & SAFETY
TRAFFIC ENGINEERING DESIGN DIVISION

TRAFFIC SIGNAL PLAN
MD 650 (NEW HAMPSHIRE AVE.) AND BONIFANT ROAD /GOOD HOPE ROAD

SCALE 1"=20' DATE CONTRACT NO. AT 3585185

DESIGNED BY	J. MALINOWSKI	COUNTY	MONTGOMERY
DRAWN BY	J. WEAVER	LOGMILE	15065006.62
CHECKED BY	E. GUY	T.I.M.S. NO.	H651
F.A.P. NO.	N/A	TOD NO.	

DRAWING NO. TS-3399 B SHEET NO. 1 OF 2

m:\1700\1786\base.dgn Jun. 21, 2006 10:19:38