F H WA REGION NO	STATE	FED. AID PROJ. NO	SHEET NO.	TOTAL SHEETS
3	MD.			

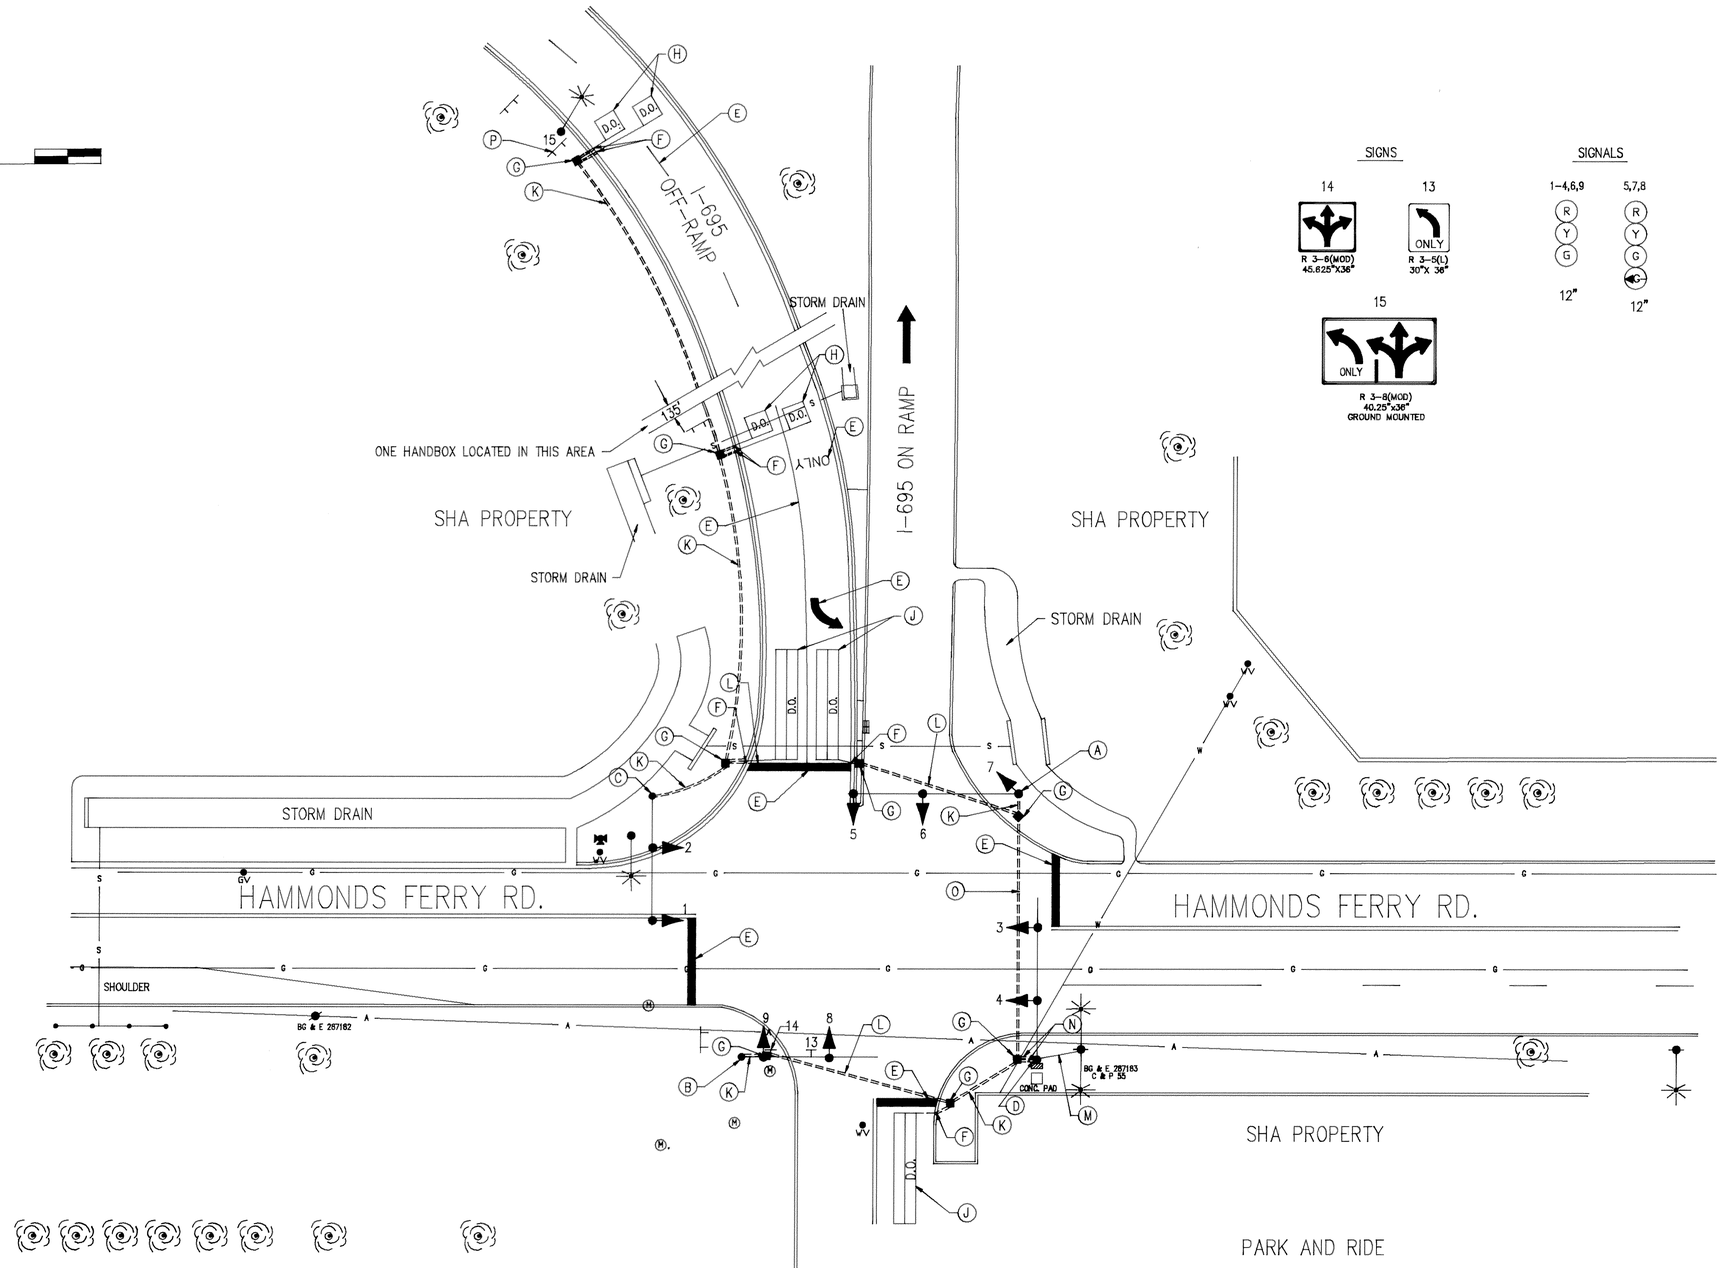

SIGNS

SIGNALS

NEMA PHASING

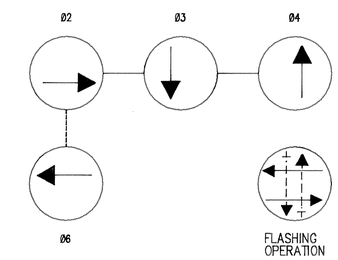

PHASING NOTES

1. Phases associated by a solid line will not operate concurrently.
2. Phases associated by a dashed line will operate concurrently.

GENERAL NOTES

1. D.O. INDICATES DELAY-OUTPUT LOOP DETECTOR.

UTILITY LEGEND

G	GAS MAIN
W	WATER MAIN
S	SEWER MAIN
E	ELECTRIC CABLES
T	TELEPHONE CABLES
A	AERIAL CABLES

REVISIONS	APPROVALS
(A) 12-10-90 AS-BUILT TGM	CHIEF, SIGNAL DESIGN SECTION ORIGINAL ASST. DISTRICT ENGINEER, TRAFFIC ON CHIEF, TRAFFIC ENGINEERING DIVISION FILE DEPUTY CHIEF ENGINEER, OFFICE OF TRAFFIC

MDOT – STATE HIGHWAY ADMINISTRATION
Office of Traffic
TRAFFIC ENGINEERING DIVISION

SIGNAL # 02069502.74

DRAWN BY: TEKIE MESKEL
DES. BY: TEKIE MESKEL
CHK. BY: D. DODA

HAMMONDS FERRY ROAD &
I-695 OFF-RAMP

COUNTY: ANNE ARUNDEL

DATE: 06/90
SCALE: 1" = 20'
F.A.P. NO.
S.H.A. NO.

TS/STD. NO. 2645 A

SHEET NO. 1 OF 1

02069502.74