F H WA REGION NO	STATE	FED. AID PROJ. NO	SHEET NO.	TOTAL SHEETS
3	MD.			

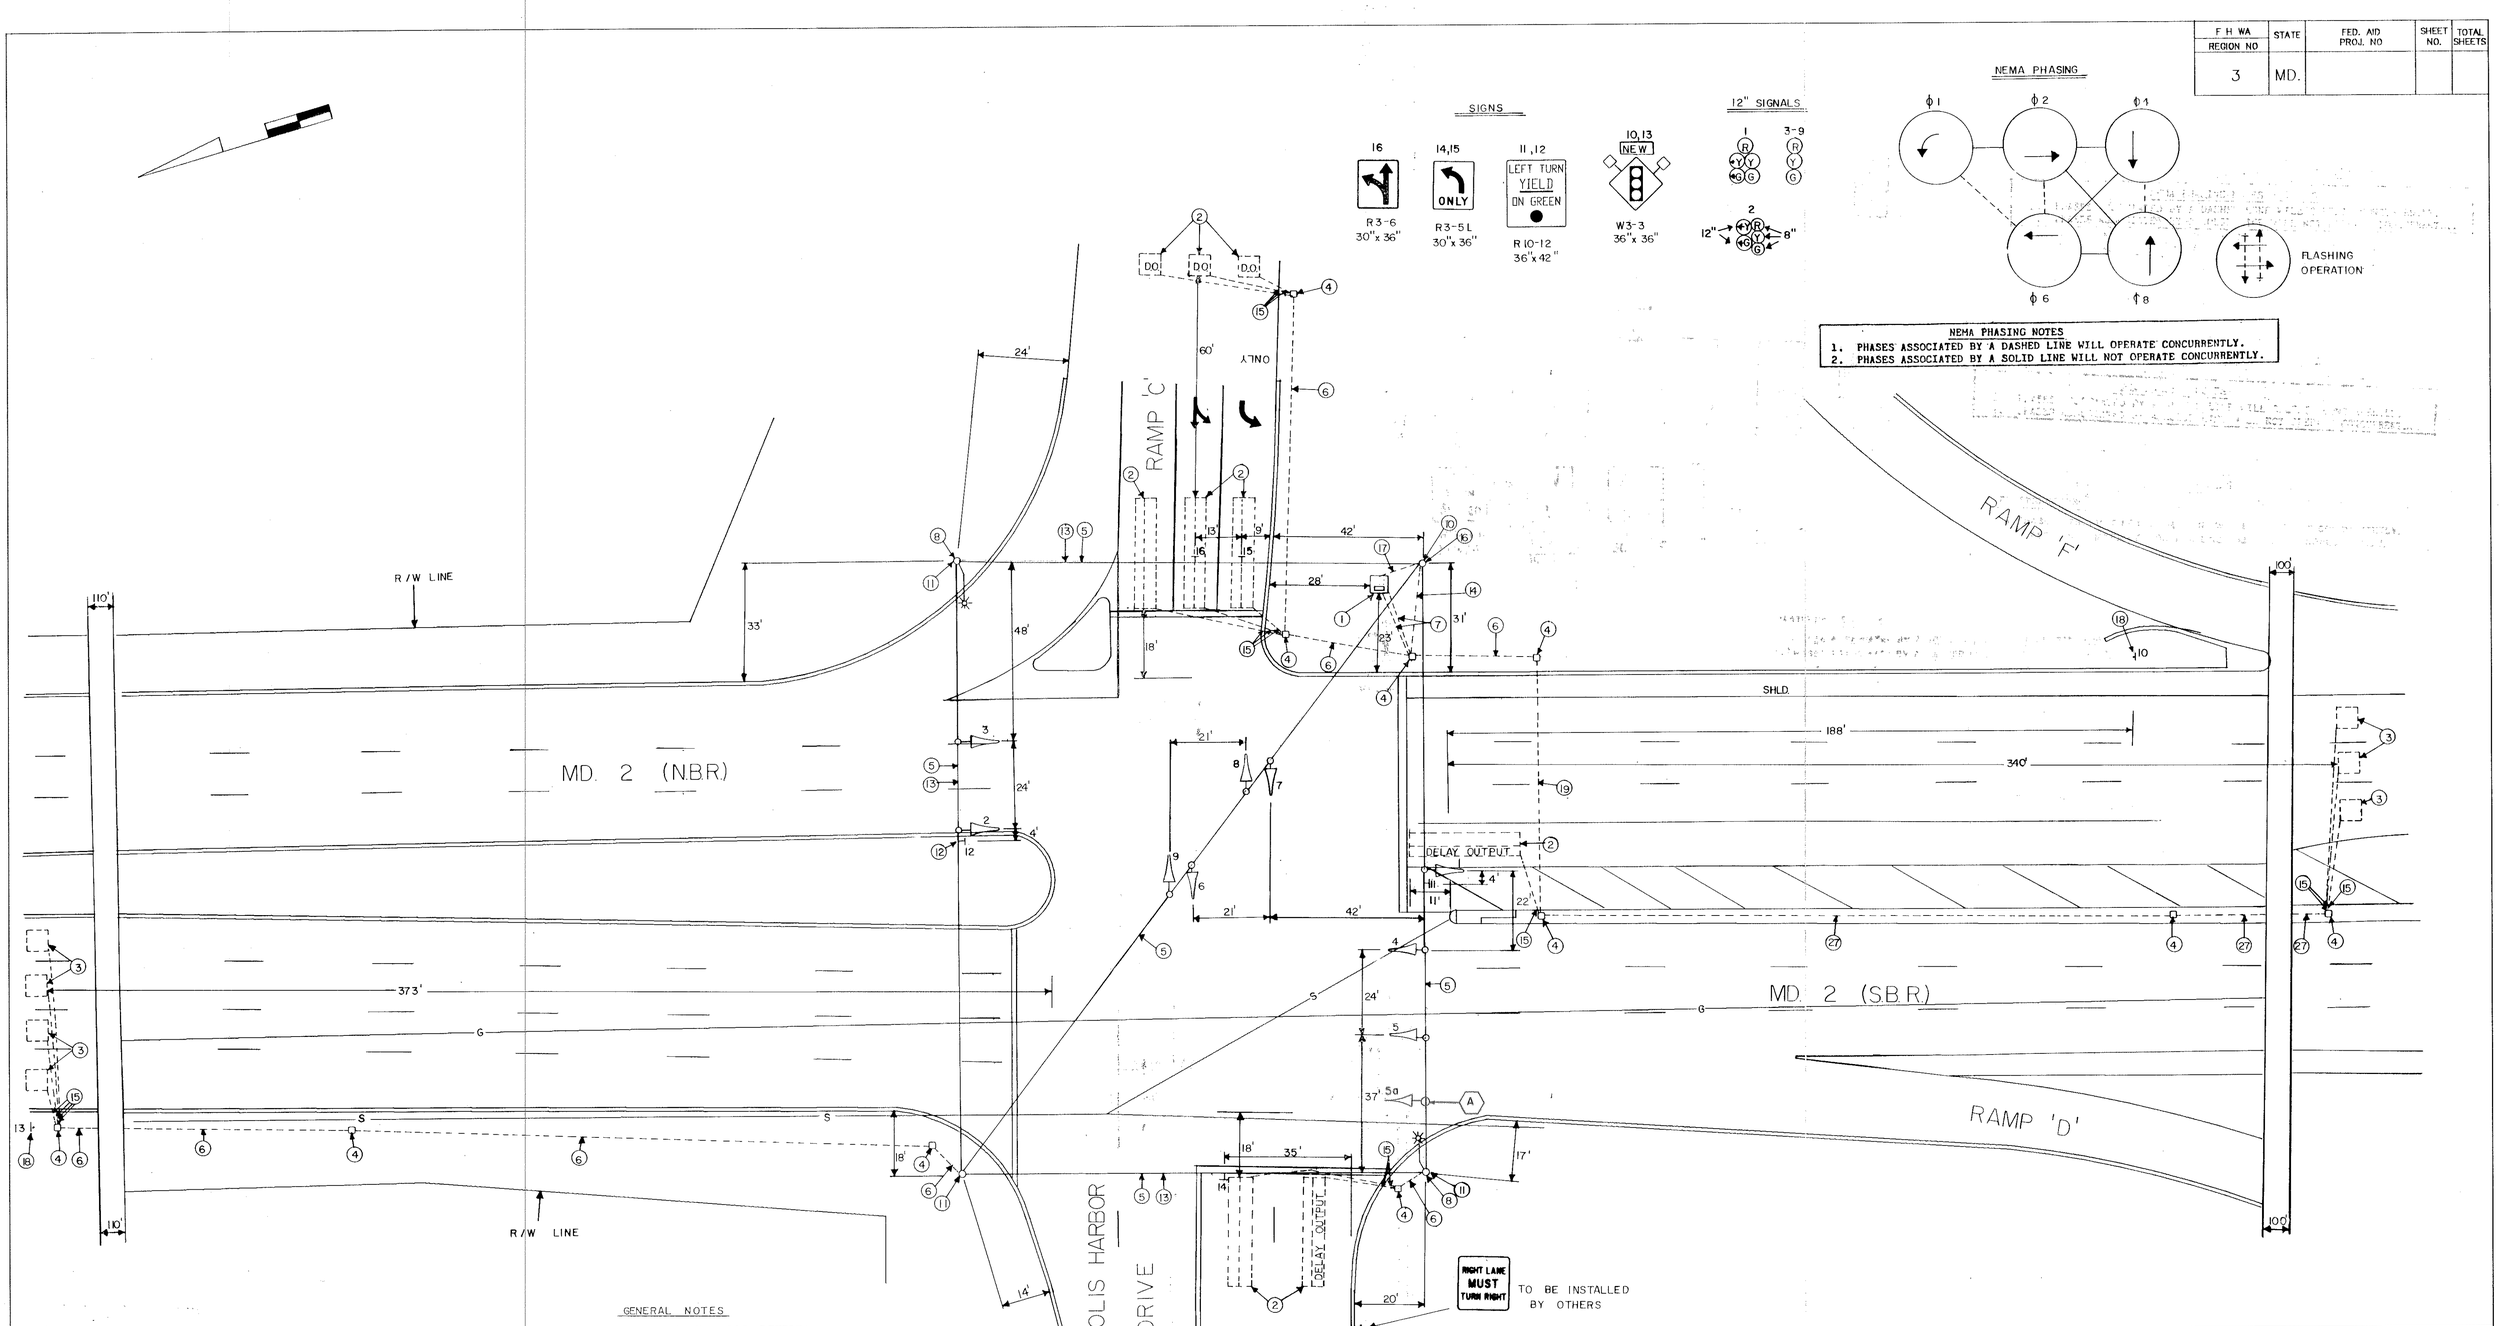

GENERAL NOTES

1. D.O. DENOTES DELAY OUTPUT LOOP DETECTOR.
2. PAVEMENT MARKINGS ARE NOT TO BE INSTALLED UNTIL LOOP DETECTORS AND CONDUIT INSTALLATIONS ARE COMPLETED.
3. CONTRACTOR SHALL CONFIRM THE LOCATION OF ALL PROPOSED GEOMETRICS PRIOR TO INSTALLING THE SIGNAL EQUIPMENT.

LEGEND OF UNDERGROUND UTILITIES

G G	GAS MAIN
W W	WATER MAIN
S S	SEWER MAIN
E E	ELECTRIC CABLES
T T	TELEPHONE CABLES
A A	AERIAL CABLES

REVISIONS	APPROVALS
(A) 9-28-94 ADD ADDITIONAL SIG HD FOR SB MD 2 DJD	CHIEF, SIGNAL DESIGN SECTION 10/26/88
	ASST. DISTRICT ENGINEER, TRAFFIC 10/26/88
	CHIEF, BUREAU OF TRAFFIC ENGINEERING 10/26/88
	DEPUTY CHIEF ENGINEER, OFFICE OF TRAFFIC 10/27/88

MARYLAND DEPARTMENT OF TRANSPORTATION
STATE HIGHWAY ADMINISTRATION — OFFICE OF TRAFFIC
BUREAU OF TRAFFIC ENGINEERING

DRAWN BY G. SIMMERS
DES. BY: G. SIMMERS
CHK. BY: 10/26/88

MD. 2 AT ANNAPOLIS HARBOR DR.

COUNTY: ANNE ARUNDEL

DATE: 9-15-88
SCALE: 1" = 20'
F.A.P. NO.
S.H.A. NO. AA-682-501-570 AA-317-501-571

TS/FILE NO. 2498A

SHEET NO. ___ OF ___

02000220.05

02000220.05