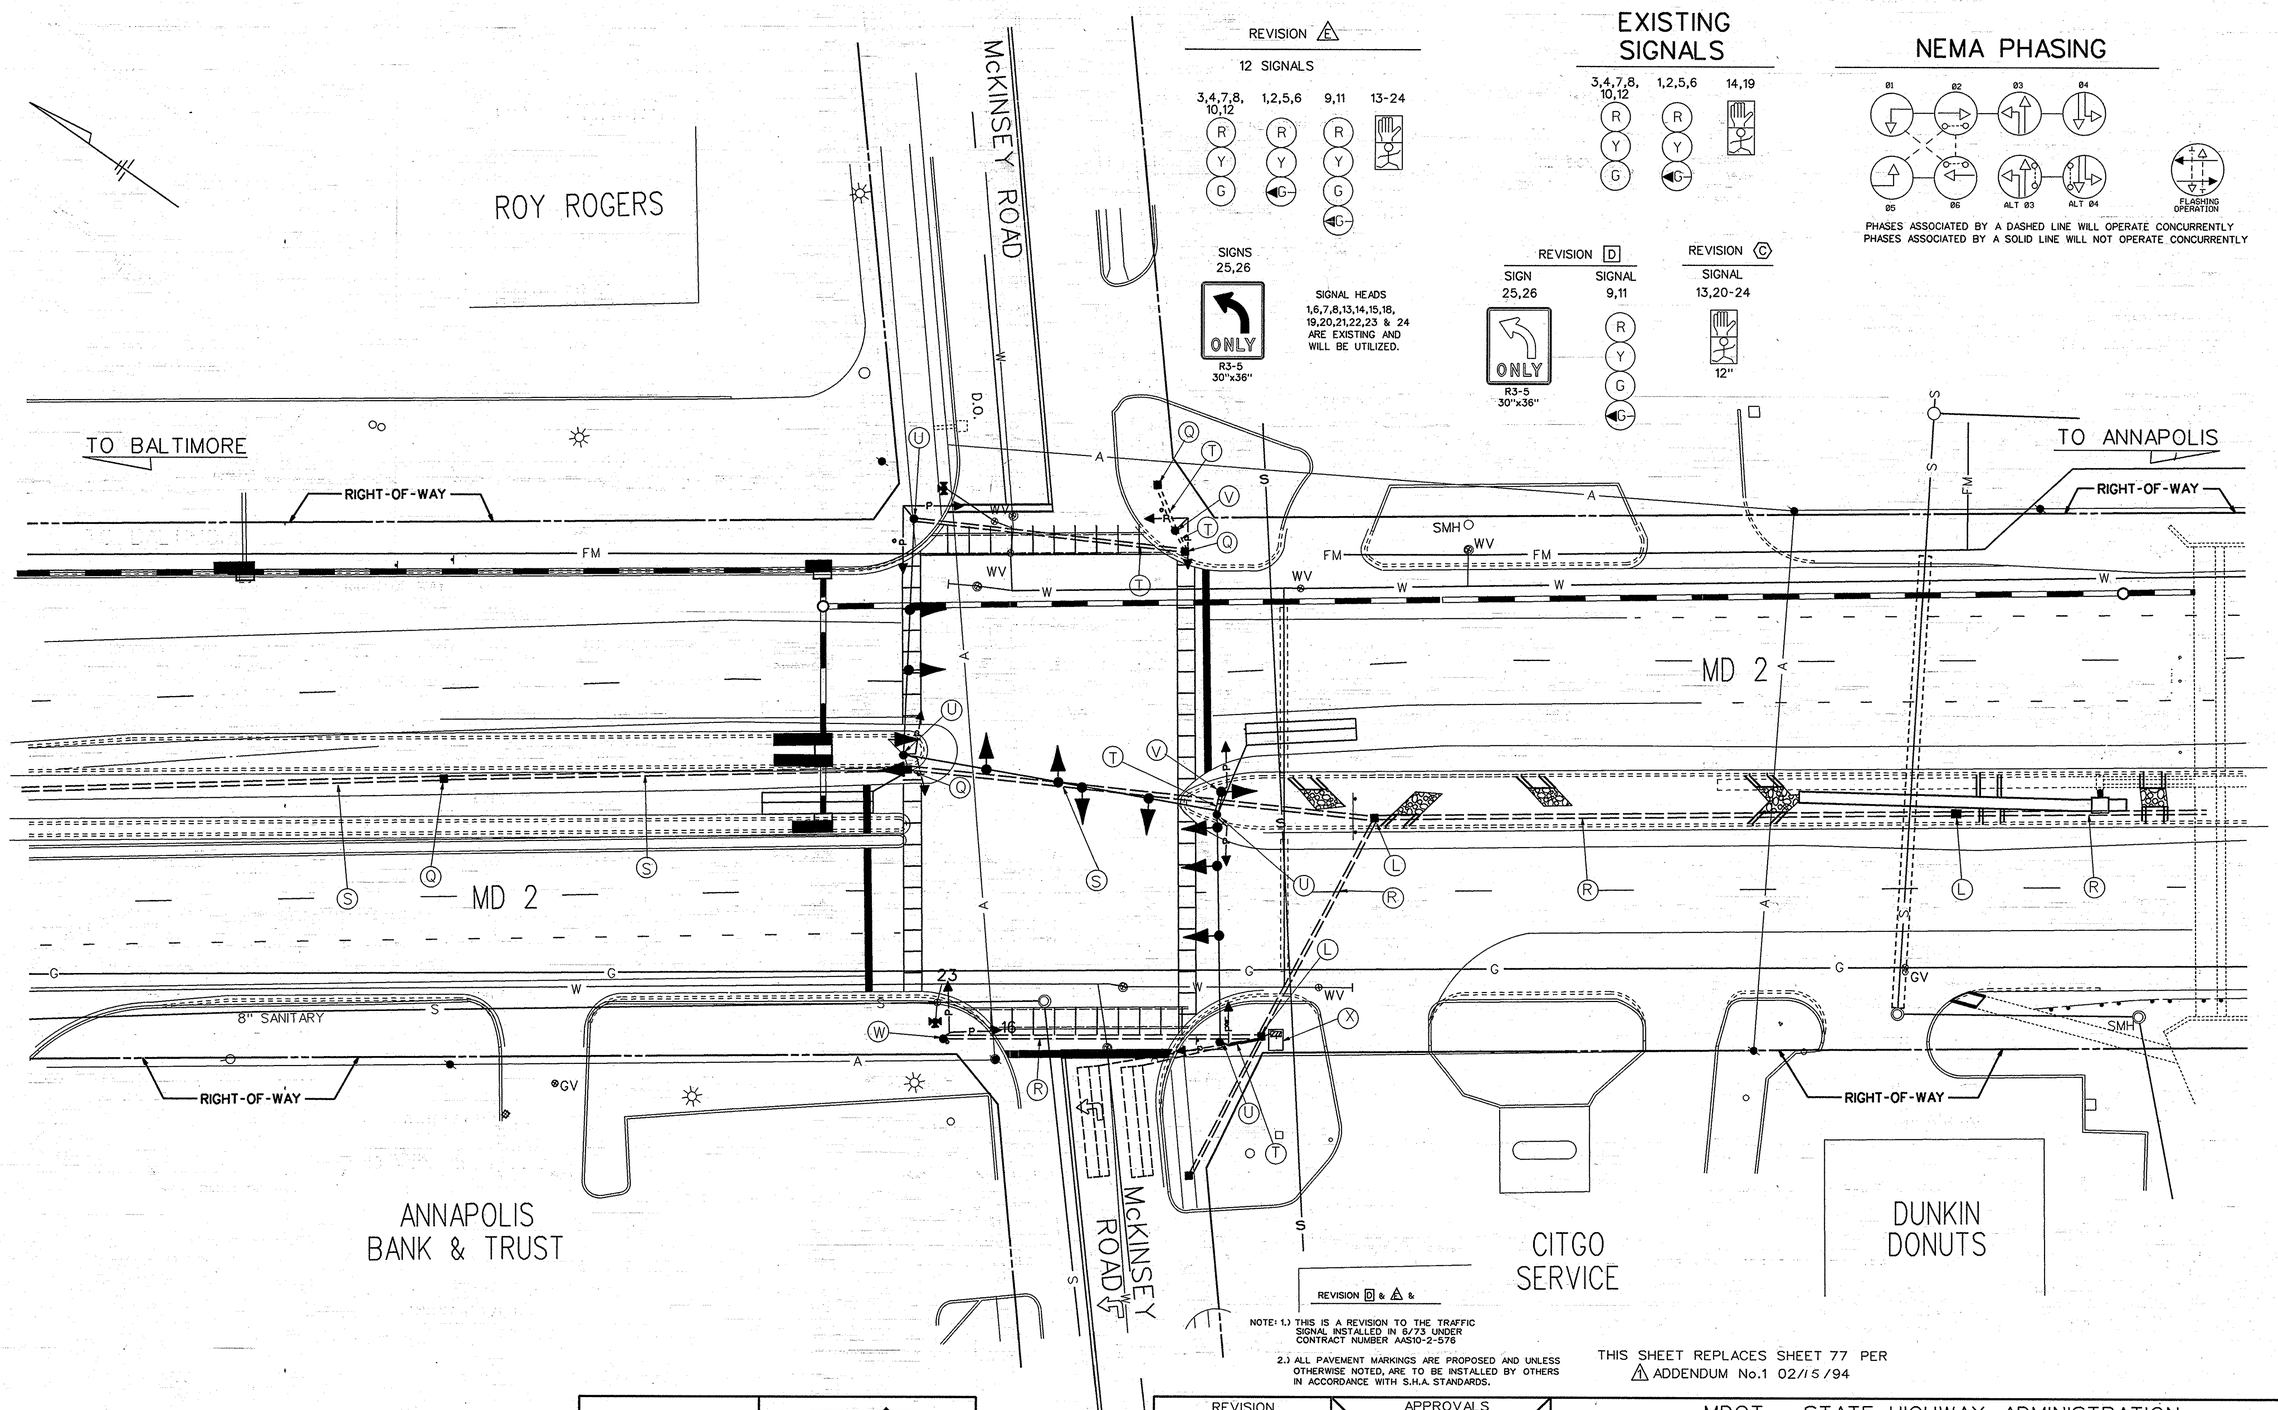

UTILITY LEGEND

G — G	GAS MAIN
W — W	WATER MAIN
S — S	SEWER MAIN
E — E	ELECTRIC CABLES
A — A	AERIAL CABLES
T — T	TELEPHONE CABLES

DANA P. KNIGHT P.E. 15553 DATE

KCI TECHNOLOGIES
KCI TECHNOLOGIES INC.
ENGINEERS AND PLANNERS
10 NORTH PARK DRIVE
HUNT VALLEY, MARYLAND
21030-1888
(410) 316-7800

REVISION	
E 1-27-87	REVISE DESIGN TO ACCOMMODATE NEW LEFT TURN BAY SHA NO. BW-936-801-512
D 5-21-86	ADD 4 SEC. SIGNALS FOR SIDE STREET SPLIT PHASE SHA NO. 855-26000
C 11-20-84	ADD PEDESTRIAN SIGNALS ACROSS THE SOUTH SIDE OF MD. 2 SHA NO. 855-25002
B 4-17-74	ASBUILT & REDRAWN
X 12-93	REMOVAL OF EXISTING EQUIPMENT

APPROVALS

ORIGINAL
CHIEF, SIGNAL DESIGN SECTION
ON
ASST. DISTRICT ENGINEER, TRAFFIC
FILE
CHIEF, TRAFFIC ENGINEERING DESIGN DIVISION
DIRECTOR, OFFICE OF TRAFFIC & SAFETY

MDOT - STATE HIGHWAY ADMINISTRATION
OFFICE OF TRAFFIC & SAFETY
TRAFFIC ENGINEERING DESIGN DIVISION

DRAWN BY: F DEBELIUS
DES. BY:
CHK. BY:

MD. 2 AND McKINSEY ROAD

COUNTY: ANNE ARUNDEL

DATE: 4/2/73
SCALE: 1" = 20'
F.A.P. NO. T 8005 (2)
S.H.A. NO. AA810-2-576
TS/STD. NO. TS-303 X
SHEET NO. 77 OF 106