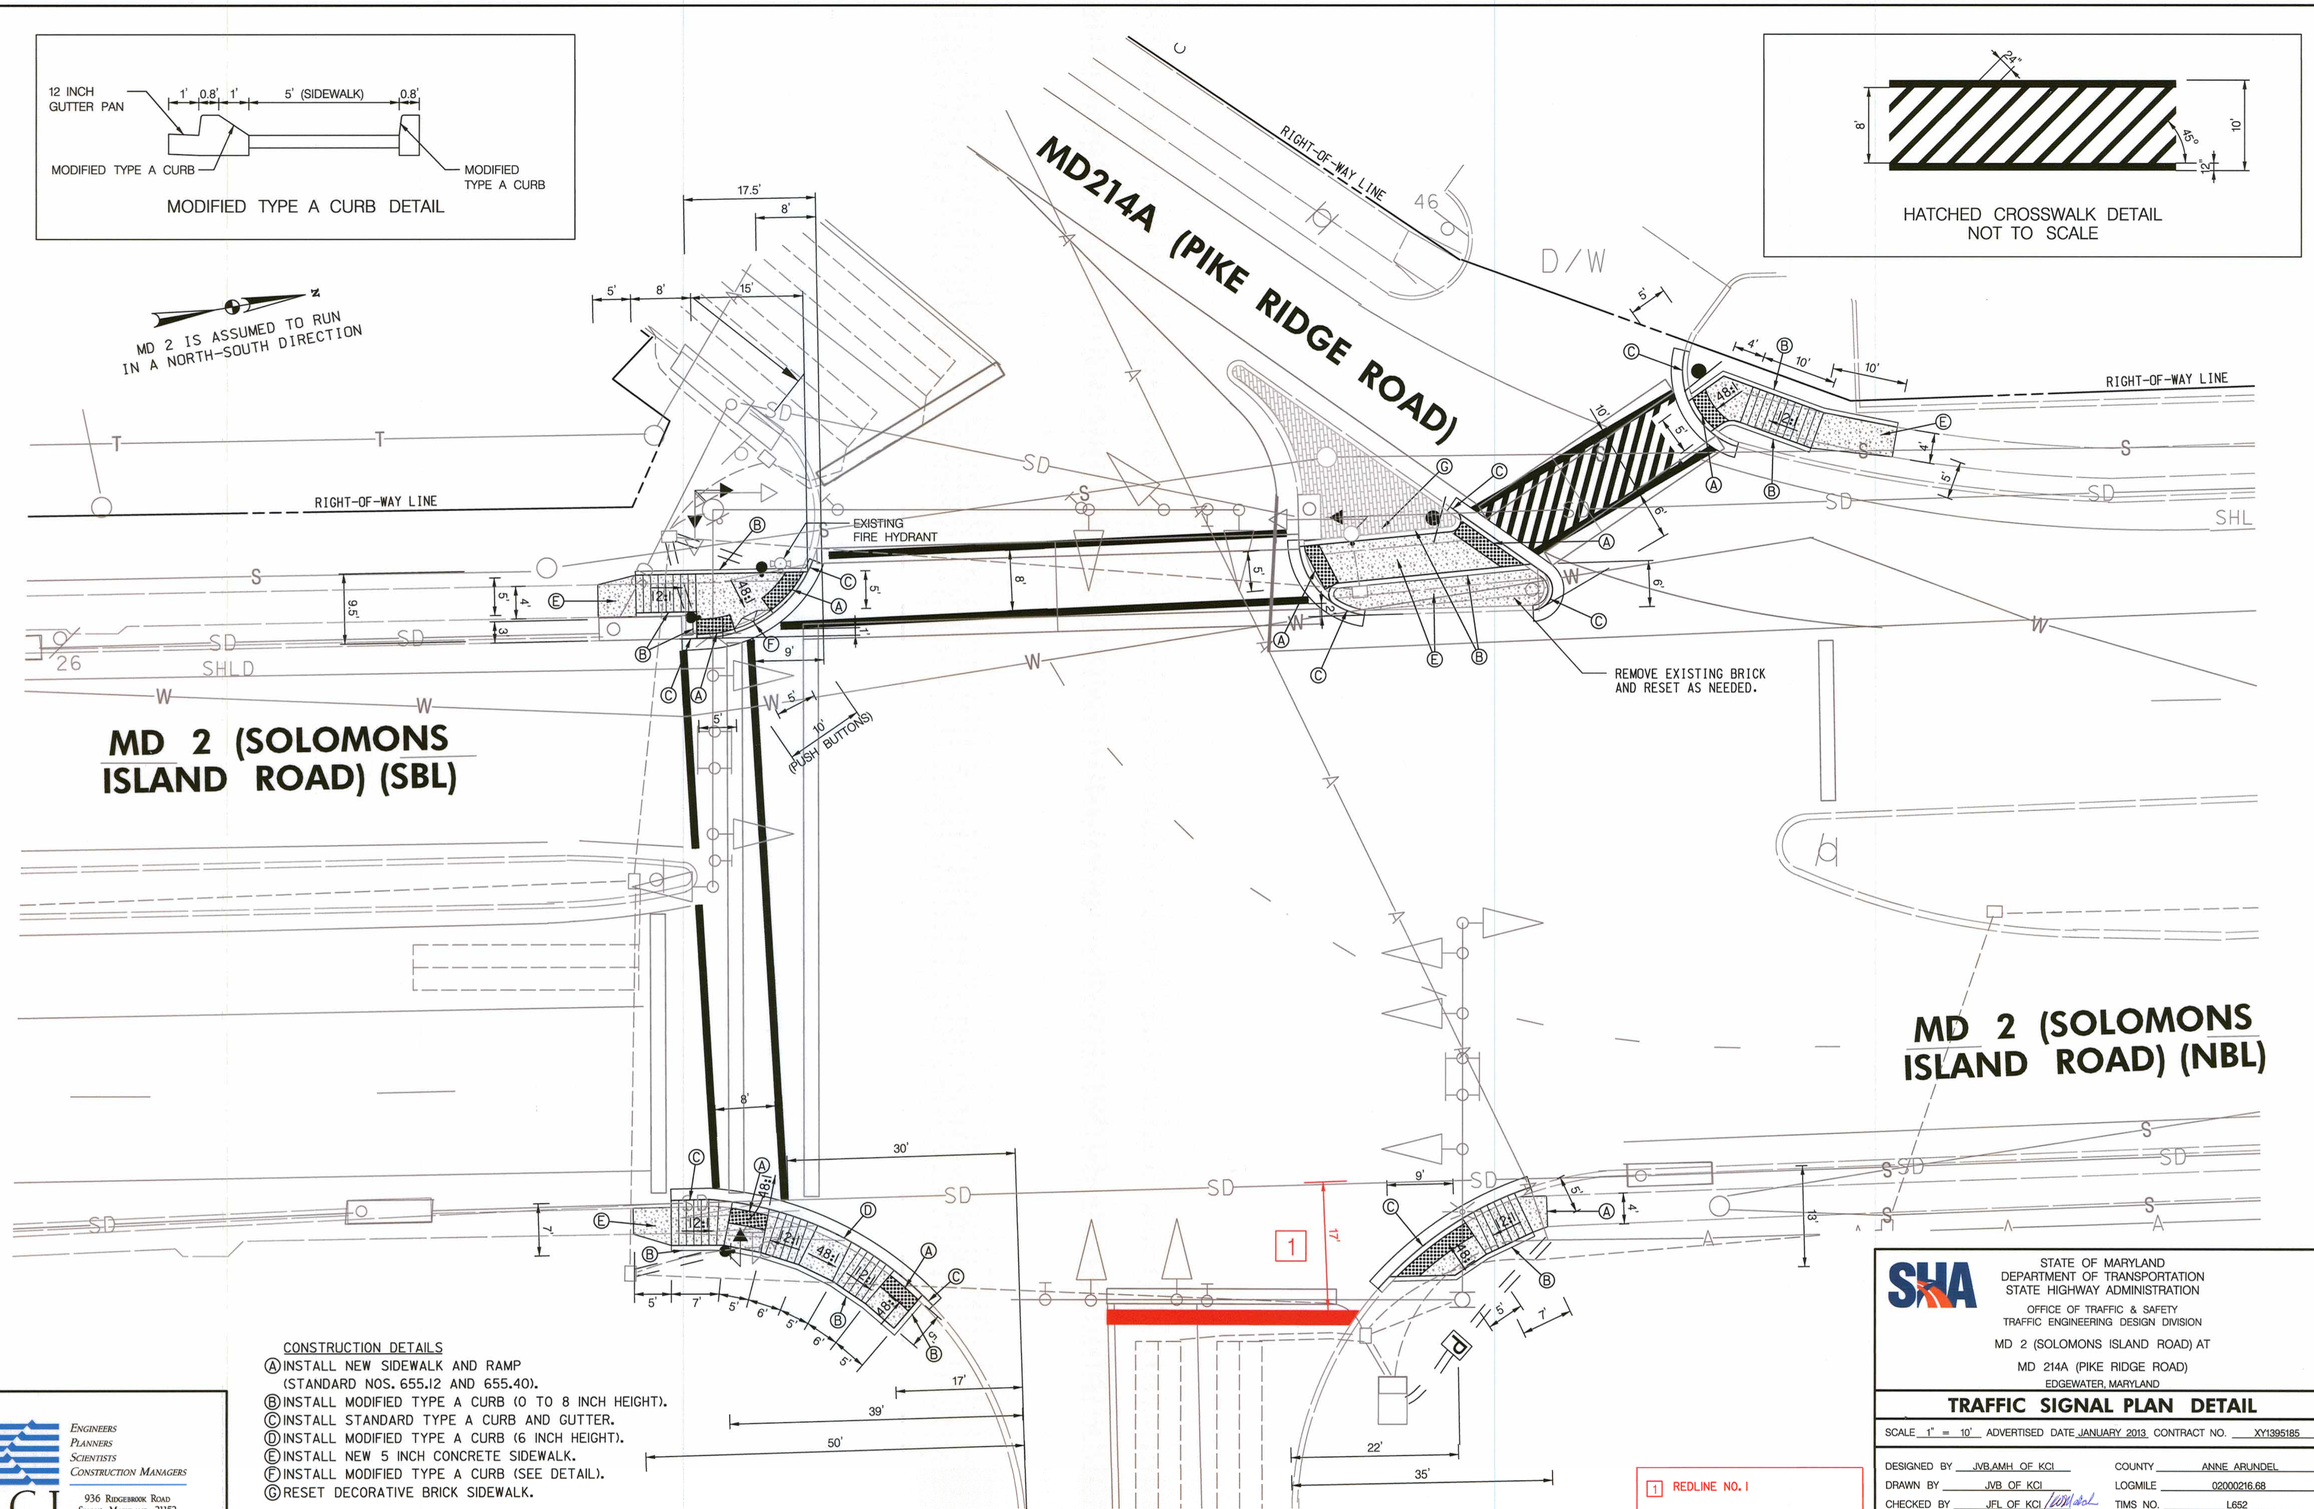

CONSTRUCTION DETAILS

Ⓐ INSTALL NEW SIDEWALK AND RAMP (STANDARD NOS. 655.12 AND 655.40).
Ⓑ INSTALL MODIFIED TYPE A CURB (0 TO 8 INCH HEIGHT).
Ⓒ INSTALL STANDARD TYPE A CURB AND GUTTER.
Ⓓ INSTALL MODIFIED TYPE A CURB (6 INCH HEIGHT).
Ⓔ INSTALL NEW 5 INCH CONCRETE SIDEWALK.
Ⓕ INSTALL MODIFIED TYPE A CURB (SEE DETAIL).
Ⓖ RESET DECORATIVE BRICK SIDEWALK.

KCI TECHNOLOGIES
ENGINEERS
PLANNERS
SCIENTISTS
CONSTRUCTION MANAGERS
936 RIDGEBROOK ROAD
SPARKS, MARYLAND 21152
TELEPHONE: (410) 316-7800
FAX: (410) 316-7818

1 REDLINE NO. 1

NAME DATE 6-13-13

STATE OF MARYLAND
DEPARTMENT OF TRANSPORTATION
STATE HIGHWAY ADMINISTRATION

OFFICE OF TRAFFIC & SAFETY
TRAFFIC ENGINEERING DESIGN DIVISION

MD 2 (SOLOMONS ISLAND ROAD) AT
MD 214A (PIKE RIDGE ROAD)
EDGEWATER, MARYLAND

TRAFFIC SIGNAL PLAN DETAIL

SCALE 1" = 10' ADVERTISED DATE JANUARY 2013 CONTRACT NO. XY1395185

DESIGNED BY	JVB,AMH OF KCI	COUNTY	ANNE ARUNDEL
DRAWN BY	JVB OF KCI	LOGMILE	02000216.68
CHECKED BY	JFL OF KCI	TIMS NO.	L652
F.A.P. NO.		TOD NO.	

TS NO. 3890-B | DRAWING SG-2 OF 3 | SHEET NO. 2 OF 21

PLOTTED: "10:53 AM on Thursday, May 30, 2013"
FILE: M:\2009\01090619.81\drawings\pSG-P001_MD2Detail.dgn

BY: Aaron Hottenstein Division: P068 Highway Traff GMA Emp

BORDER REV1 DATE: March12720807

DRILL HOLES